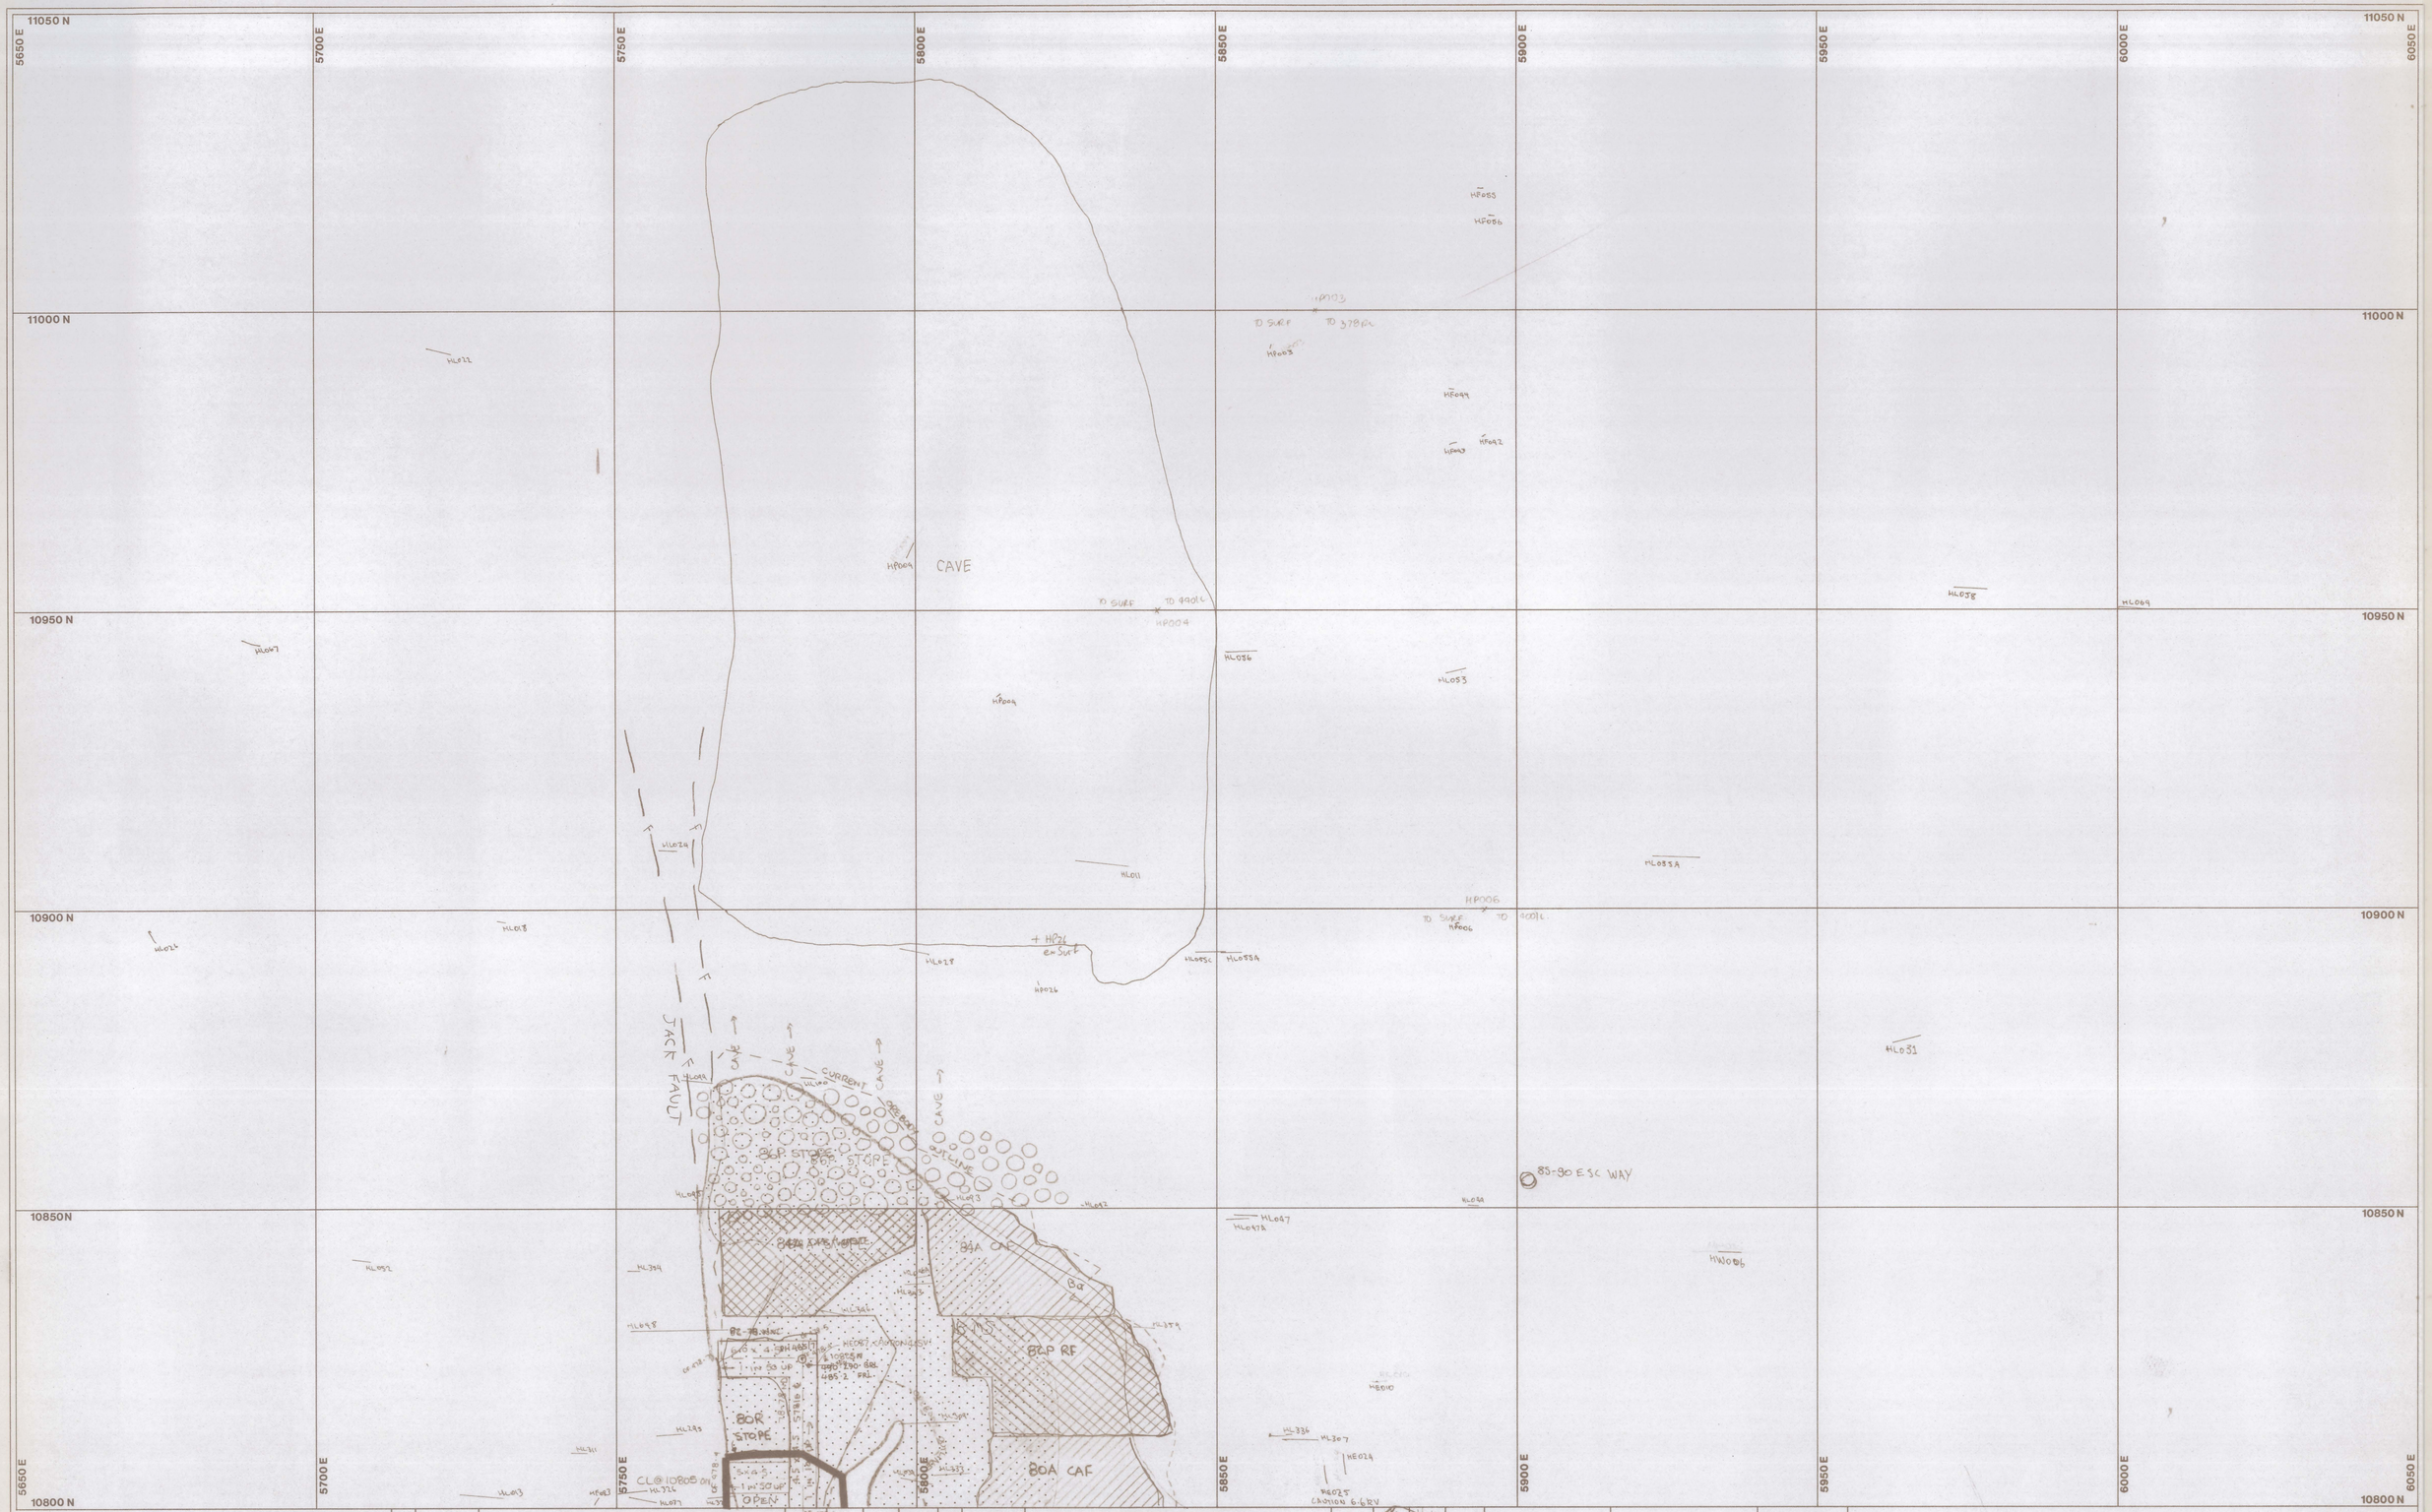

REV	DATE	REVISION	DRAWN	CKD	APP	DIGIT DATE
1	23/9/91	HP003, HP004 & HP006 ADDED	AJW			
2	27/8/93	[illegible]	[illegible]			
3	26/8/93	Added HP26	GGM	RWN		7993
4	10.12.98	ADDED BOA, BOP, BLP, BOR STOPES, CURRENT ORE BODY OUTLINE, 78-78 WKC, 82-78 WKC BOR 485L	RWN	TLM		11/2/99
5	30.7.99	ADDED 80-78 WKC 80R	RW	TLM		2/8/99

NORTH

SCALE 1:500	Sheet No. 1105-605
DRAWN	
CHECKED	
DESIGNED	
DESIGN CKD	
DESIGN APP	
PROJECT APP	

Aberfoyle Resources Limited
HELLYER DIVISION

DEVELOPMENT DESIGN

485 LEVEL – 1

DRAWING NO.

5 cm

0406 – 745