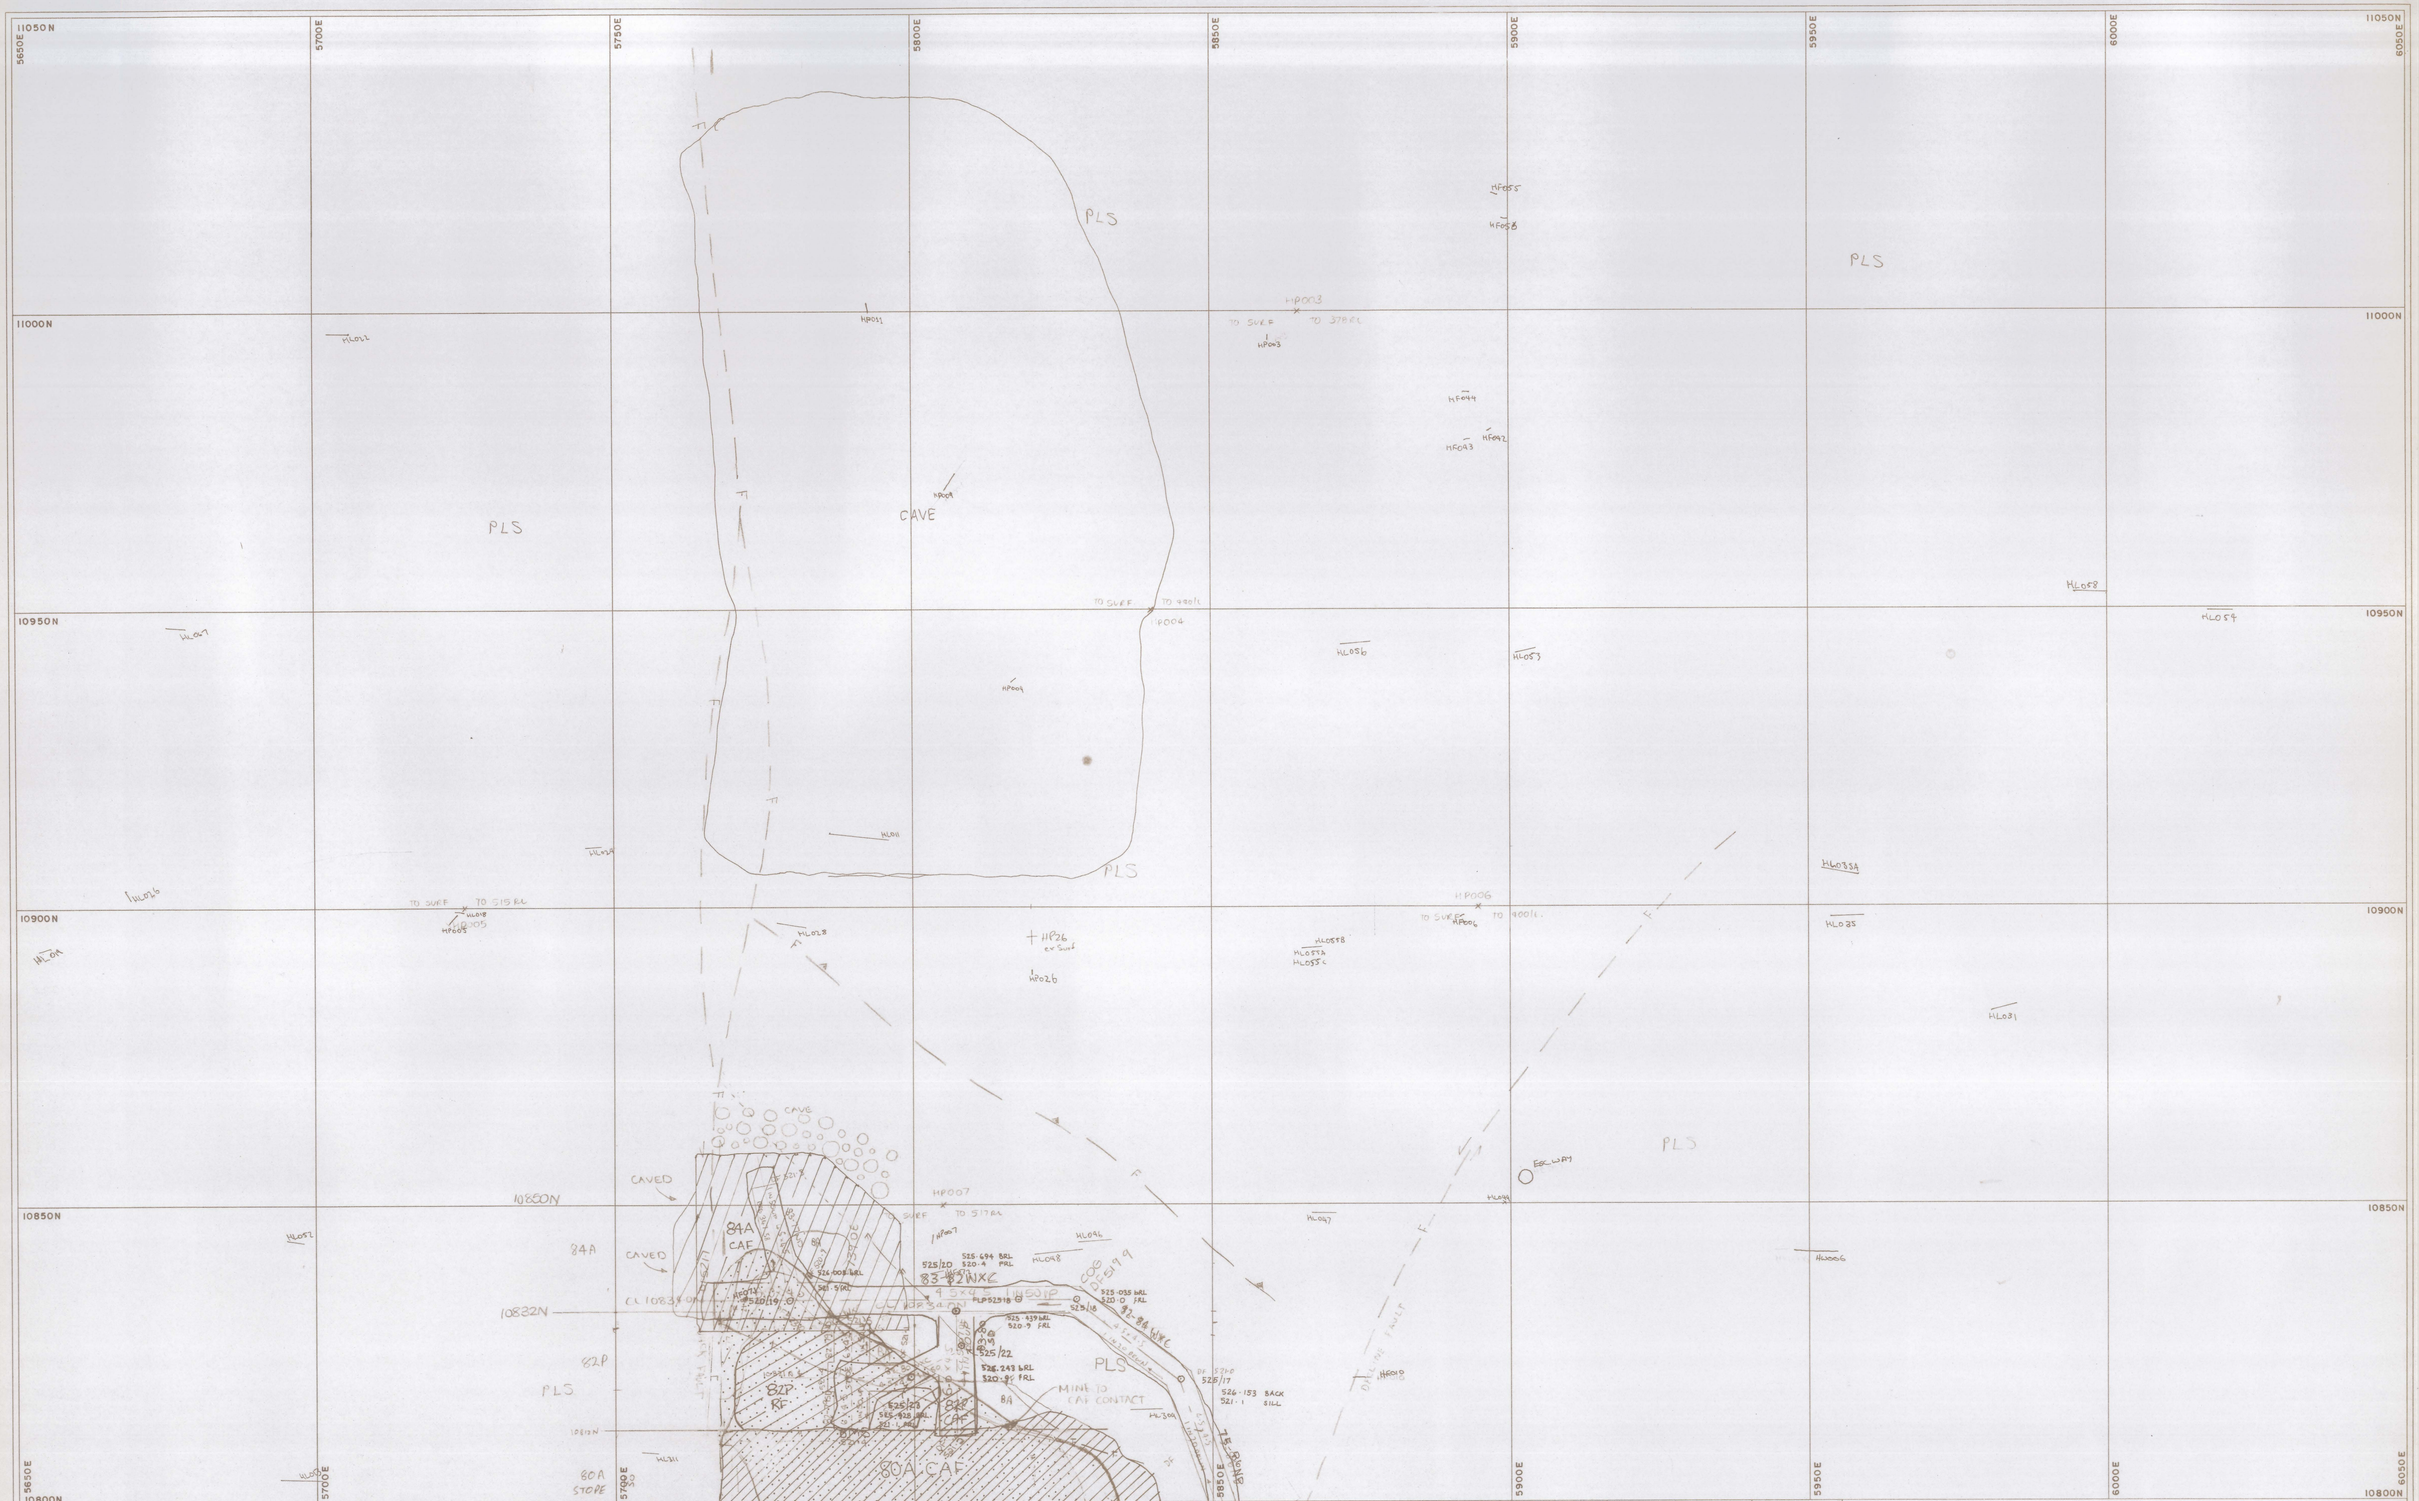

REV	DATE	REVISION	DRAWN	CKD	APP	DIGIT DATE
8	27·3·97	ADJUST DRN OF 83-77ND 525L TO 826' 347° 58'	JRS	TLM	RW	
9	11·11·97	ADD 81-84W, 81-77N, 81-77S, 82P	TLM		RW	27·11·97
10	28·11·97	REMOVED 81-84W, ADDED 83-77WXC TO 826' 245° 45'	KDP	TLM	RW	02·12·97
11	29·1·98	ADD 83-80SD	TLM	TLM	RW	30·01·98
12	20·3·98	WIDEN 83-80 SD TO 6.0m	RW	TLM		
13	04·06·98	RE-DESIGN 82-80WXC, 82-77ND, SD 82P	RW	KDP	RW	06·06·98
14	14.07.98	RE-DESIGN 82-80WXC, 82-77ND SD 82P	RW	TLM	RW	20·7·98

REV	DATE	REVISION	DRAWN	CKD	APP	DIGIT DATE
1	30/5/91	GEOLOGY + MIN. SHAPING ON 400L	RCD			
2	23/5/91	HP003, HP004, HP005, HP006, & HP007 ADDED	NJW			
3	14/4/92	GEOLOGY UPDATED	RCD			
4	30/5/93	Added HP26	CGM	RW		8/7/93
5	12/7/95	ADDED 79.55 EXC FOR SUBSTITUTION	JMH			
6	30/7/96	ADD 75-SEND, 82-84WXC, 83-77ND REMOVE 79-85EXC	WJB	TLM		5/8.
7	14/8/96	MOVE 84A DEVT 1·0m SOUTH &	TLM	DJA		

NORTH

SCALE	1 : 500
SHEET No.	1105-605
DRAWN	
CHECKED	
DESIGNED	
DESIGN CKD	
DESIGN APP	
PROJECT APP	

Aberfoyle Resources Limited
HELLYER DIVISION

DEVELOPMENT DESIGN

525 LEVEL — 1

DRAWING No.

5 cm

0406 - 254