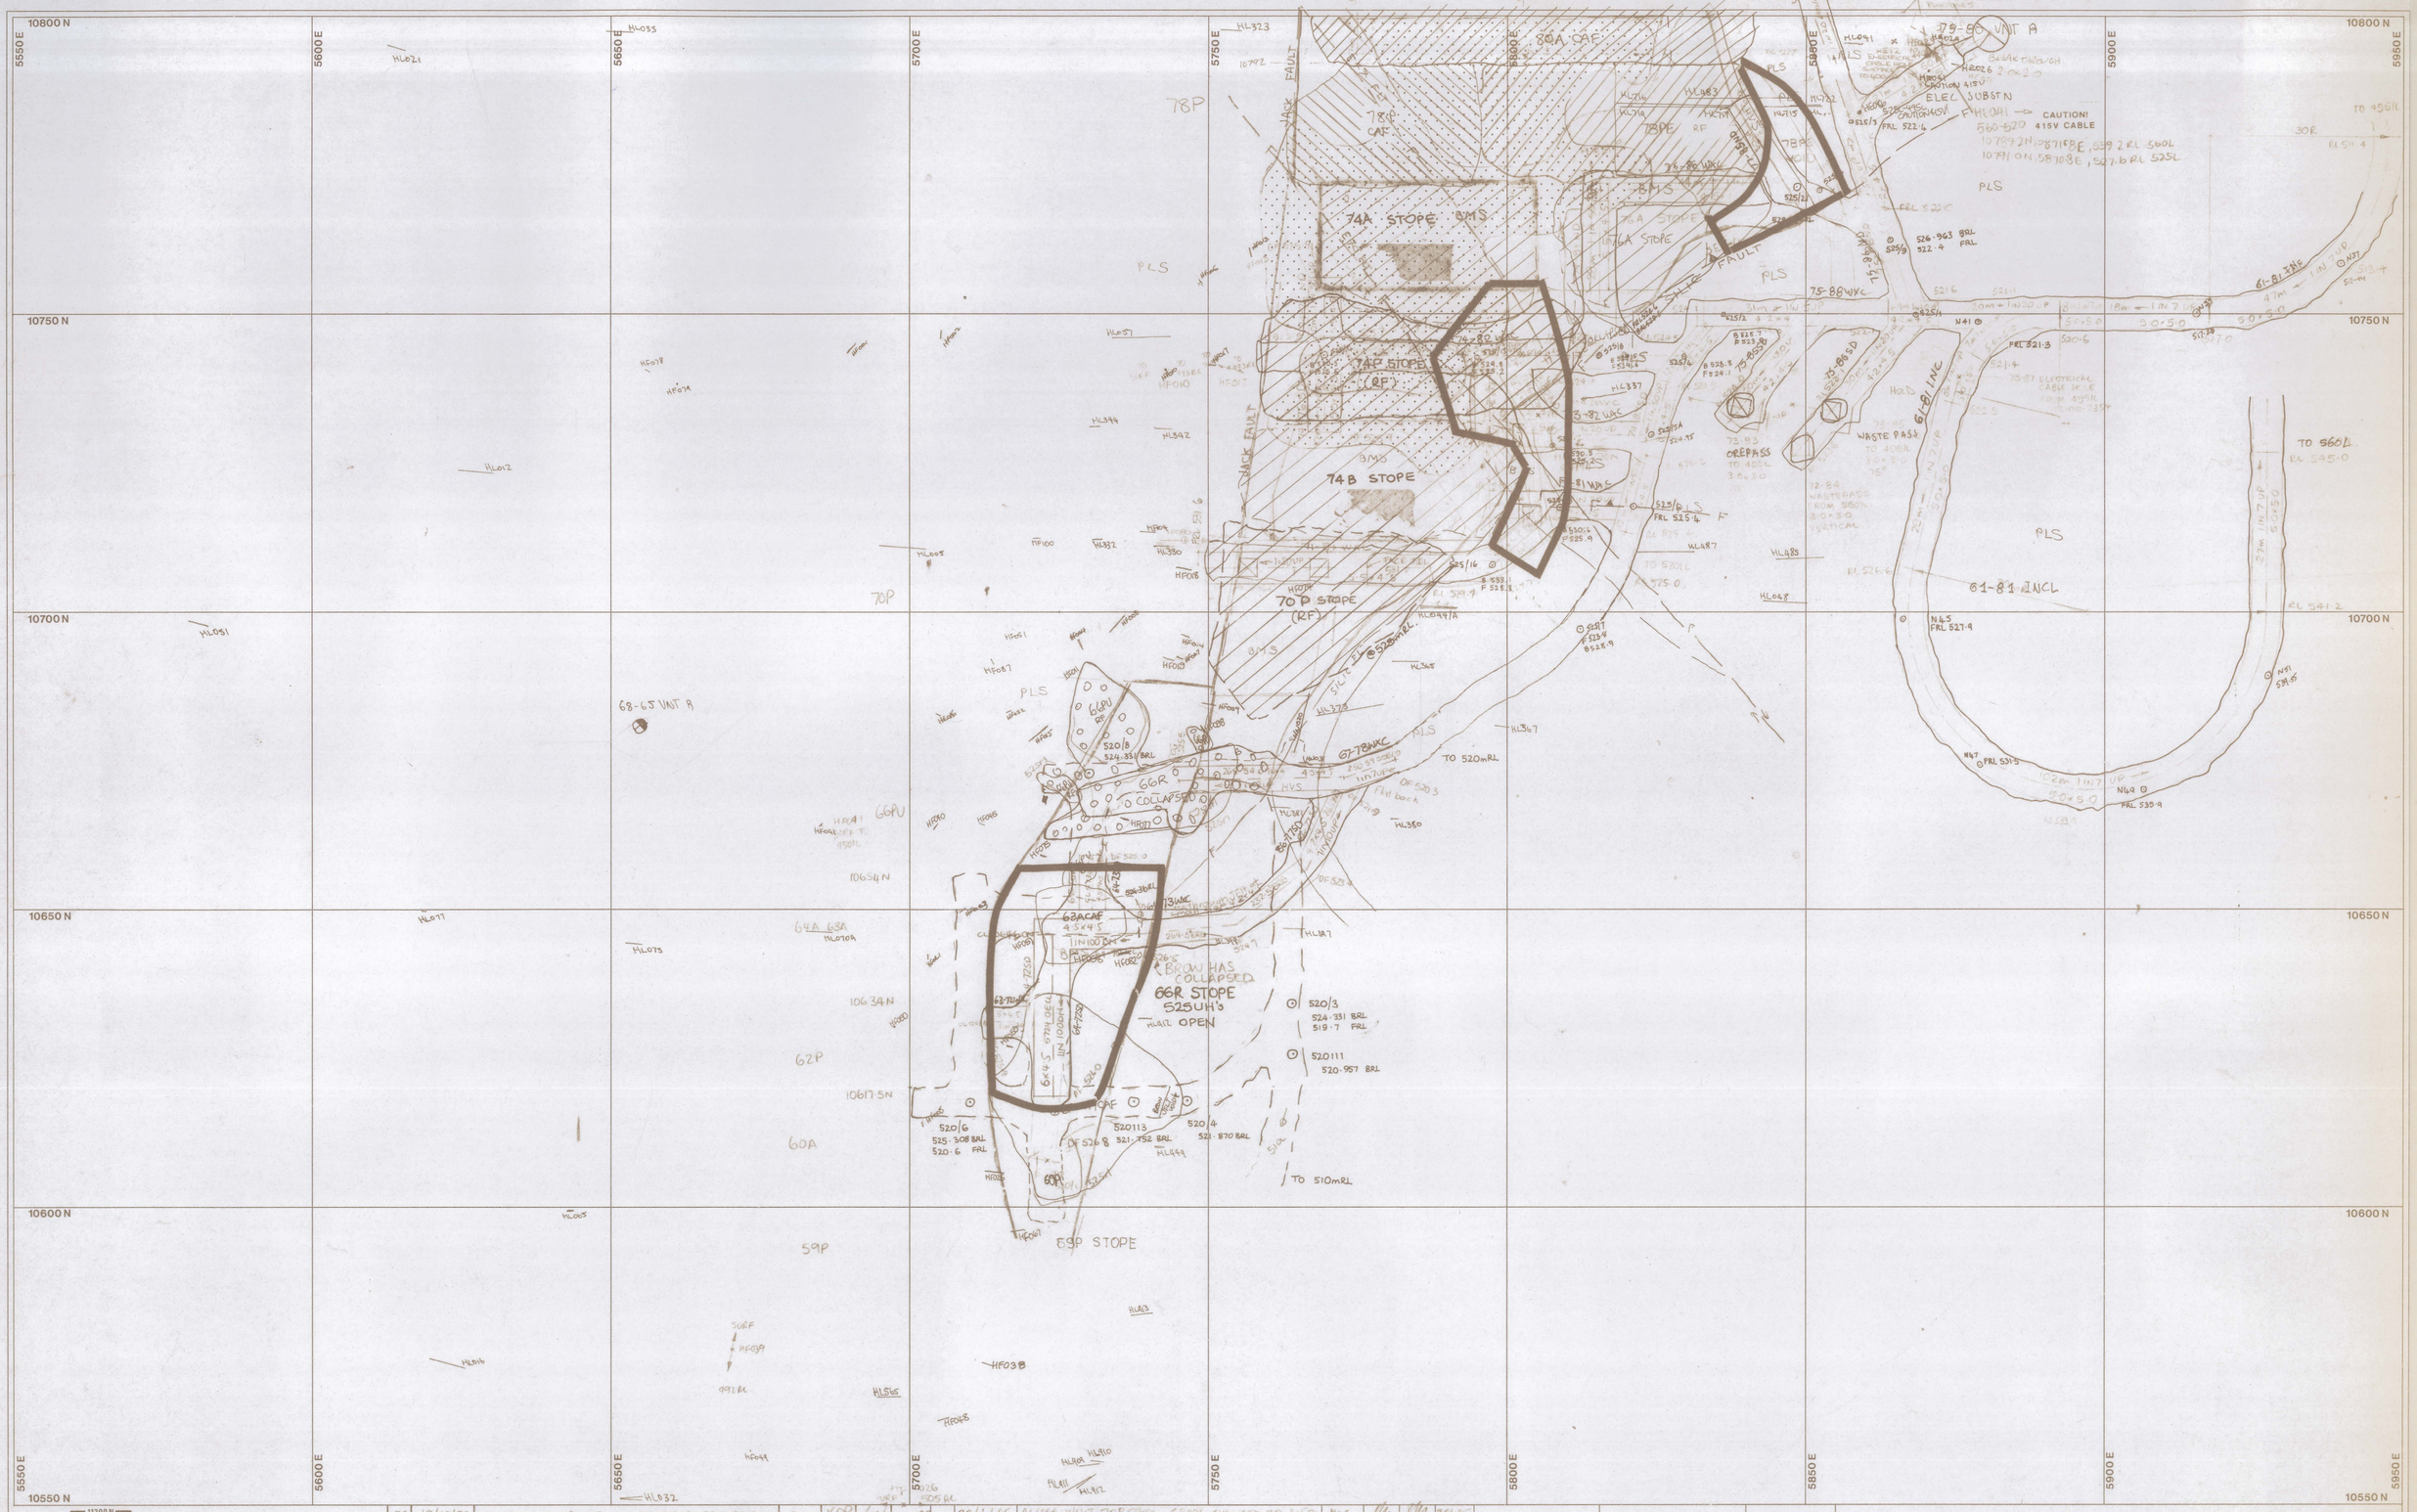

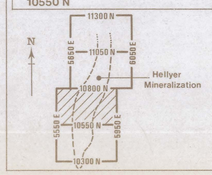

REV	DATE	REVISION	DRAWN	CKD	APP	DIGIT DATE
34	18/10/99	DELETE OLD 66R DEVT, ADD 64-72SD, 64-73W, 66-77SD	TLM	KOP		18/10/99
35	11/1/00	ADD 68-72WXC, 64-73ND 66R	TLM	JM		11/01/00
24	11/3/94	74-76SD & 74-76ND ADDED	AJW			17/3/94
	2/9/92	Cape Zone Geology Updated	RWS			
25	6/9/94	73-80-ND ADDED	AJW			
26	20/3/94	20W GEOTECH HOLES 68-3, 4, 5, 6 FOR 74P monitoring	WTS			24/3/94
27	22/3/96	HF080 ADDED	JETH			

REV	DATE	REVISION	DRAWN	CKD	APP	DIGIT DATE
19	30/6/95	ALLOWS NEXT 74P STOPE - GRADE CHANGED TO 1:50	MC			30/6/95
28	17/1/95	70-81 WXC ADDED 3/3/95 CHANGED TO 71-80 WXC	AJW			3/3/95
20	5/7/93	PROBE HOLES ADDED 525L	AJW			5/7/93
30	30/7/96	CHANGE 75-80WD GRADE	WTS	TLM		5/8/96
31	26-3-98	ADD 78-85WXC (78P) 78-77WD/SD 78-80WD/SD 77-85WD	RWS	KOP		25/03/98
32	10.9.98	Remove 78-77SD, 78-80SD, 78-85 WXC 78P	RWS	TLM		15/10/98
33	14.4.99	ADD 67-78WXC + 68-73SD FOR 66R	TLM			14/04/99

NORTH

SCALE 1:500

Sheet No. 1080-595

DRAWN	AJW	22/12/00
CHECKED		
DESIGNED		
DESIGN CKD		
DESIGN APP		
PROJECT APP		

Aberfoyle Resources Limited
HELLYER DIVISION

DEVELOPMENT DESIGN

525 LEVEL – 2

DRAWING NO.

5 cm

0406 – 255