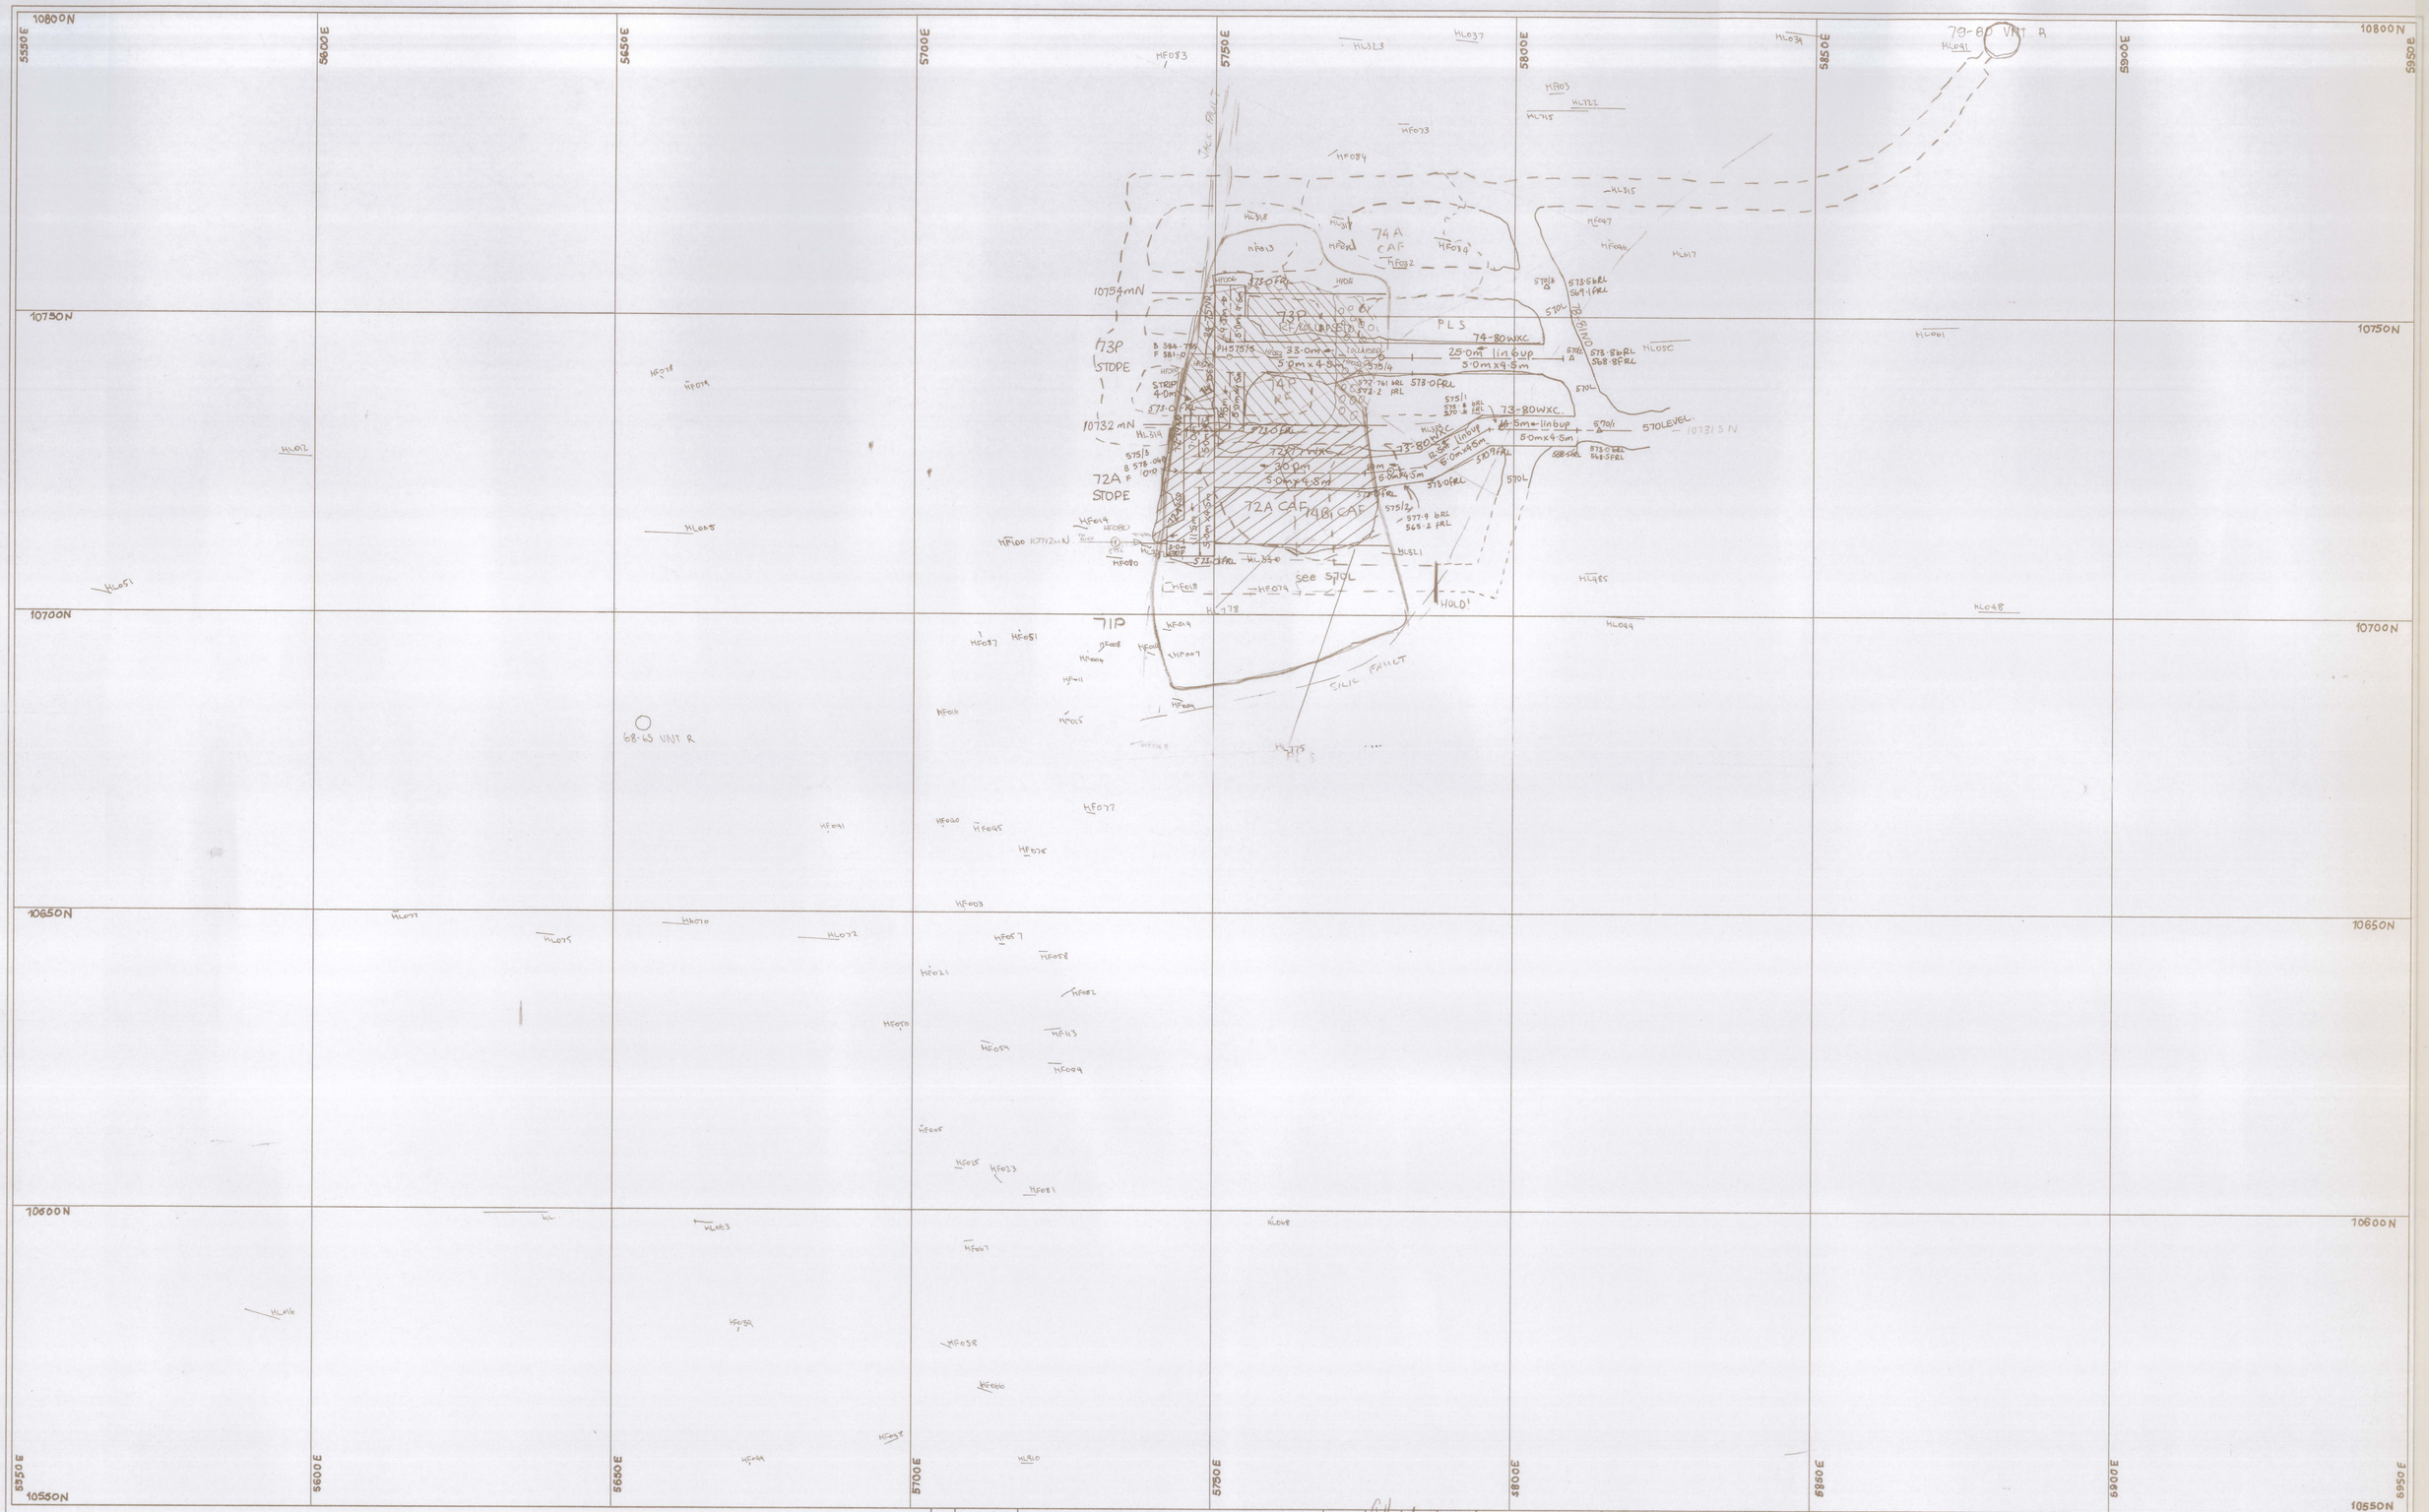

REV	DATE	REVISION	DRAWN	CKD	APP	APP
1	16/2/96	DASHED LINES 570L, and STOPES FILLED	TLM			
2	20/2/96	GEOLOGY ADDED @ 575mRL	AHM			
3	22/3/96	HF080 ADDED	JRG	DJA		
4	24/06/96	Sulphide Dust Stopping (Mark	SH	RDH		

NORTH

SCALE 1:500	SHEET No. 1080-595	
DRAWN	TLM	16/2/96
CHECKED		
DESIGNED		
DESIGN CKD		
DESIGN APP		
PROJECT APP		

Aberfoyle Resources Limited
HELLYER DIVISION

PROJECT

DEVELOPMENT DESIGN

DRAWING No.

575 LEVEL

5 cm

406-360