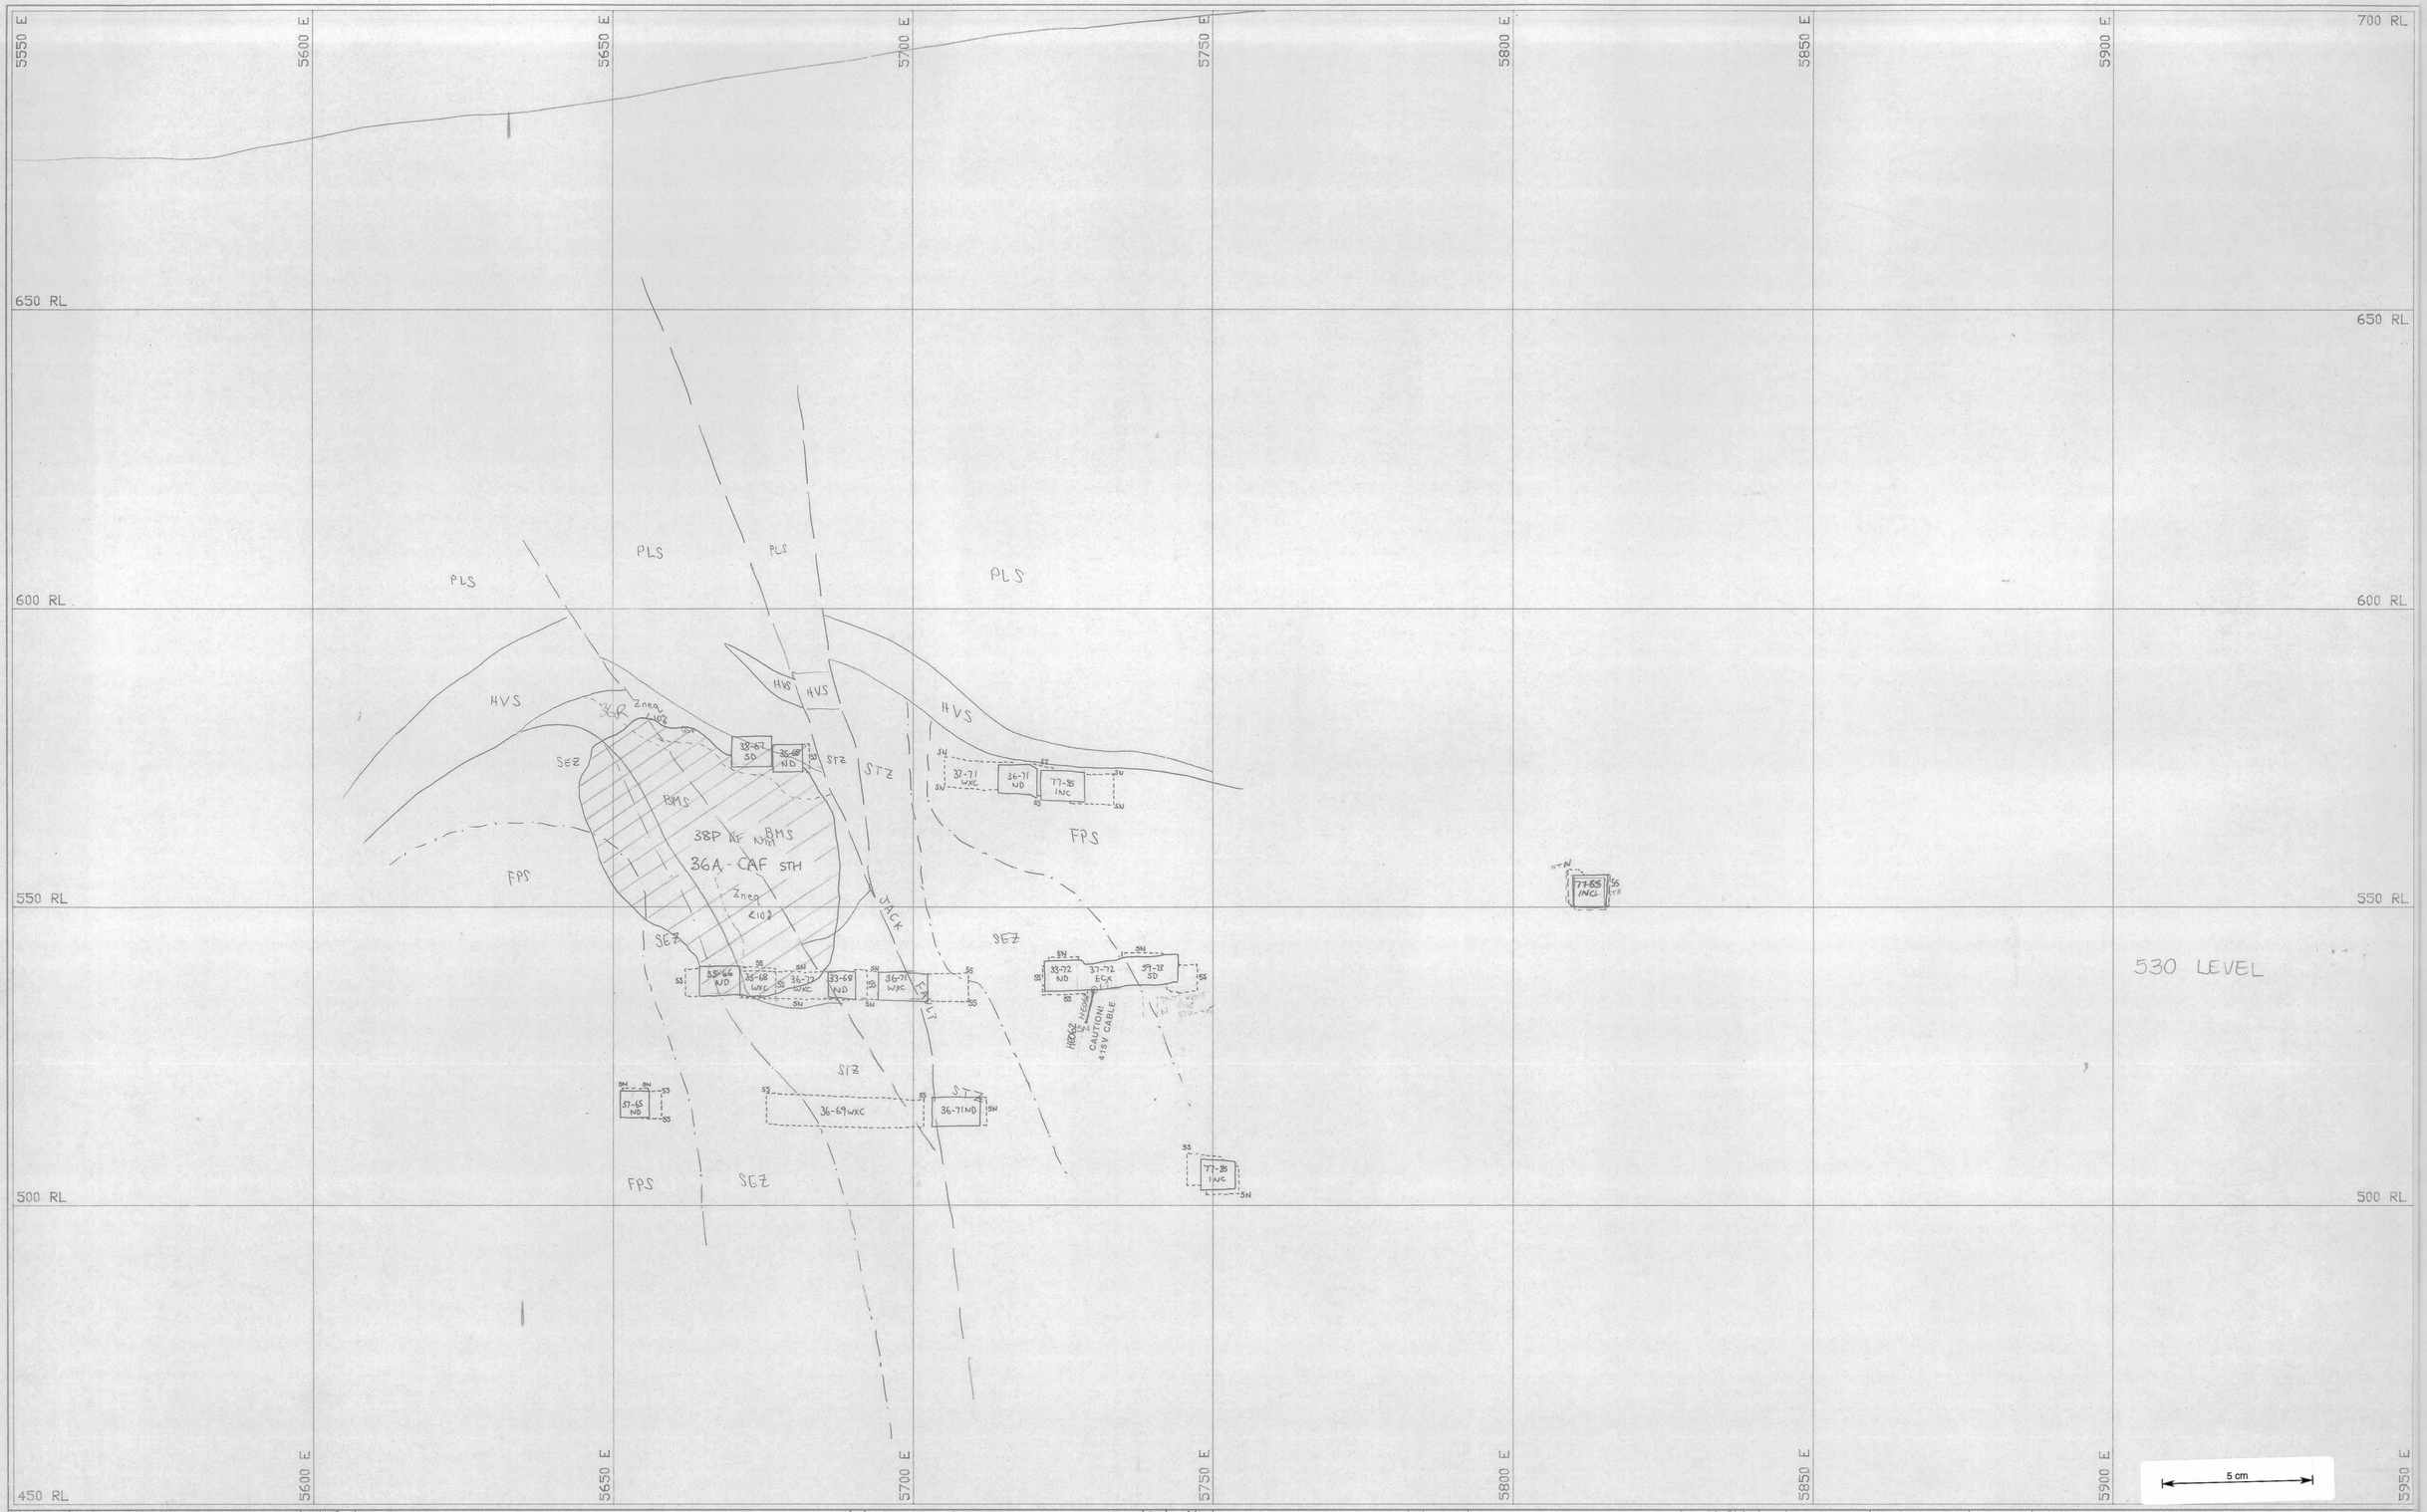

REV	DATE	REVISION	DR	CKD	APP
9	14-8-95	MODIFIED 36A DEVELOPMENT 35-66ND 8P	JMH		
10	12-9-95	ADD 35-68 ND 580L	JMH		
11	13-9-95	ADD 35-68 ND 530L	JMH		
14	23-5-96	REMOVED 36-70 ND 580L	JMH		
15	23-5-96	ADD 36-71ND, 37-71INC 580L	JMH		
16	1-8-97	ADD 35-67 SD 580L, 36-71INC 580L	JES		

REV	DATE	REVISION	DR	CKD	APP
12	8-3-96	ADD 35-70ND 580L 40A STOPE	TJM		
13	25-3-96	UPDATED 415V CABLE HE062	TJM		

REV	DATE	REVISION	DRAWN	CKD	APP	APP
8	17-5-95	35-66ND REPLACES 36-66ND	NAS			
2	2-.92	→ updated + 2-eg c/ws	HBK			
3	18-7-89	77-85INC; 516L; 530L; 37-73 RISE	RR			
4	1-12-89	530 L/DRIVE + RISES				
5	14-2-90	37-73 VOID ELIM. NOTED	NAS			
6	23/6/90	37-85 INCLINE, 37-73 EXC				
7	15-5-95	77-85 INC 530L CHANGED	NAS			

NORTH

SCALE	1:500
DRAWN	
CHECKED	
DESIGNED	
DESIGN CKD	
DESIGN APP	
PROJECT APP	

Aberfoyle Resources Limited

HELLYER DIVISION

DEVELOPMENT DESIGN SECTION

10370 N

DRAWING No.

REVISION

NVR Jul '91 Aldisding Version

0406-270