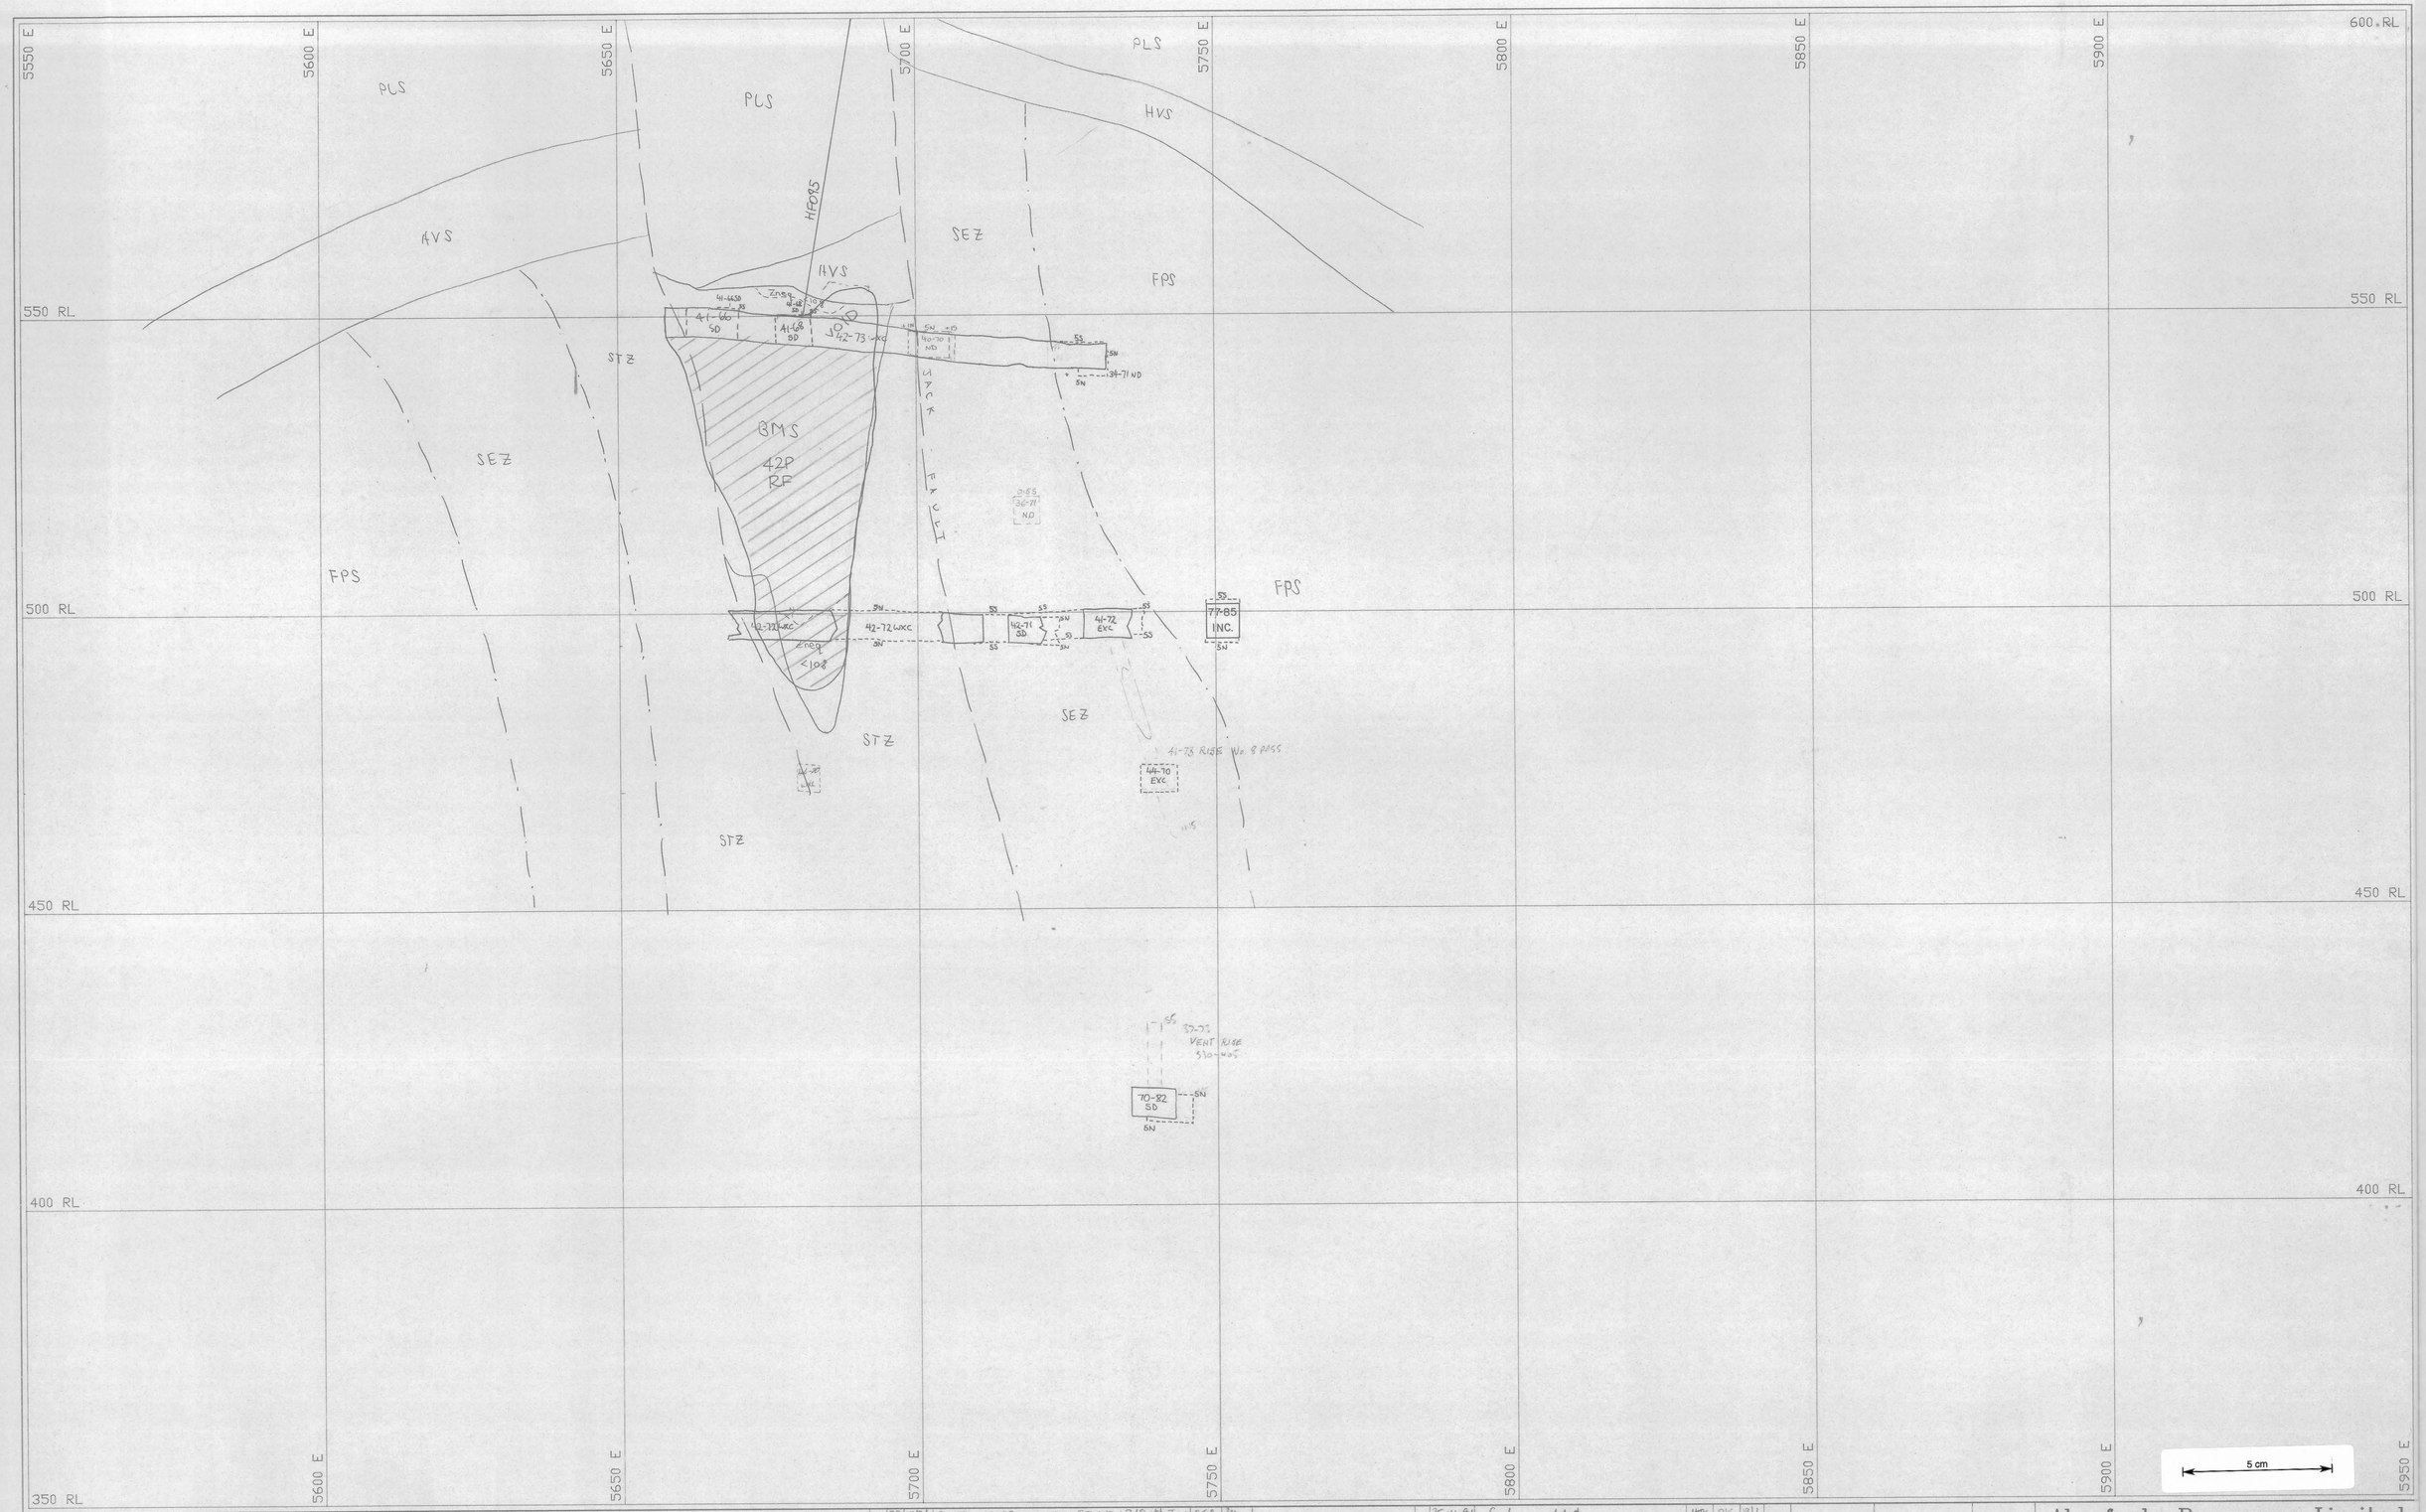

REV	DATE	REVISION	DRAWN	CKD	APP
	23/5/96	ALTER 42-78 WCC STOL, REMOVE 42-68 WCC	JRM	DJA	
	11-1-98	ADD 41-6650 AND 41-6820	DGH	KDP	
	5/2/00	ADDED 40-70 ND	KDD	DJA	
	2K-11-91	Geology added	HMK	DJK	9/2
	22-2-93	" updated + 2 sq cuts "			
	14-9-93	47DL, 47UL, 51SL, 53UL, 41-73, 39-72 RISES	KR		
	14-1-94	[illegible]	DM		
	5/7/94	DELETE 45-69 SD, ADD 43-6950 AND 40 RO EXC	WJS		
	5/7/94	ADD STOLL 43-6850 AND	WJS		
	3/4/96	EXTEND 42-72 WCC, 43-6850 42-72 WCC 1/2 STOL, 46-70 WCC 1/2 STOL	JMH	DJA	

NORTH

SCALE 1:500

DRAWN
CHECKED
DESIGNED
DESIGN CKD
DESIGN APP
PROJECT APP

Aberfoyle Resources Limited

HELLYER DIVISION

DEVELOPMENT DESIGN SECTION

10420 N

DRAWING No.

REVISION

NVR Jul '91 aldds.dwg Version

0470 - 275