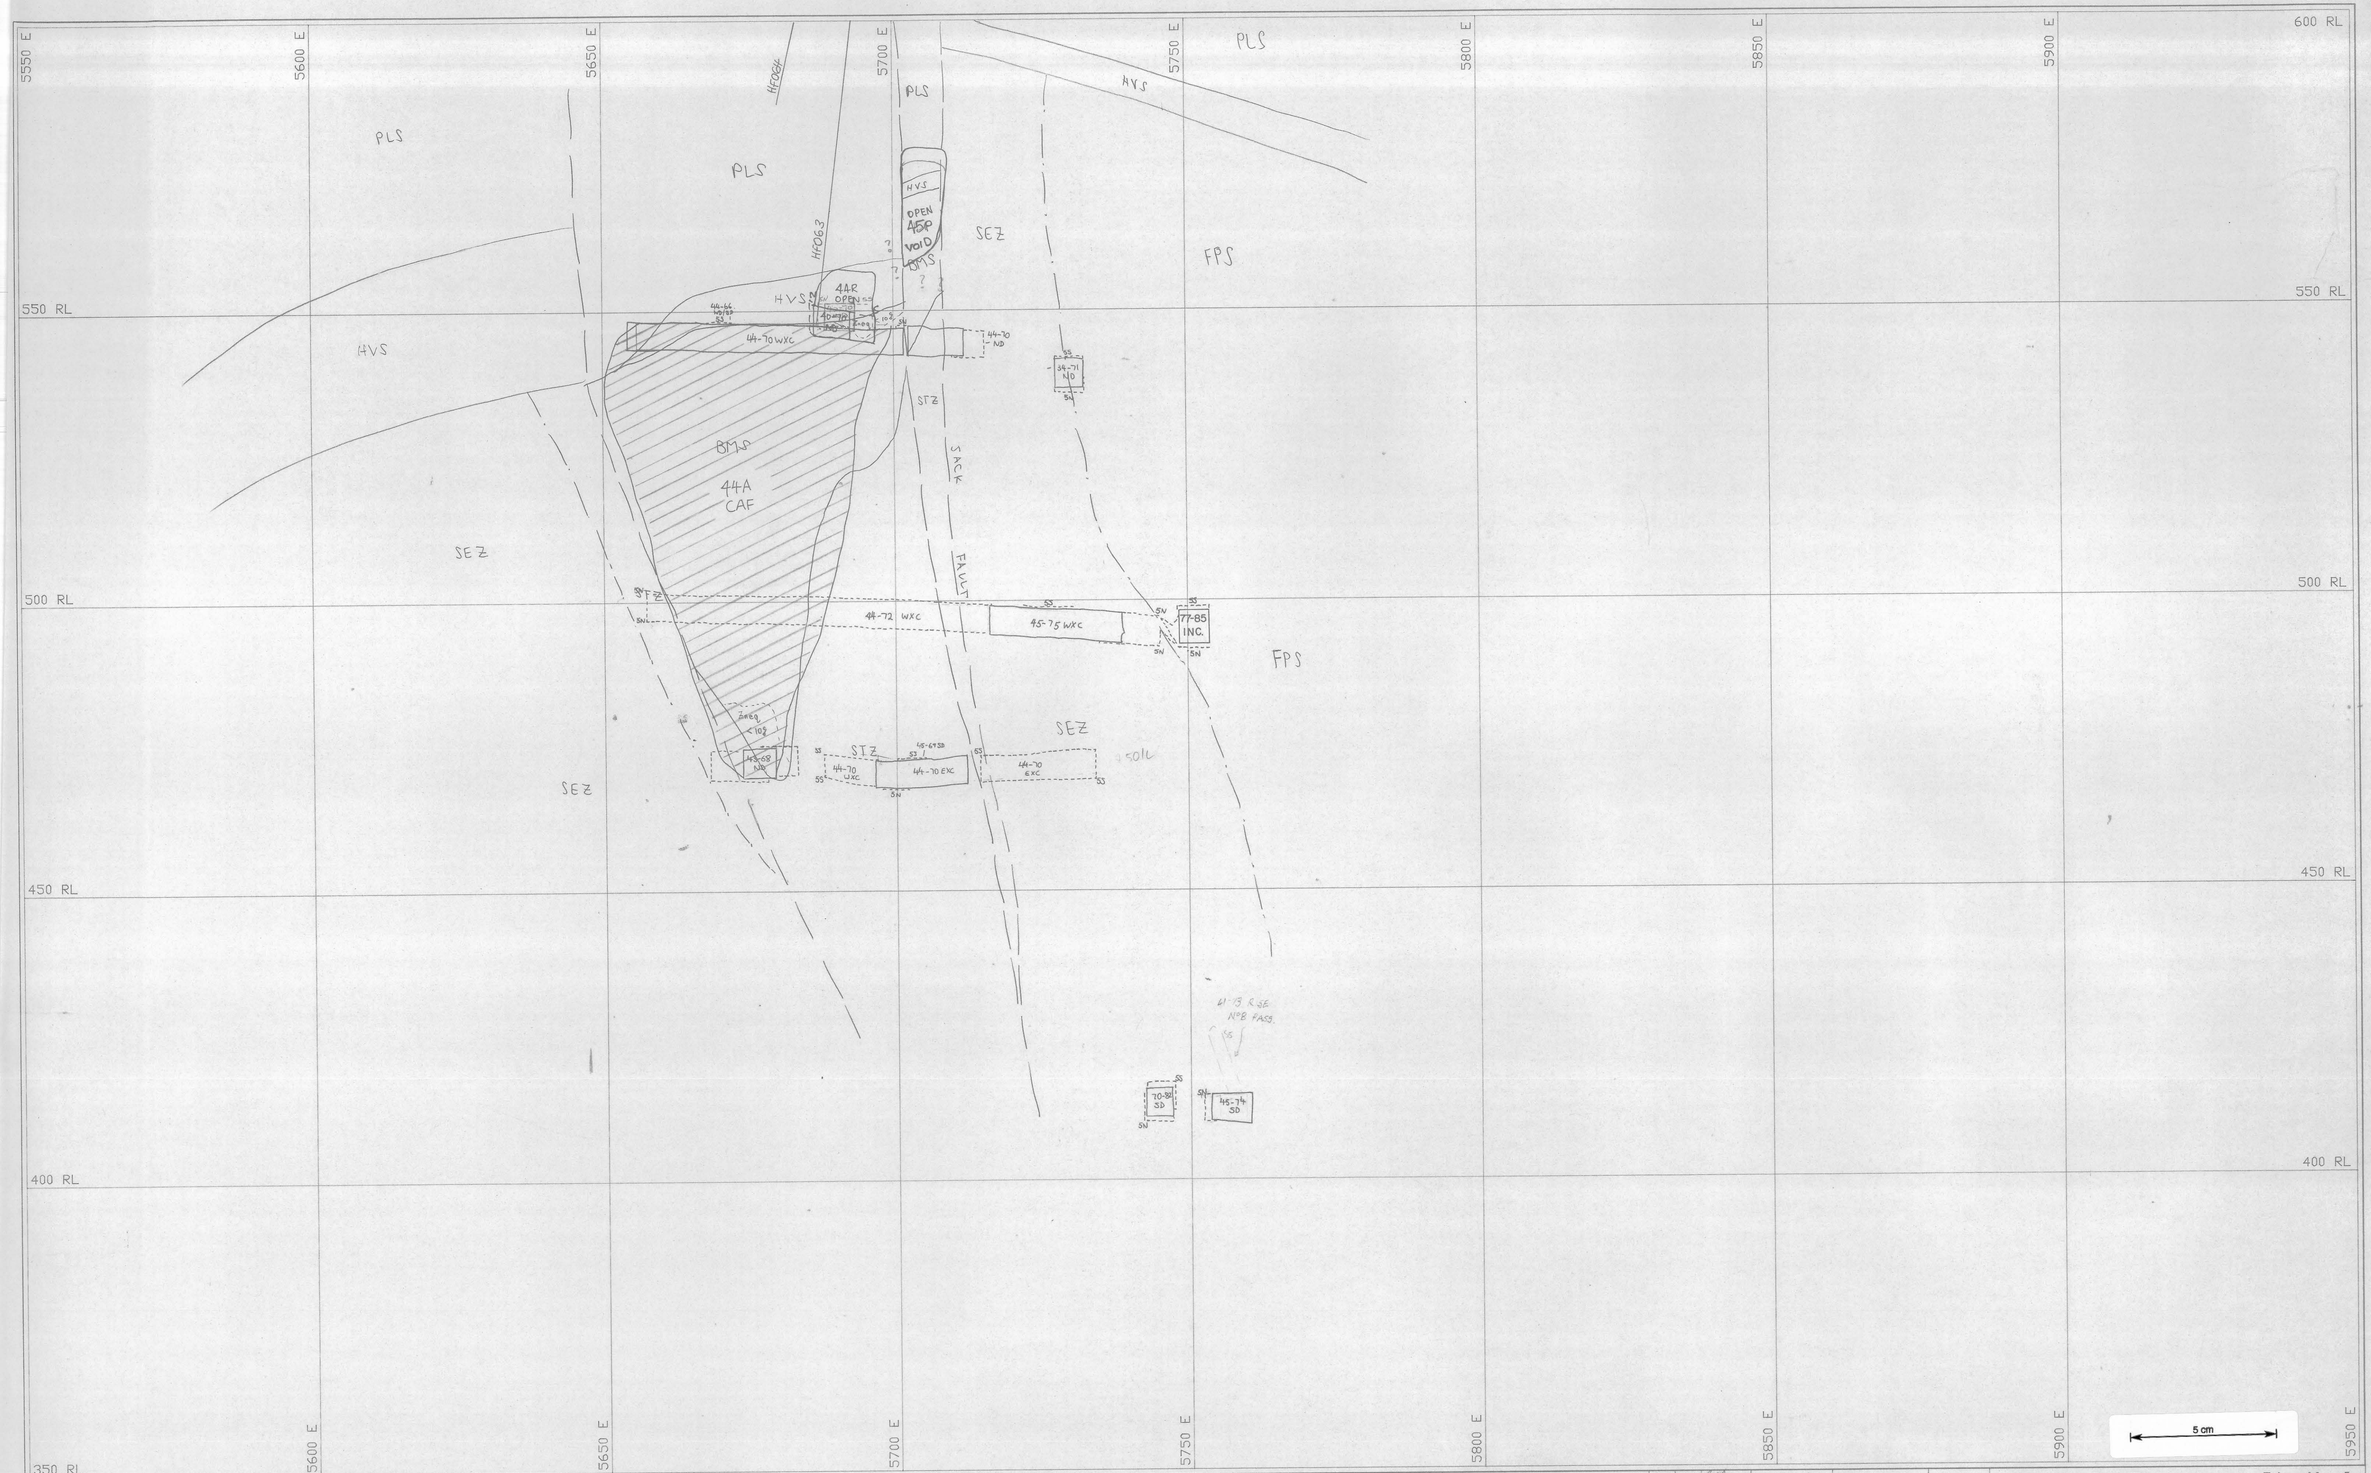

REV	DATE	REVISION	DRAWN	CKD	APP	APP
8	24/7/98	ADDED 44-70 ND	KDP	RW		
9	3/2/00	ADDED 40-70 ND 830L (4AR)	KDP	DJM		03/02/00
3	18-7-96	ADDED 77-85 INC.	RW			
4	14-3-94	ADDED 70-39 SD, 45-74 SD, 41-73 ADD ANNOTATION	DRS			
5	5/7/94	ADD 44-70 WXC, 44-70 EXC 450L	WTS			
6	5/7/94	REDRAW 43-69 ND 450L	WTS			
7	5/7/94	830L REDRAW 44-70 WXC ADD 44-66 44-69 44-70 ND	WTS			

NORTH

SCALE	1:500
DRAWN	
CHECKED	
DESIGNED	
DESIGN CKD	
DESIGN APP	
PROJECT APP	

Aberfoyle Resources Limited
HELLYER DIVISION
DEVELOPMENT DESIGN SECTION
10440 N

DRAWING No.
REVISION

M/R Jul '91 Microdraw Version 1

0406 - 277