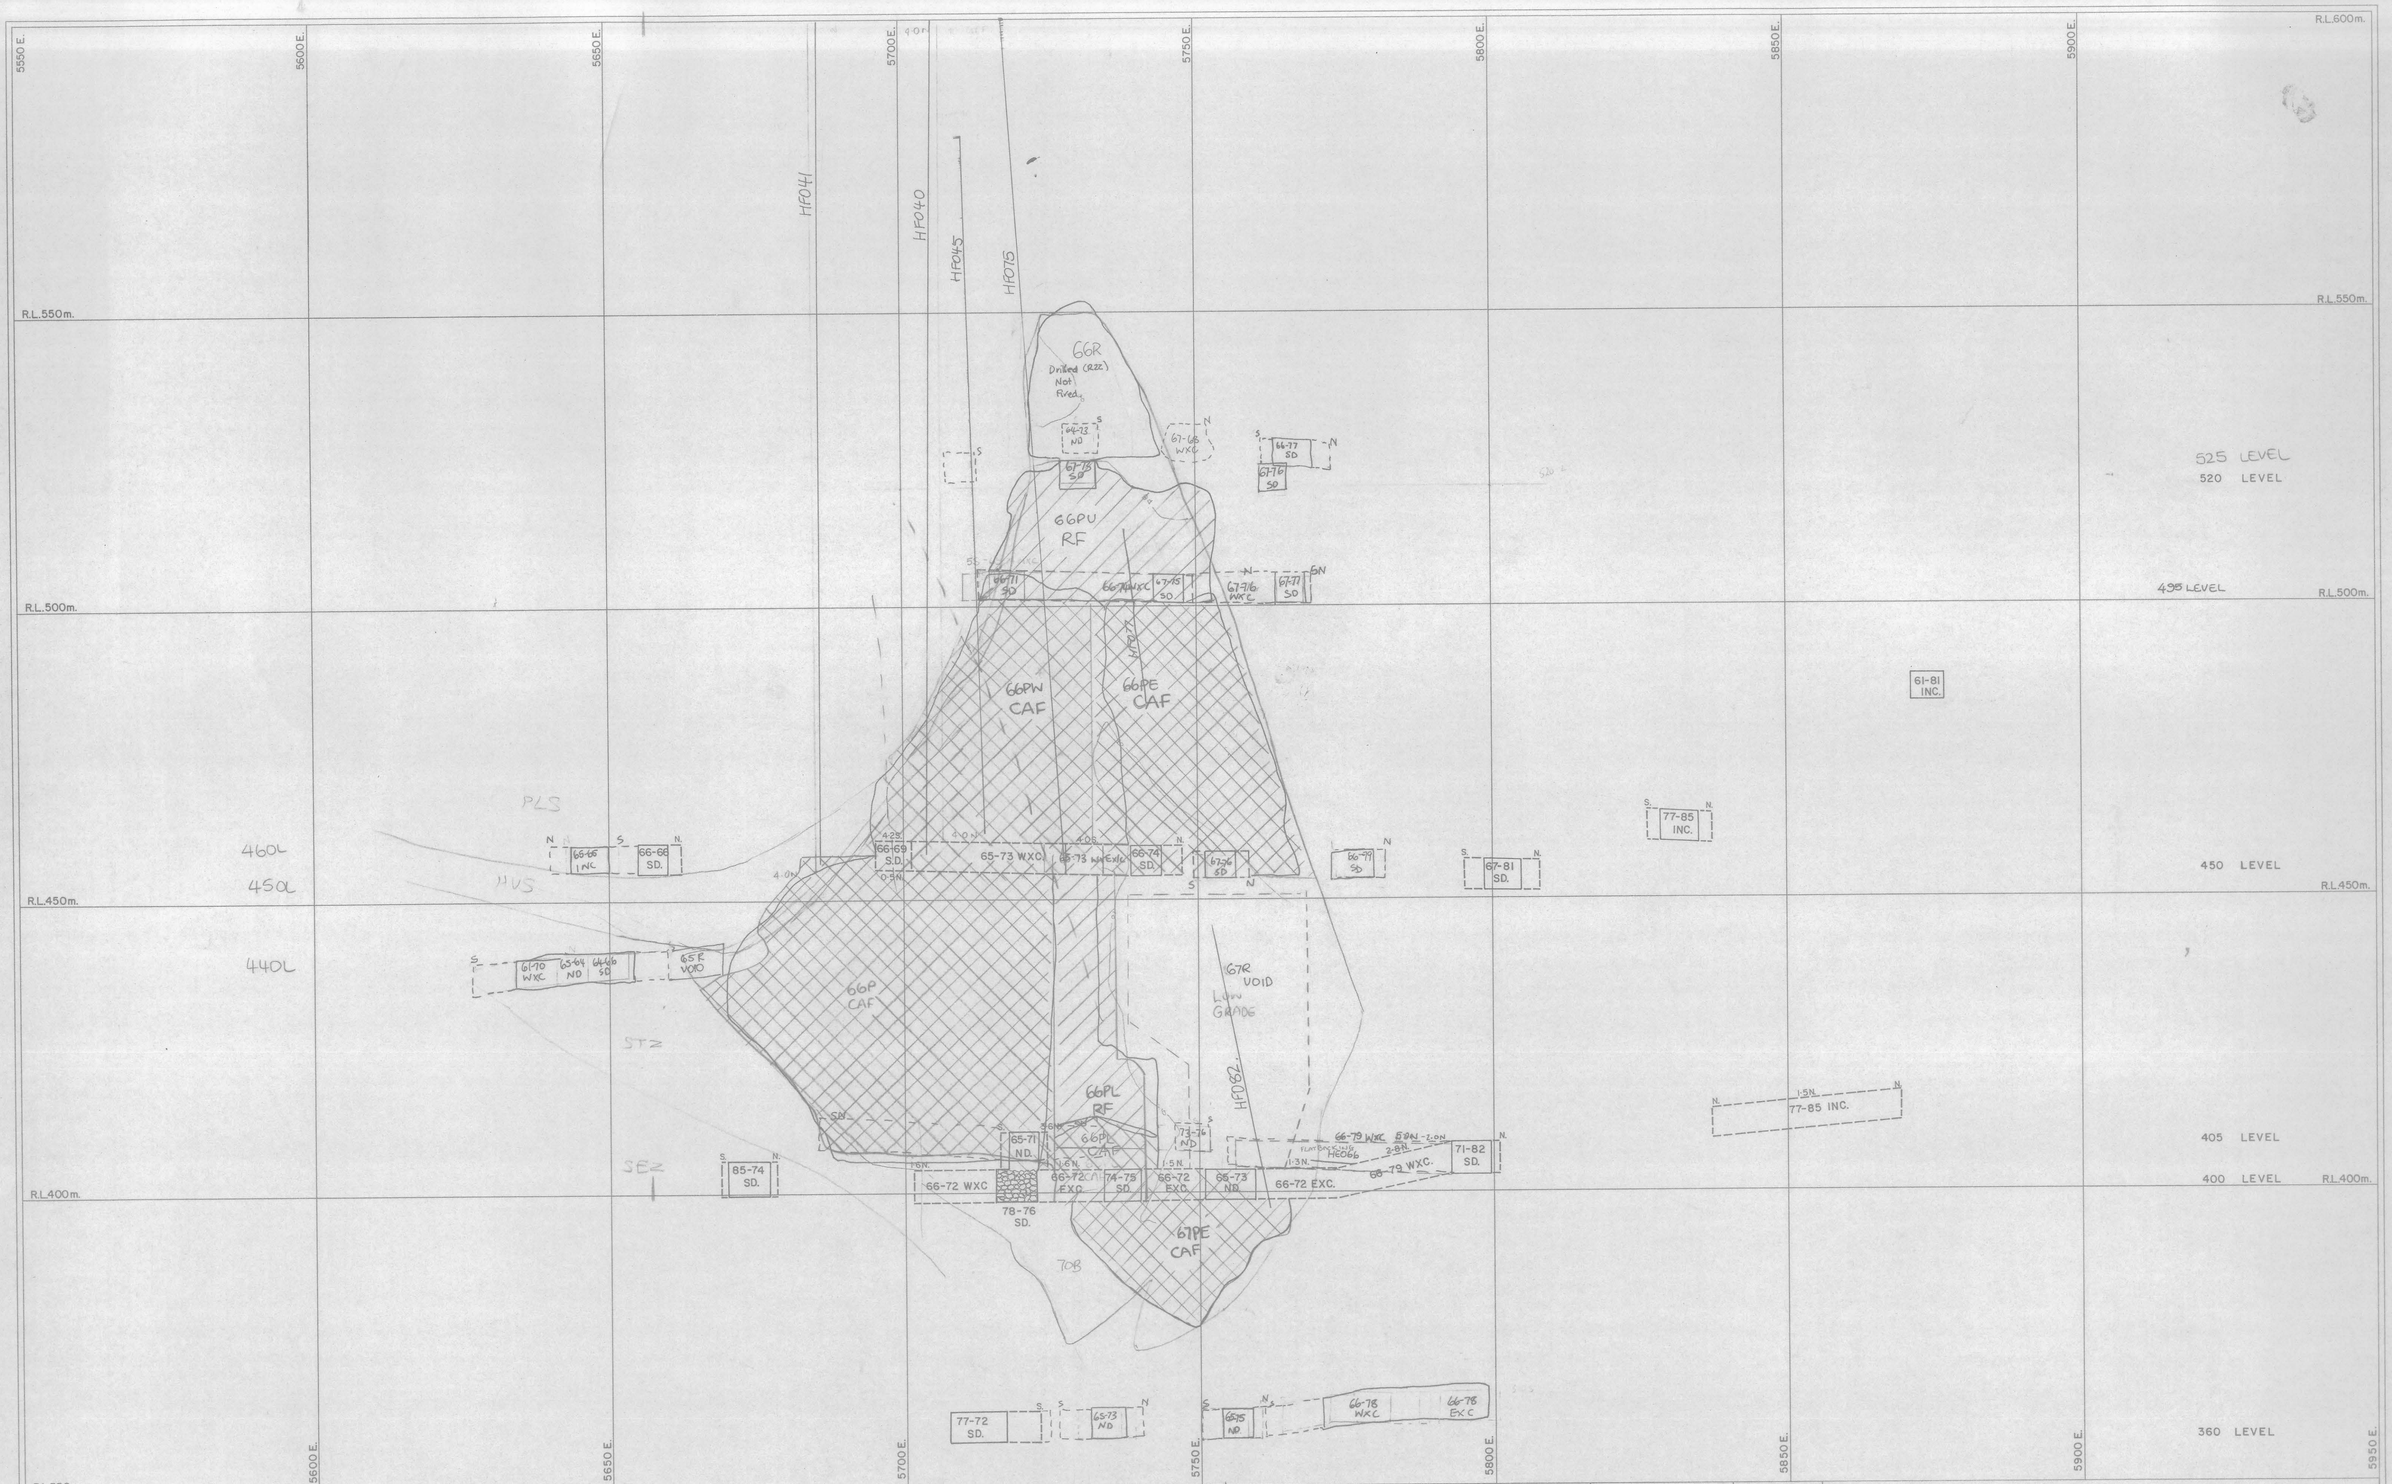

REV	DATE	REVISION	DRAWN	CKD	APP	REV	DATE	REVISION	DRAWN	CKD	APP	APP
8	26/6/97	ADD 66PCAF, 66PL RF, 67-70W, 65-64N, 64-66S, 65-65INC, AND PLANNED 66P STOPES	TLM	DSP	GMH	15	30/12/98	67PE CAF ADDED	SRM	KDP		
9	8/9/97	CHANGE 65-64ND 440L K2W	TLM	JRS	GMH	16	15/4/99	ADD 67-73SD + 67-78WXC 66R 525L	TLM	JMM	AM	110599
10	12/9/97	CHANGE 65-73ND 360L	DSP	TLM	RW	17	11/8/99	ADDED 66-79WXC (FLAT BACKING)	KDP	RW	AM	18/10/99
11	14.10.97	GEOL UPDATE.	CSD			18	18-10-99	DEL: 67-73SD 66R. ADD 66-77SD	TLM	KDP	AM	02/11/99
12	7-1-98	ADD 67-76WXC + 67-77SD 495L	TLM	DSP	RW	19	18/11/99	ADDED STRIPPING TO 66-79SD 450L	KDP	TLM	AM	1/11/99
13	9/6/98	ADD 62-75ND 450L. 62R	TLM	DSP	RW	20	11/1/00	ADD 64-73ND 525L 66R	TLM	JM	AM	10/1/00
14	27-7-98	REMOVE 63-75ND, ADD 66-79S 67R stope. 66PE CAF	TLM	RW	RW	7	23/10/96	ADD 495L AND 67-73SD 520L	TLM	RW	M	

NORTH

SCALE	1 : 500
SHEET No.	
DRAWN	
CHECKED	
DESIGNED	
DESIGN CKD	
DESIGN APP	
PROJECT APP	

Aberfoyle Resources Limited
HELLYER DIVISION

DEVELOPMENT DESIGN
SECTION 10660N

DRAWING No.

5 cm

04 06 - 298