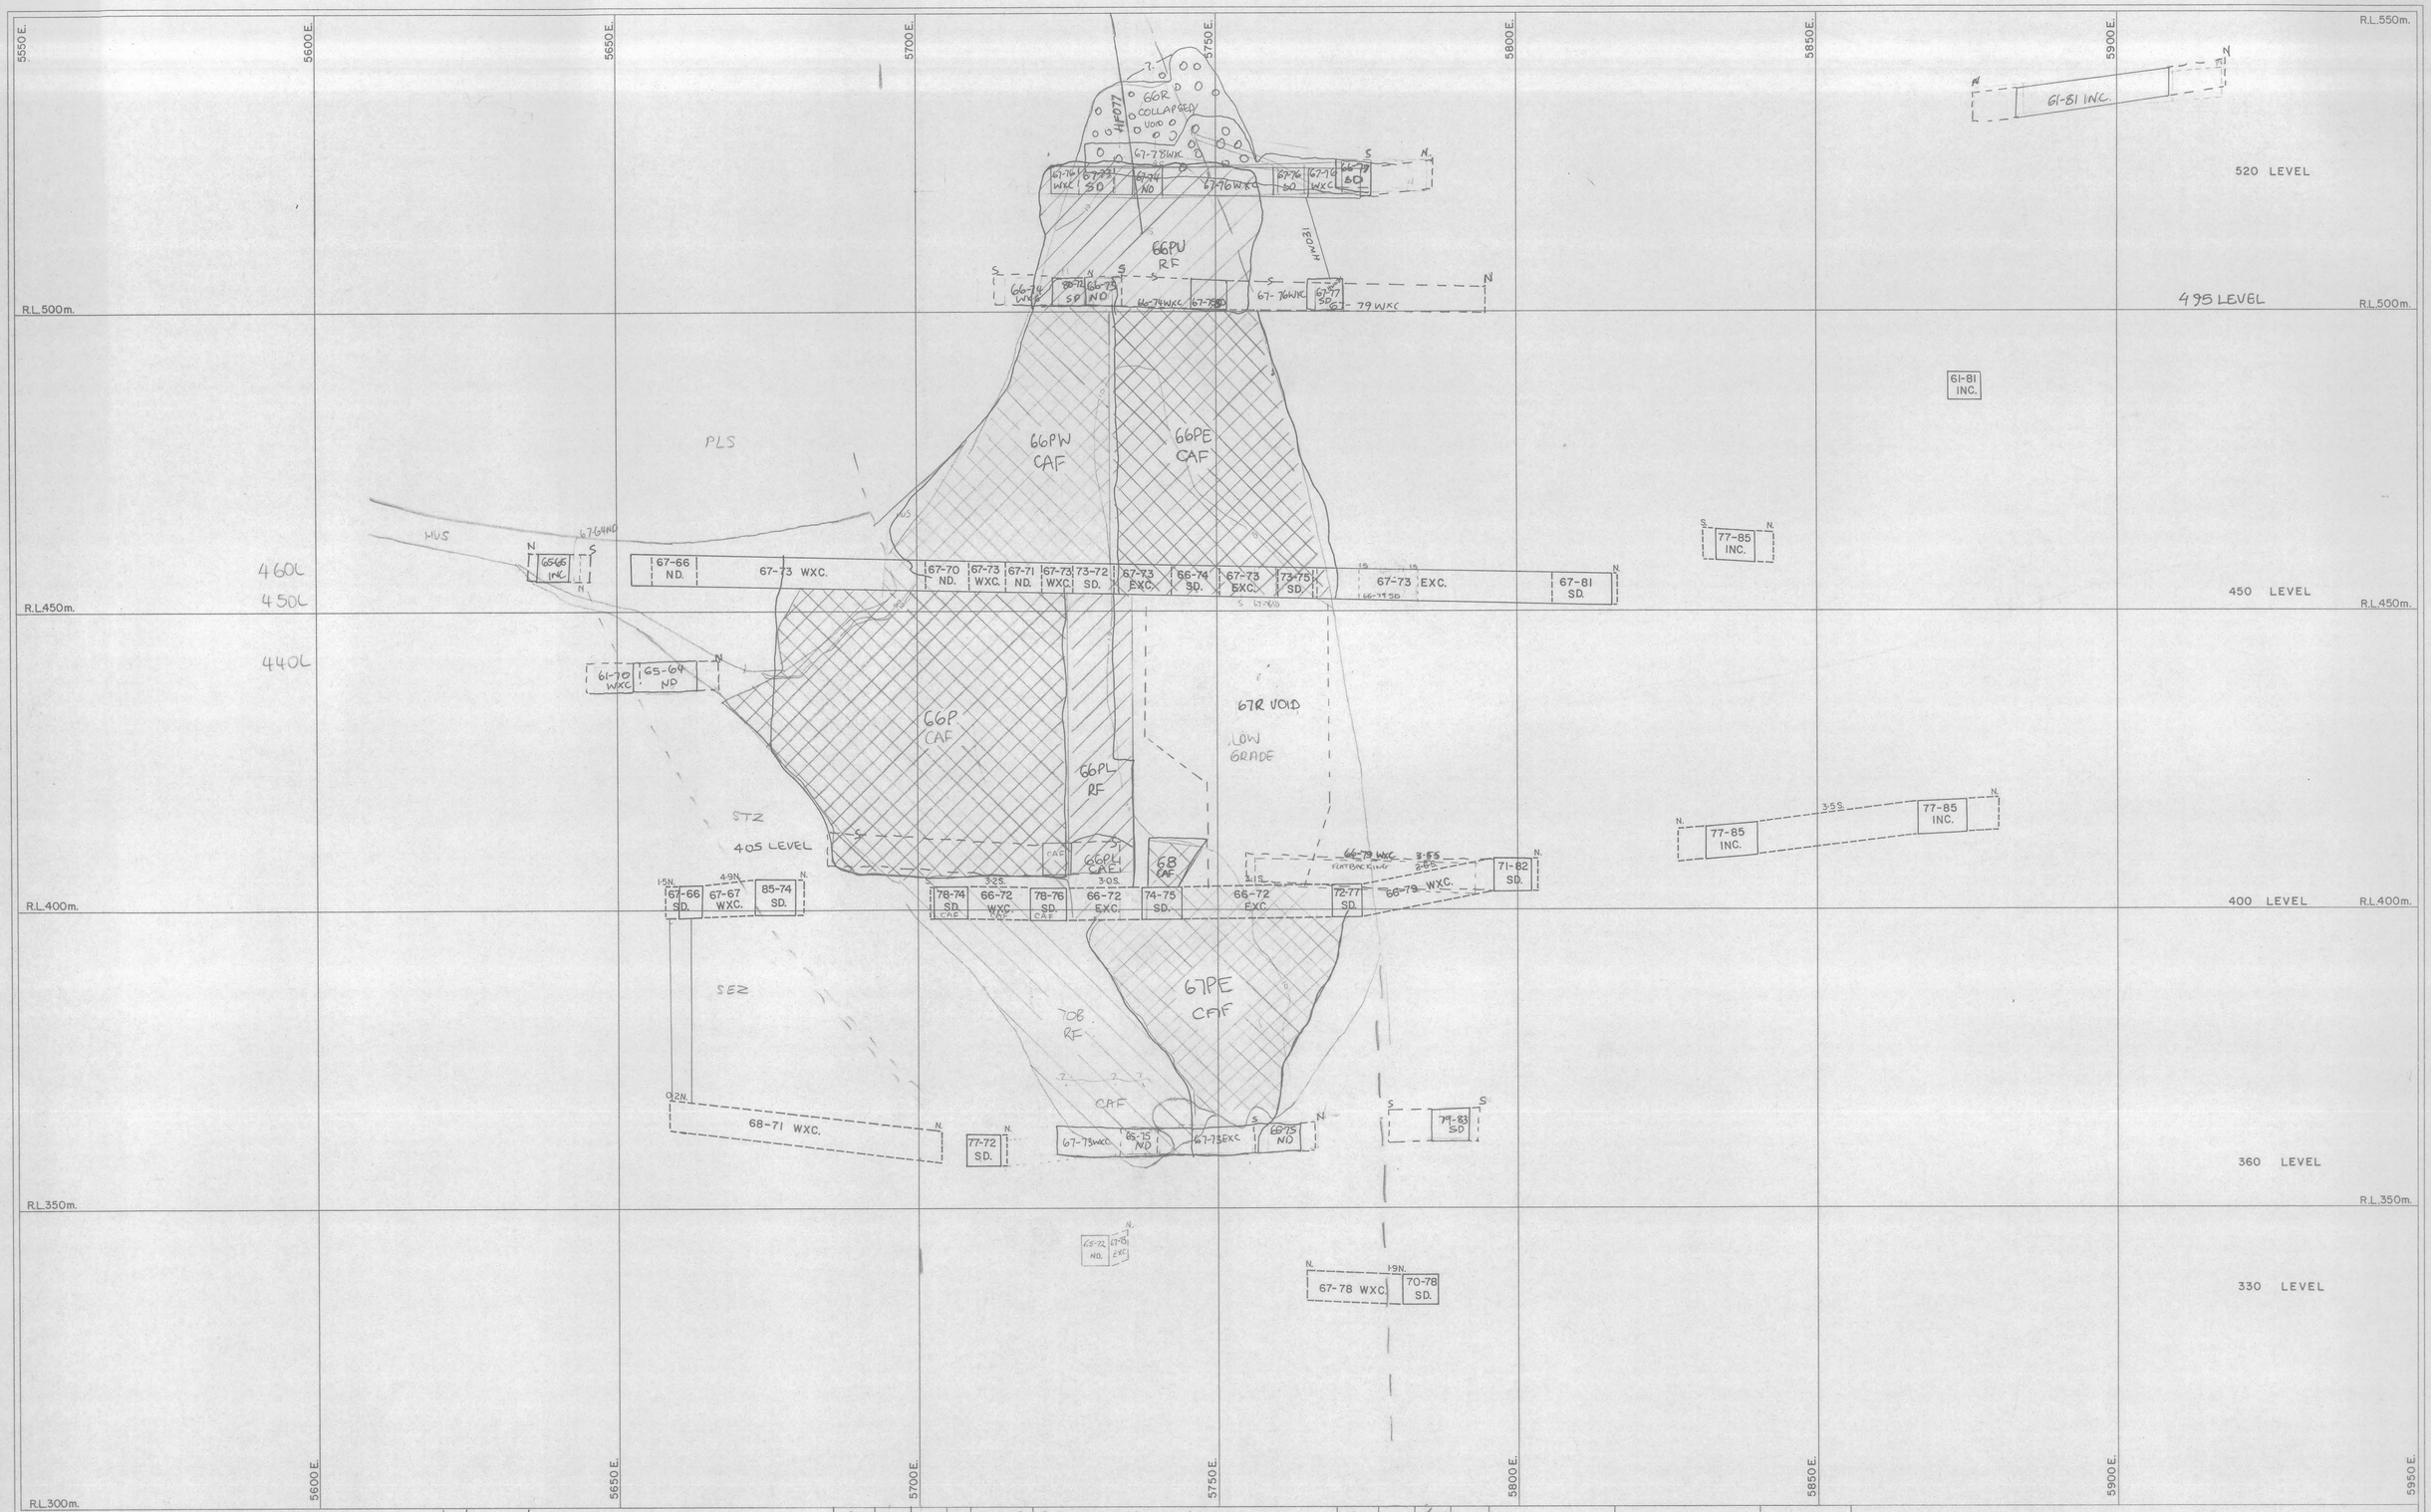

REV	DATE	REVISION	DRAWN	CKD	APP	REV	DATE	REVISION	DRAWN	CKD	APP	APP
22	28-10-99	ADD 67-64ND KZWSTH 460L	TLM	RW		15	27-7-98	ADD 67R, 66PE CAF, 66-79SD, 450L	TLM	RW		300798
23	18/11/99	ADDED STRIPPING TO 66-79 SD 450L	KDP	TLM		16	10-2-99	ADD 67PE CAF	SRM	KDP		23/2/99
10	20/6/97	ADD 65-66 ND, 65-66WXC, 66-67WXC, 66-67SD, 66-67WXC, PLANNED SDRES DUMP	TLM	DJA		17	23-12-98	ADD 67-73WXC EXTENSION 4.5m x 4.5m 360L	SRM			23/12/98
11	8/9/97	CHANGE 65-64ND 440L KZW	TLM	JRS		18	1-2-99	Geology updated				
12	18/9/97	ADD 65-73ND 67-73WXC 67-73EXC	DJA	TLM		19	15-4-99	ADD 67-78WXC 66R 525L	TLM			150499
13	14-10-97	CEAL UPDATE				20	11/8/99	ADDED 66-79 WXC FLAT BACKING	KDP	RW		021199
14	7-1-98	ADD 67-73WXC + 67-76SD 495L	TLM	DJP		21	18-10-99	ADD 66-77SD 66R 525L	TLM	KDP		181099

NORTH

SCALE	1 : 500
SHEET No.	
DRAWN	
CHECKED	
DESIGNED	
DESIGN CKD	
DESIGN APP	
PROJECT APP	

Aberfoyle Resources Limited
HELLYER DIVISION

DEVELOPMENT DESIGN
SECTION 10670N

DRAWING No.

5 cm

0406 - 289