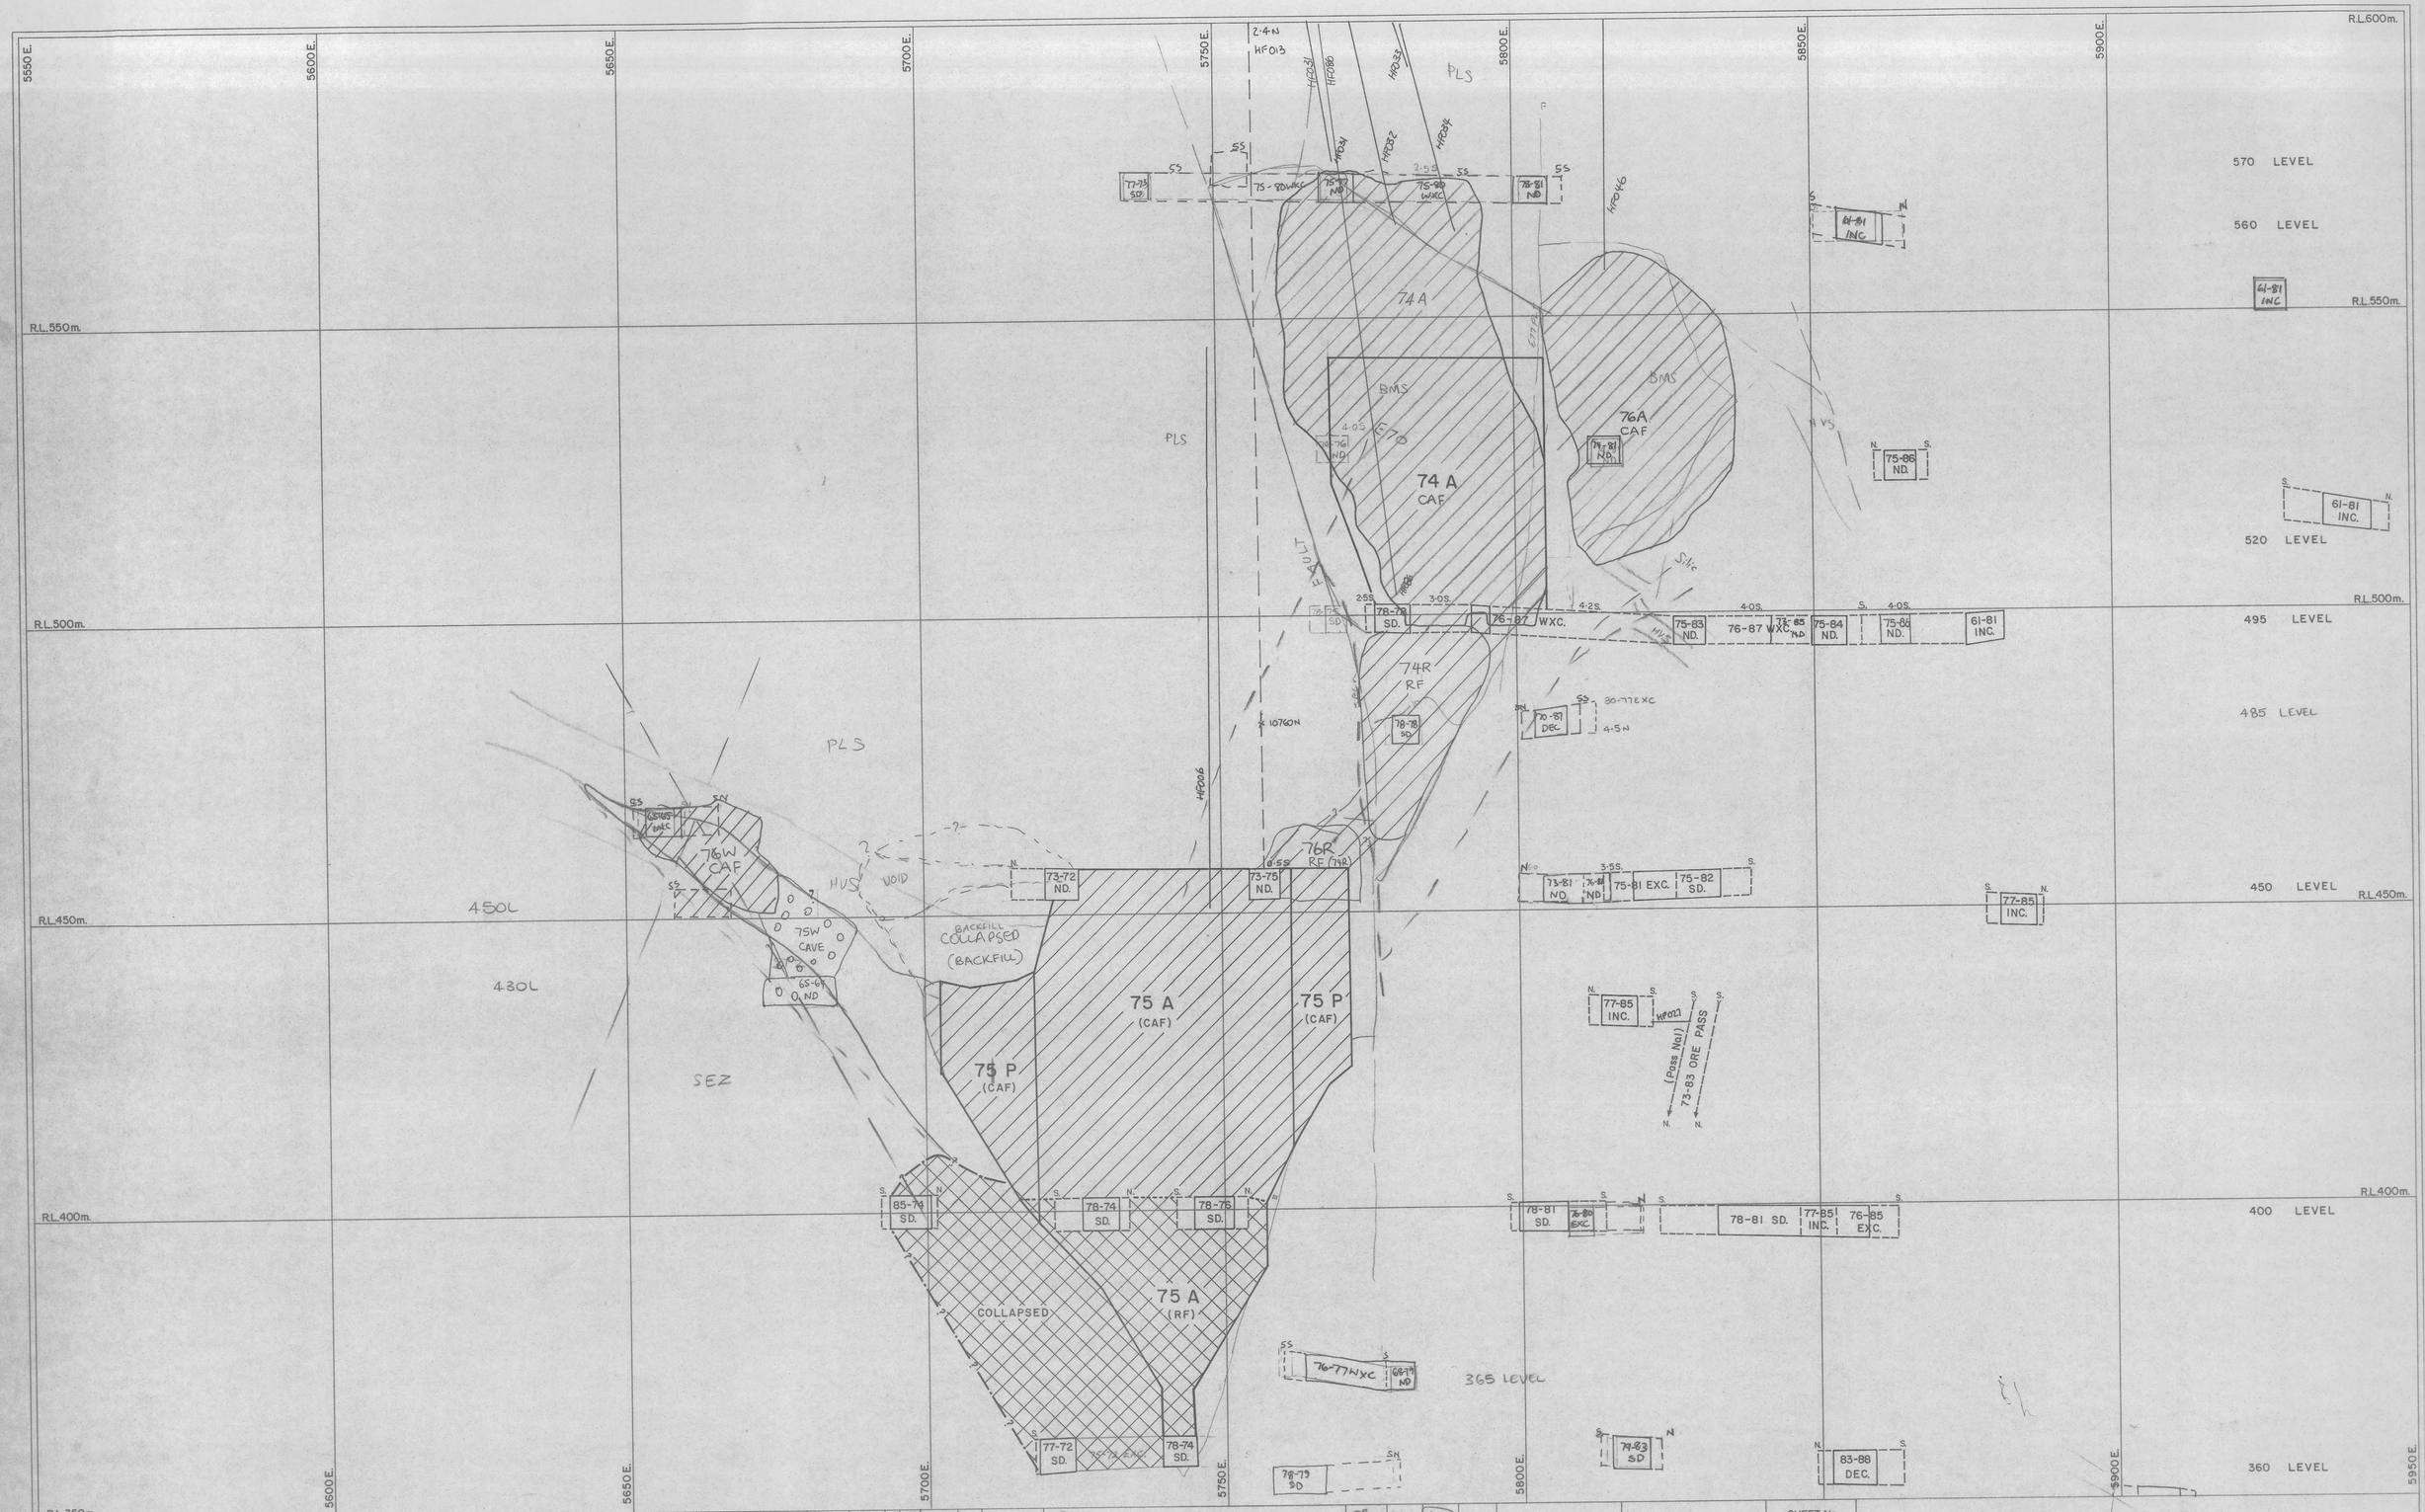

REV	DATE	REVISION	DRAWN	CKD	APP
23	30-4-98	CHANGE 65-64ND 430L K2W	TLM	DSH	
24	7-8-98	CHANGE 65-64ND 430L K2W SIZE 4.5x4.5	TLM		
25	18-8-98	EXTEND 65-65 INC 460L, underged control	TLM		
26	9-9-98	ADD 76-77WXC 75D 365L	TLM	RW	
27	10-9-98	ADD 76-81ND 78P 450L	RW		
28	12-11-98	ADD 78-79SD 75D 360L	TLM	RW	
29	20-1-99	ADD 76-68WXC 430L 75W	TLM		

REV	DATE	REVISION	DRAWN	CKD	APP
30	9.2.99	Cad	CSD		
31	7.5.99	ADD 80-77EXC 78PE 485L	RW	KGP	18/6/99
18	12-1-97	REMOVED 65-65INC460L, 75-68WXC 460L	TLM	KDP	19/1/98
19	2-2-98	CHANGE GRADE OF 65-64ND 430L	TLM	DSH	4/2/98
20	1-4-98	CHANGE 70-81DEC, REMOVE 78-78SD, ADD 78-78SD	TLM	KDP	30/4/98
21	22-4-98	EXTEND 68-79ND 365L TO 77P, 75D	TLM	CMD	22/10/98
22	23-4-98	CHANGE K2W DEVT 450L, VOID	TLM	DSH	30/4/98

NORTH

SCALE	1:500
SHEET No.	
DRAWN	
CHECKED	
DESIGNED	
DESIGN CKD	
DESIGN APP	
PROJECT APP	

Aberfoyle Resources Limited
HELLYER DIVISION

DEVELOPMENT DESIGN
SECTION 10760N

DRAWING No.

5 cm

04.06 - 305