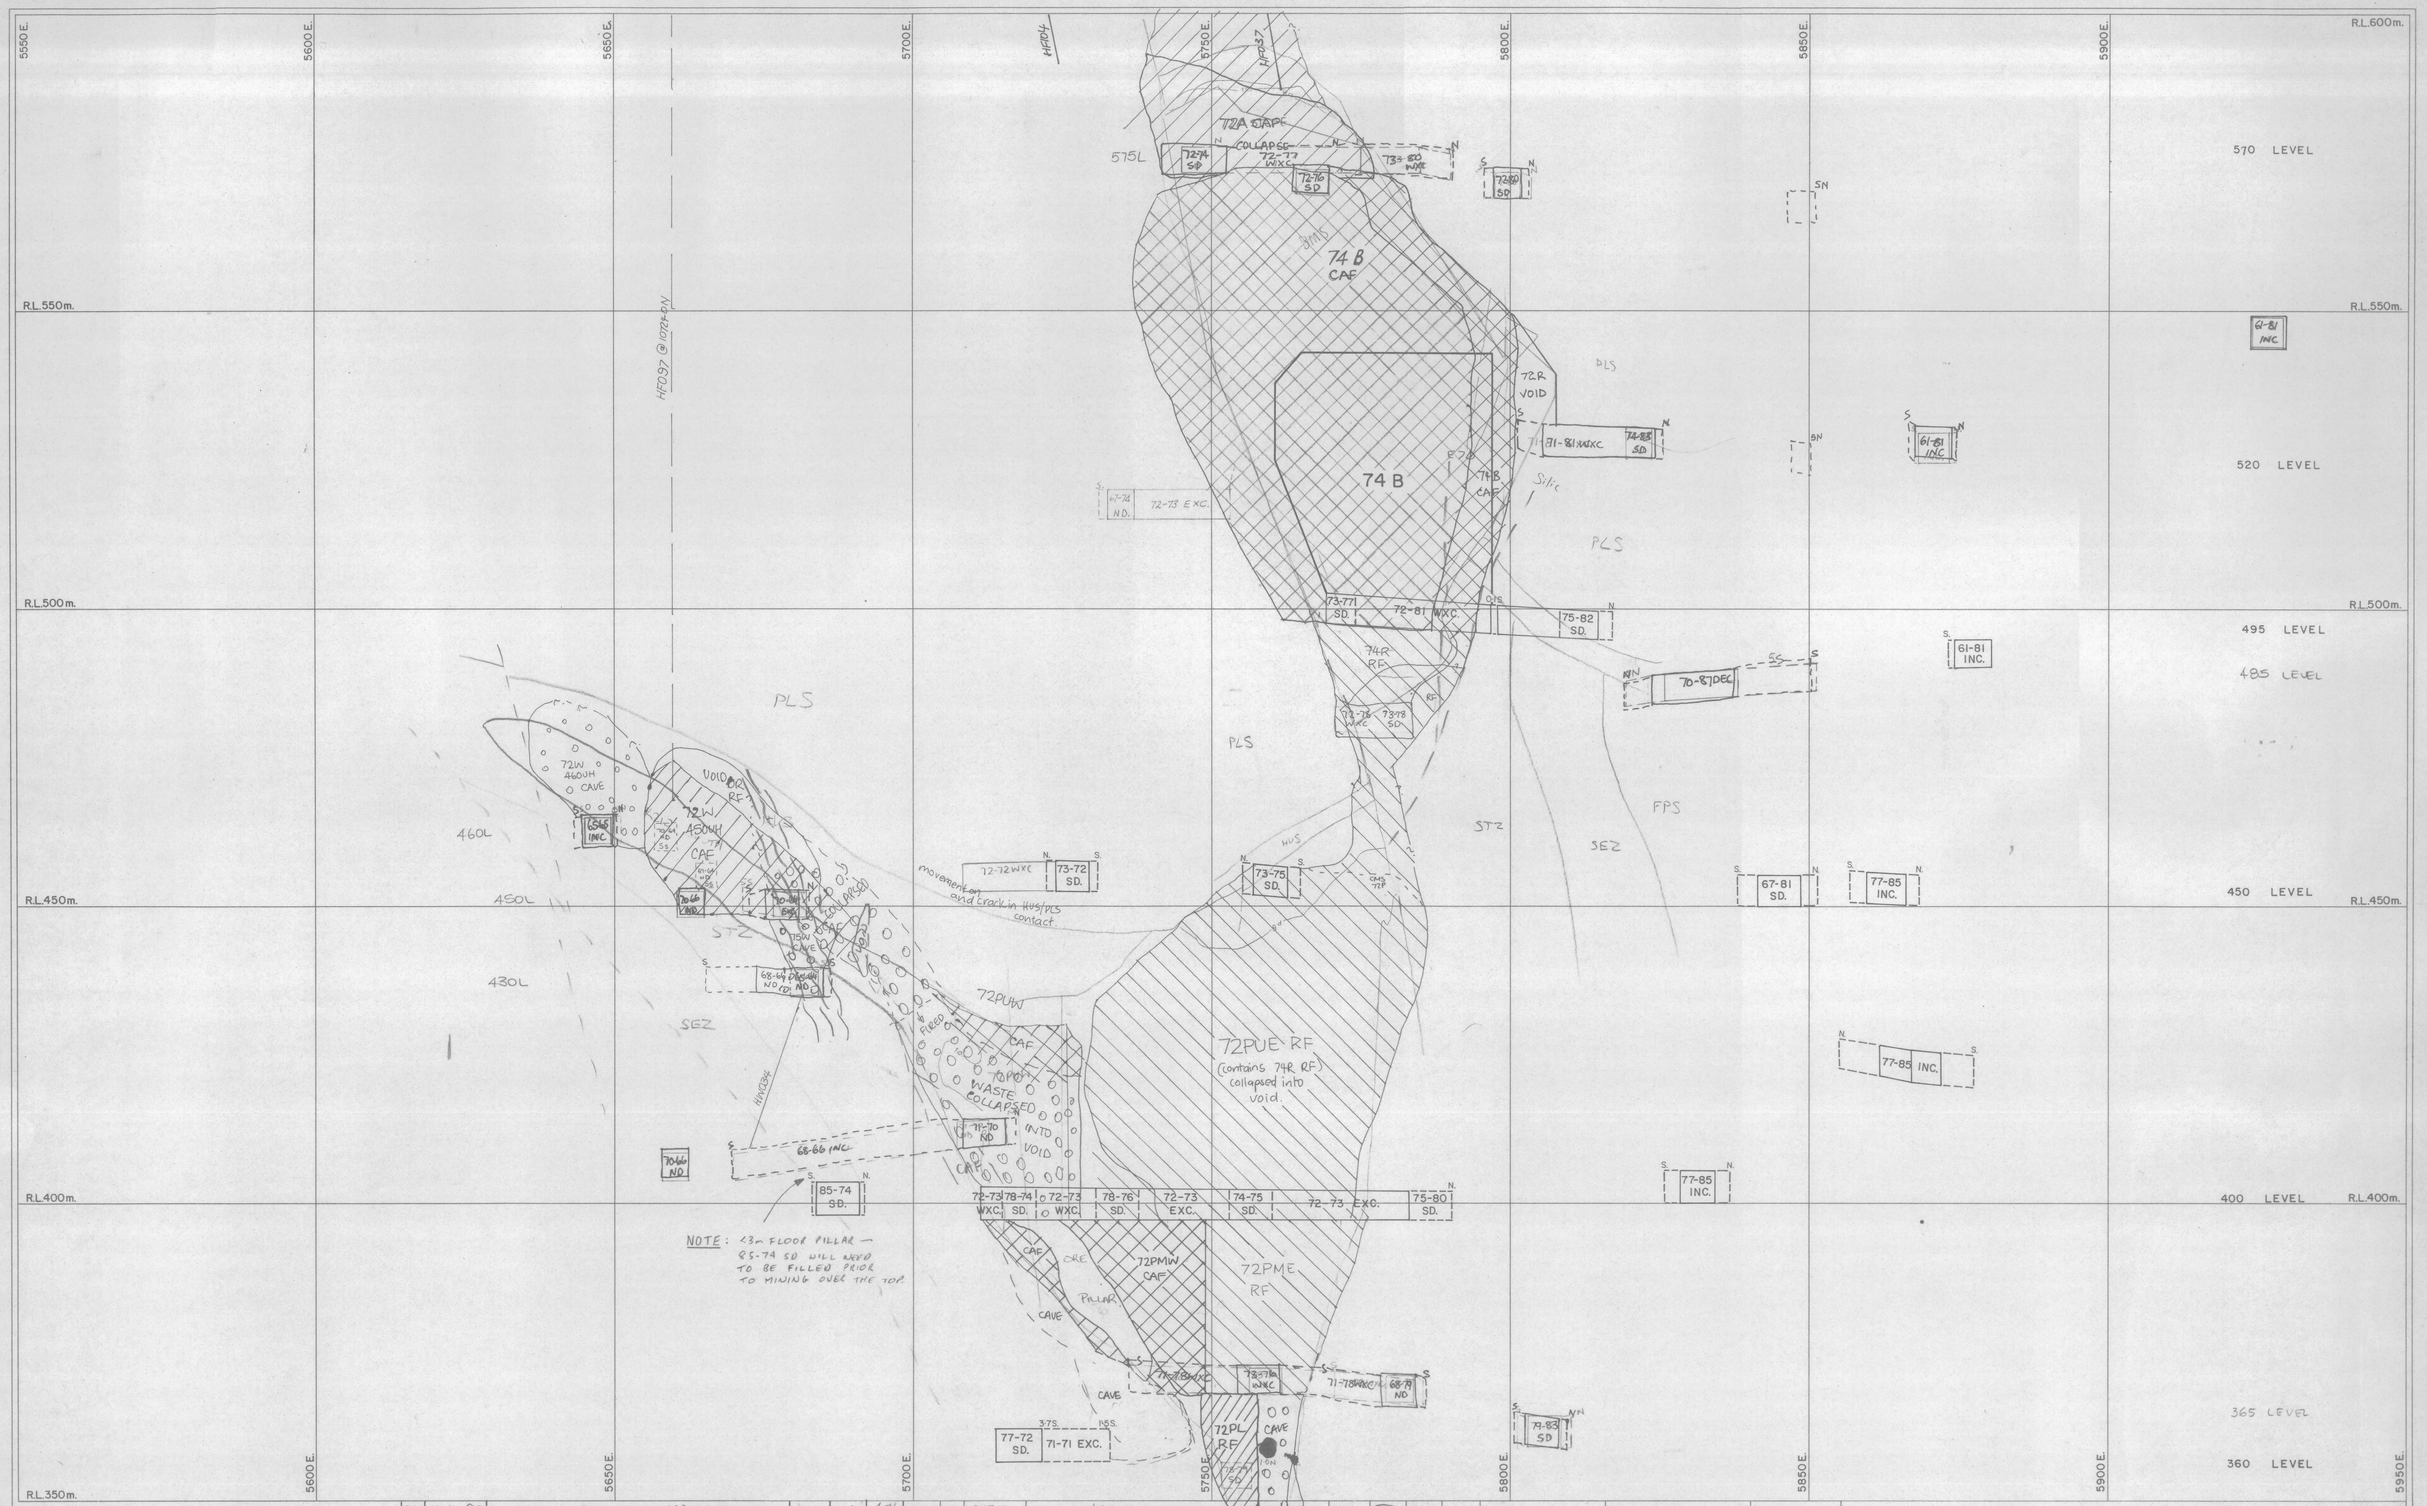

REV	DATE	REVISION	DRAWN	CKD	APP	APP
23	1-4-98	REMOVE 75-78SD, ADD 78-78SD 485L 74R	TLM	KOP		150498
24	22-4-98	ADD VOID KZW + CAF	TLM	DSA		280498
25	31-4-98	CHANGE 65-66ND 430L KZW	TLM	DSA		300498
26	7-8-98	CHANGE 65-66ND 430L TO 4.5x4.5	TLM			
27	12-11-98	ADD 78-79DD 75D 360L	TLM			171198
28	11.1.99	ADD 72-78 WXC 74R 485L	RW			14/1/99
30	6.12.99	GEOLOGY UPDATED	CSD			
29	3.12.97	ADD 68-66ND 430L ACCESS 1095	TLM	KOP		011297
15	8/8/96	ADD 70-66ND - DIAMOND DRILL CUTDOWN	TLM			
16	14/4/97	REMOVE 71-76ND, ADD 73-76WXC	TLM	DSA		150497
17	20/6/97	ADD 65-64ND, 67-66DEC, 65-65INC, 76-80WXC	TLM	DSA		160697
20	16/10/97	ADD 70-87DEC, 75-78SD, 74R 485L	TLM	DSA		171097
19	26/8/97	ADD 72-72WXC 450L 72P	TLM	SRS		270897
21	20-10-97	ADD 70-66ND, DELETE 67-66DEC 430L KZW	TLM	DSA		211097
22	2-2-98	CHANGE GRADE OF 65-66ND 430L.	TLM	DSA		4/2/98

NORTH

SCALE 1:500	SHEET No.
DRAWN	
CHECKED	
DESIGNED	
DESIGN CKD	
DESIGN APP	
PROJECT APP	

Aberfoyle Resources Limited
HELLYER DIVISION

DEVELOPMENT DESIGN
SECTION 10720N

DRAWING No.

5 cm

0406 - 309