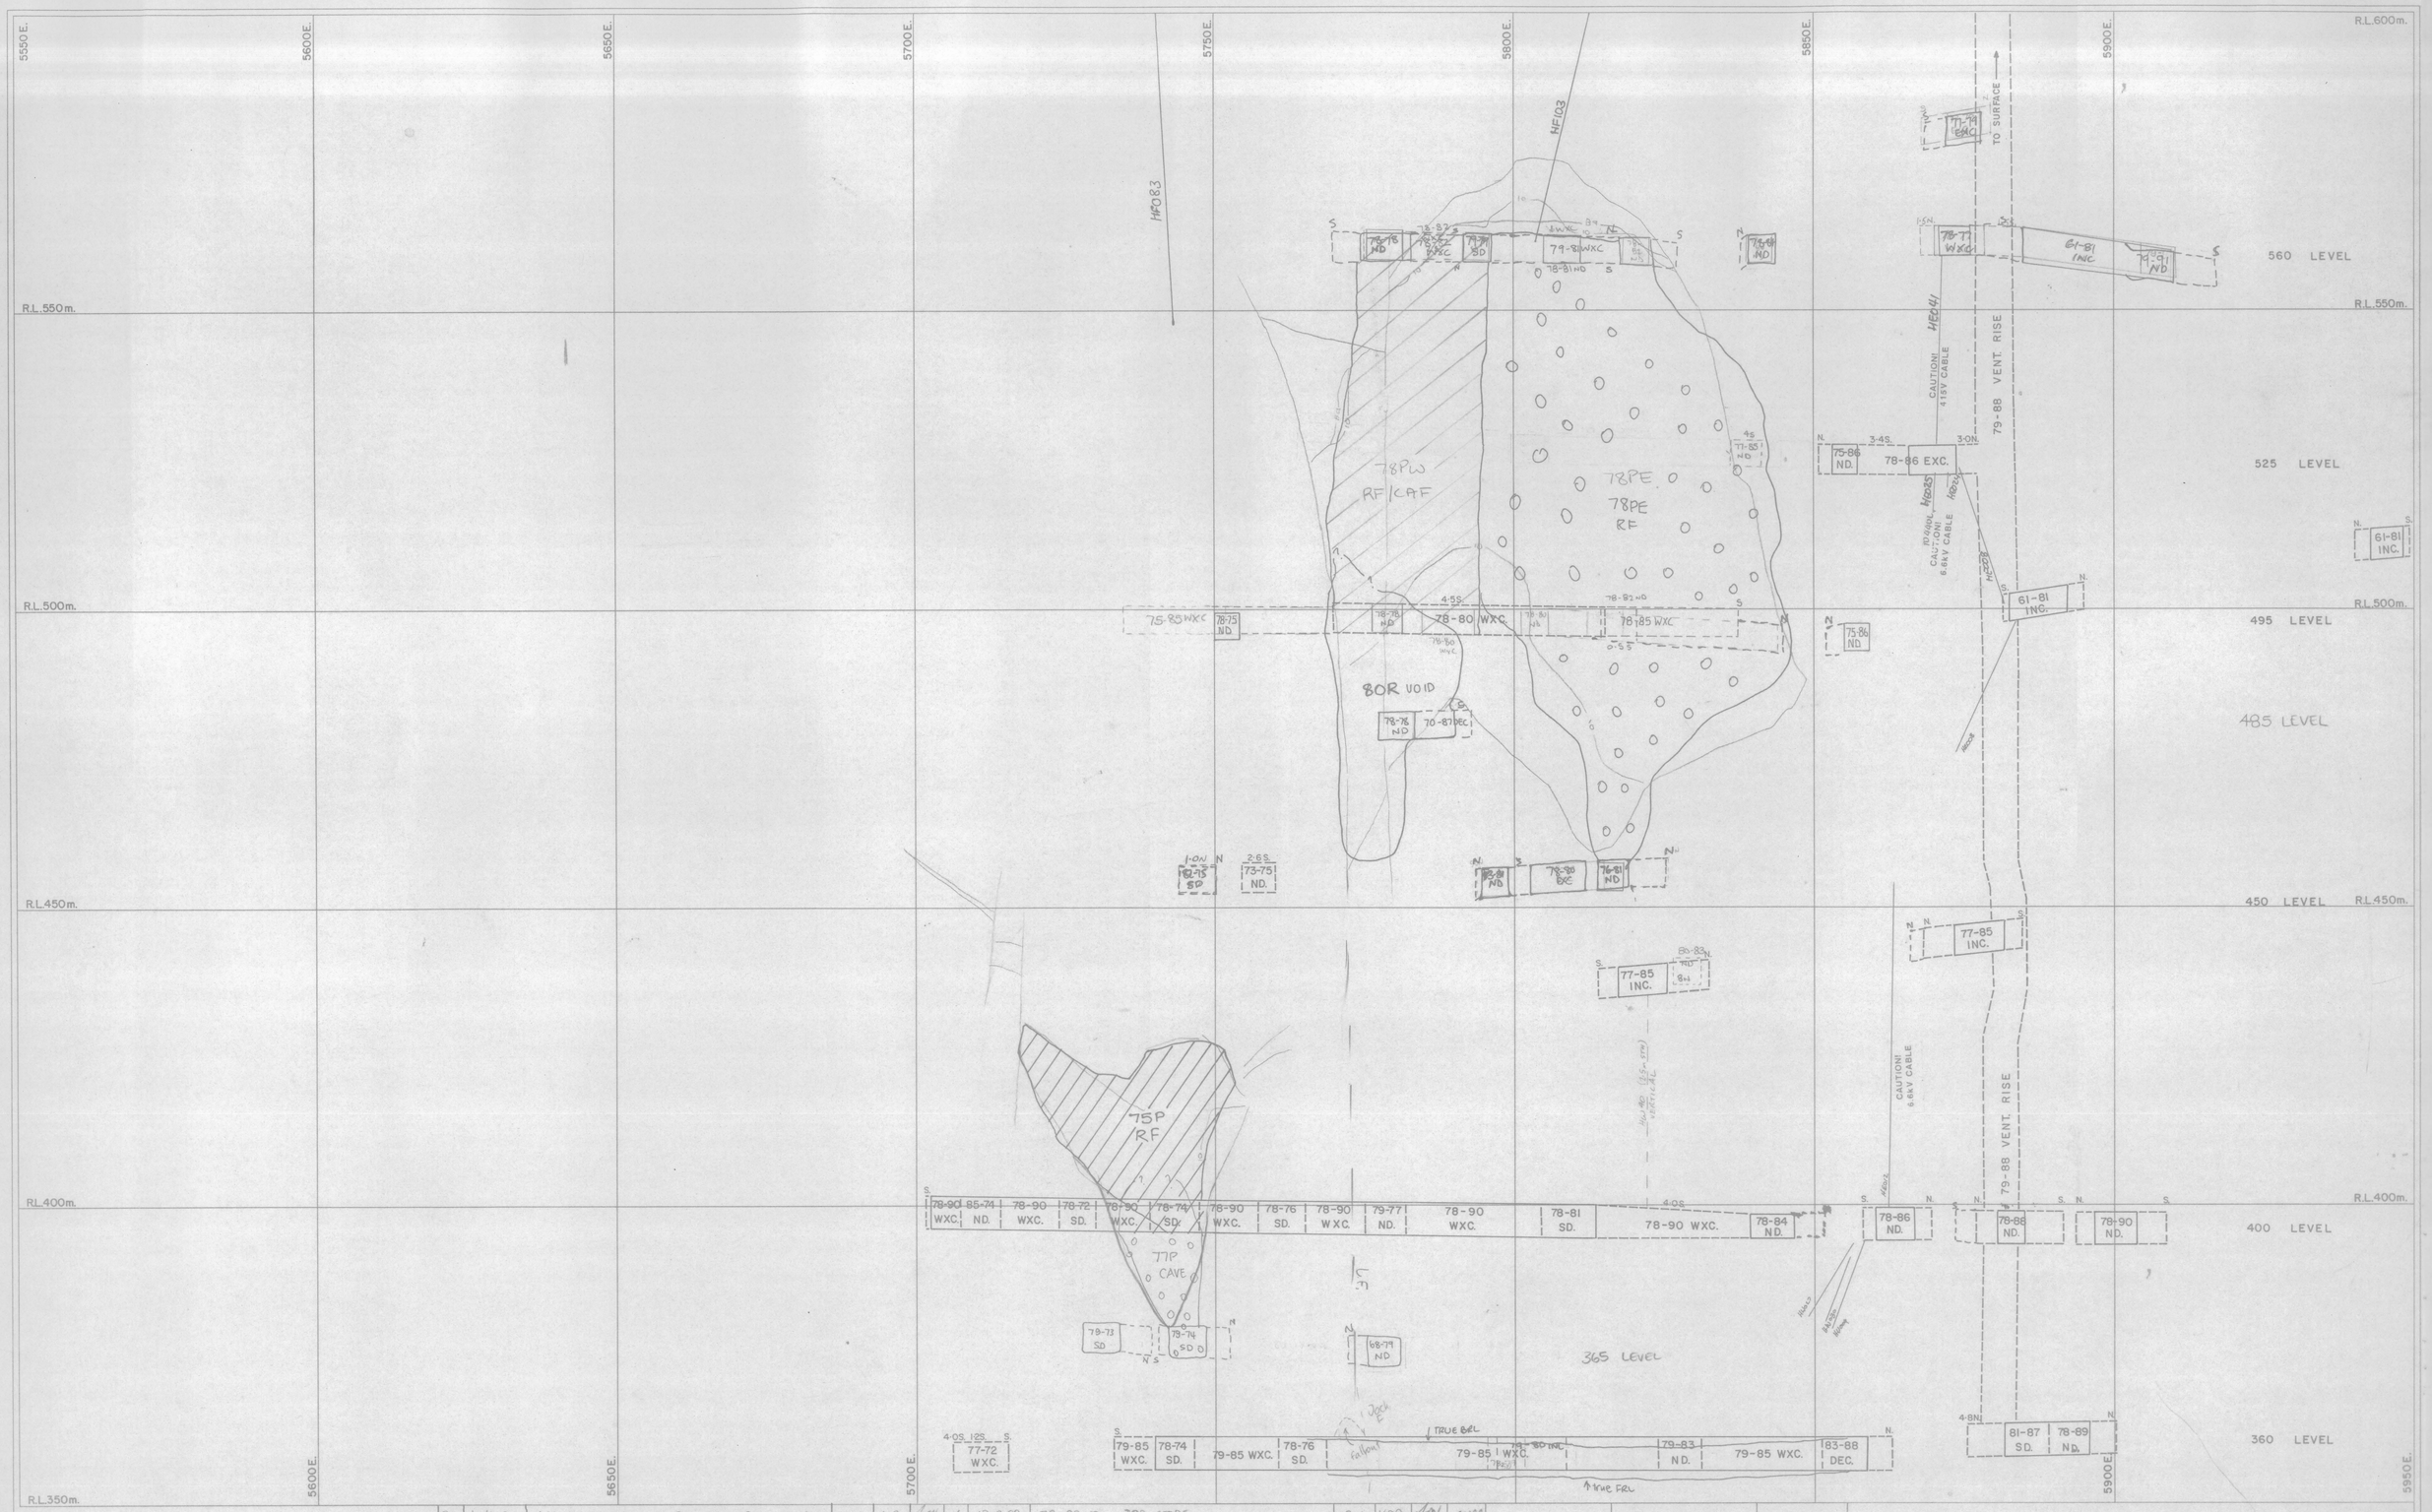

REV	DATE	REVISION	DRAWN	CKD	APP	APP
8	1-4-98	ADD 78-78 ND, 70-87DEC - 485L 74R/80R	TLM	KDP		
9	25-5-98	ADD 78-85 WXC, 78-77ND, 78-80ND 575L 78P	RW	KDP		
10	25-5-98	ADD 82-75SD 450L	JMH	KDP		
11	18-6-98	ADDED 78-78ND, 78-80ND, 78-82WXC 78P 560L	RW	KDP		
12	9-9-98	ADD 68-79ND, 79-73SD, 79-74SD, 80SL 77P	TLM	RW		
13	10.9.98	REMOVED 78-75 ND, 78-80 ND, 78-85 WXC 575L 78P ADD 76-81 ND 450L, 78-78ND 78-82ND 495L, MOVE 78-78 ND 560L	RW	TLM		
14	12-11-98	ADD 78-79SD 750 560L - TAKEOFF	TLM	RW		
15	23.12.98	ADD 80-83 ND 86P 440L	RW			
16	12.3.99	78-82 ND 78P STOPE	RW	KDP		150399
17	15.3.99	Cool.				
18	18.3.99	move 78-81 ND 78P 560L	RW	TLM		200399
4	13/6/95	495L 75-86 ND & 78-75 ND Added	PCK	DMS		
5	12/9/95	560L 78-84 ND ADDED	MNL			
6	7/12/95	ADD HE 40 440L TO 400L	WTS			
7	15/2/96	80A DEPT 560L	DCG			

SCALE	1:500
SHEET No.	
DRAWN	
CHECKED	
DESIGNED	
DESIGN CKD	
DESIGN APP	
PROJECT APP	

NORTH

Aberfoyle Resources Limited
HELLYER DIVISION

DEVELOPMENT DESIGN
SECTION 10790N

DRAWING No.

5 cm

0406-311