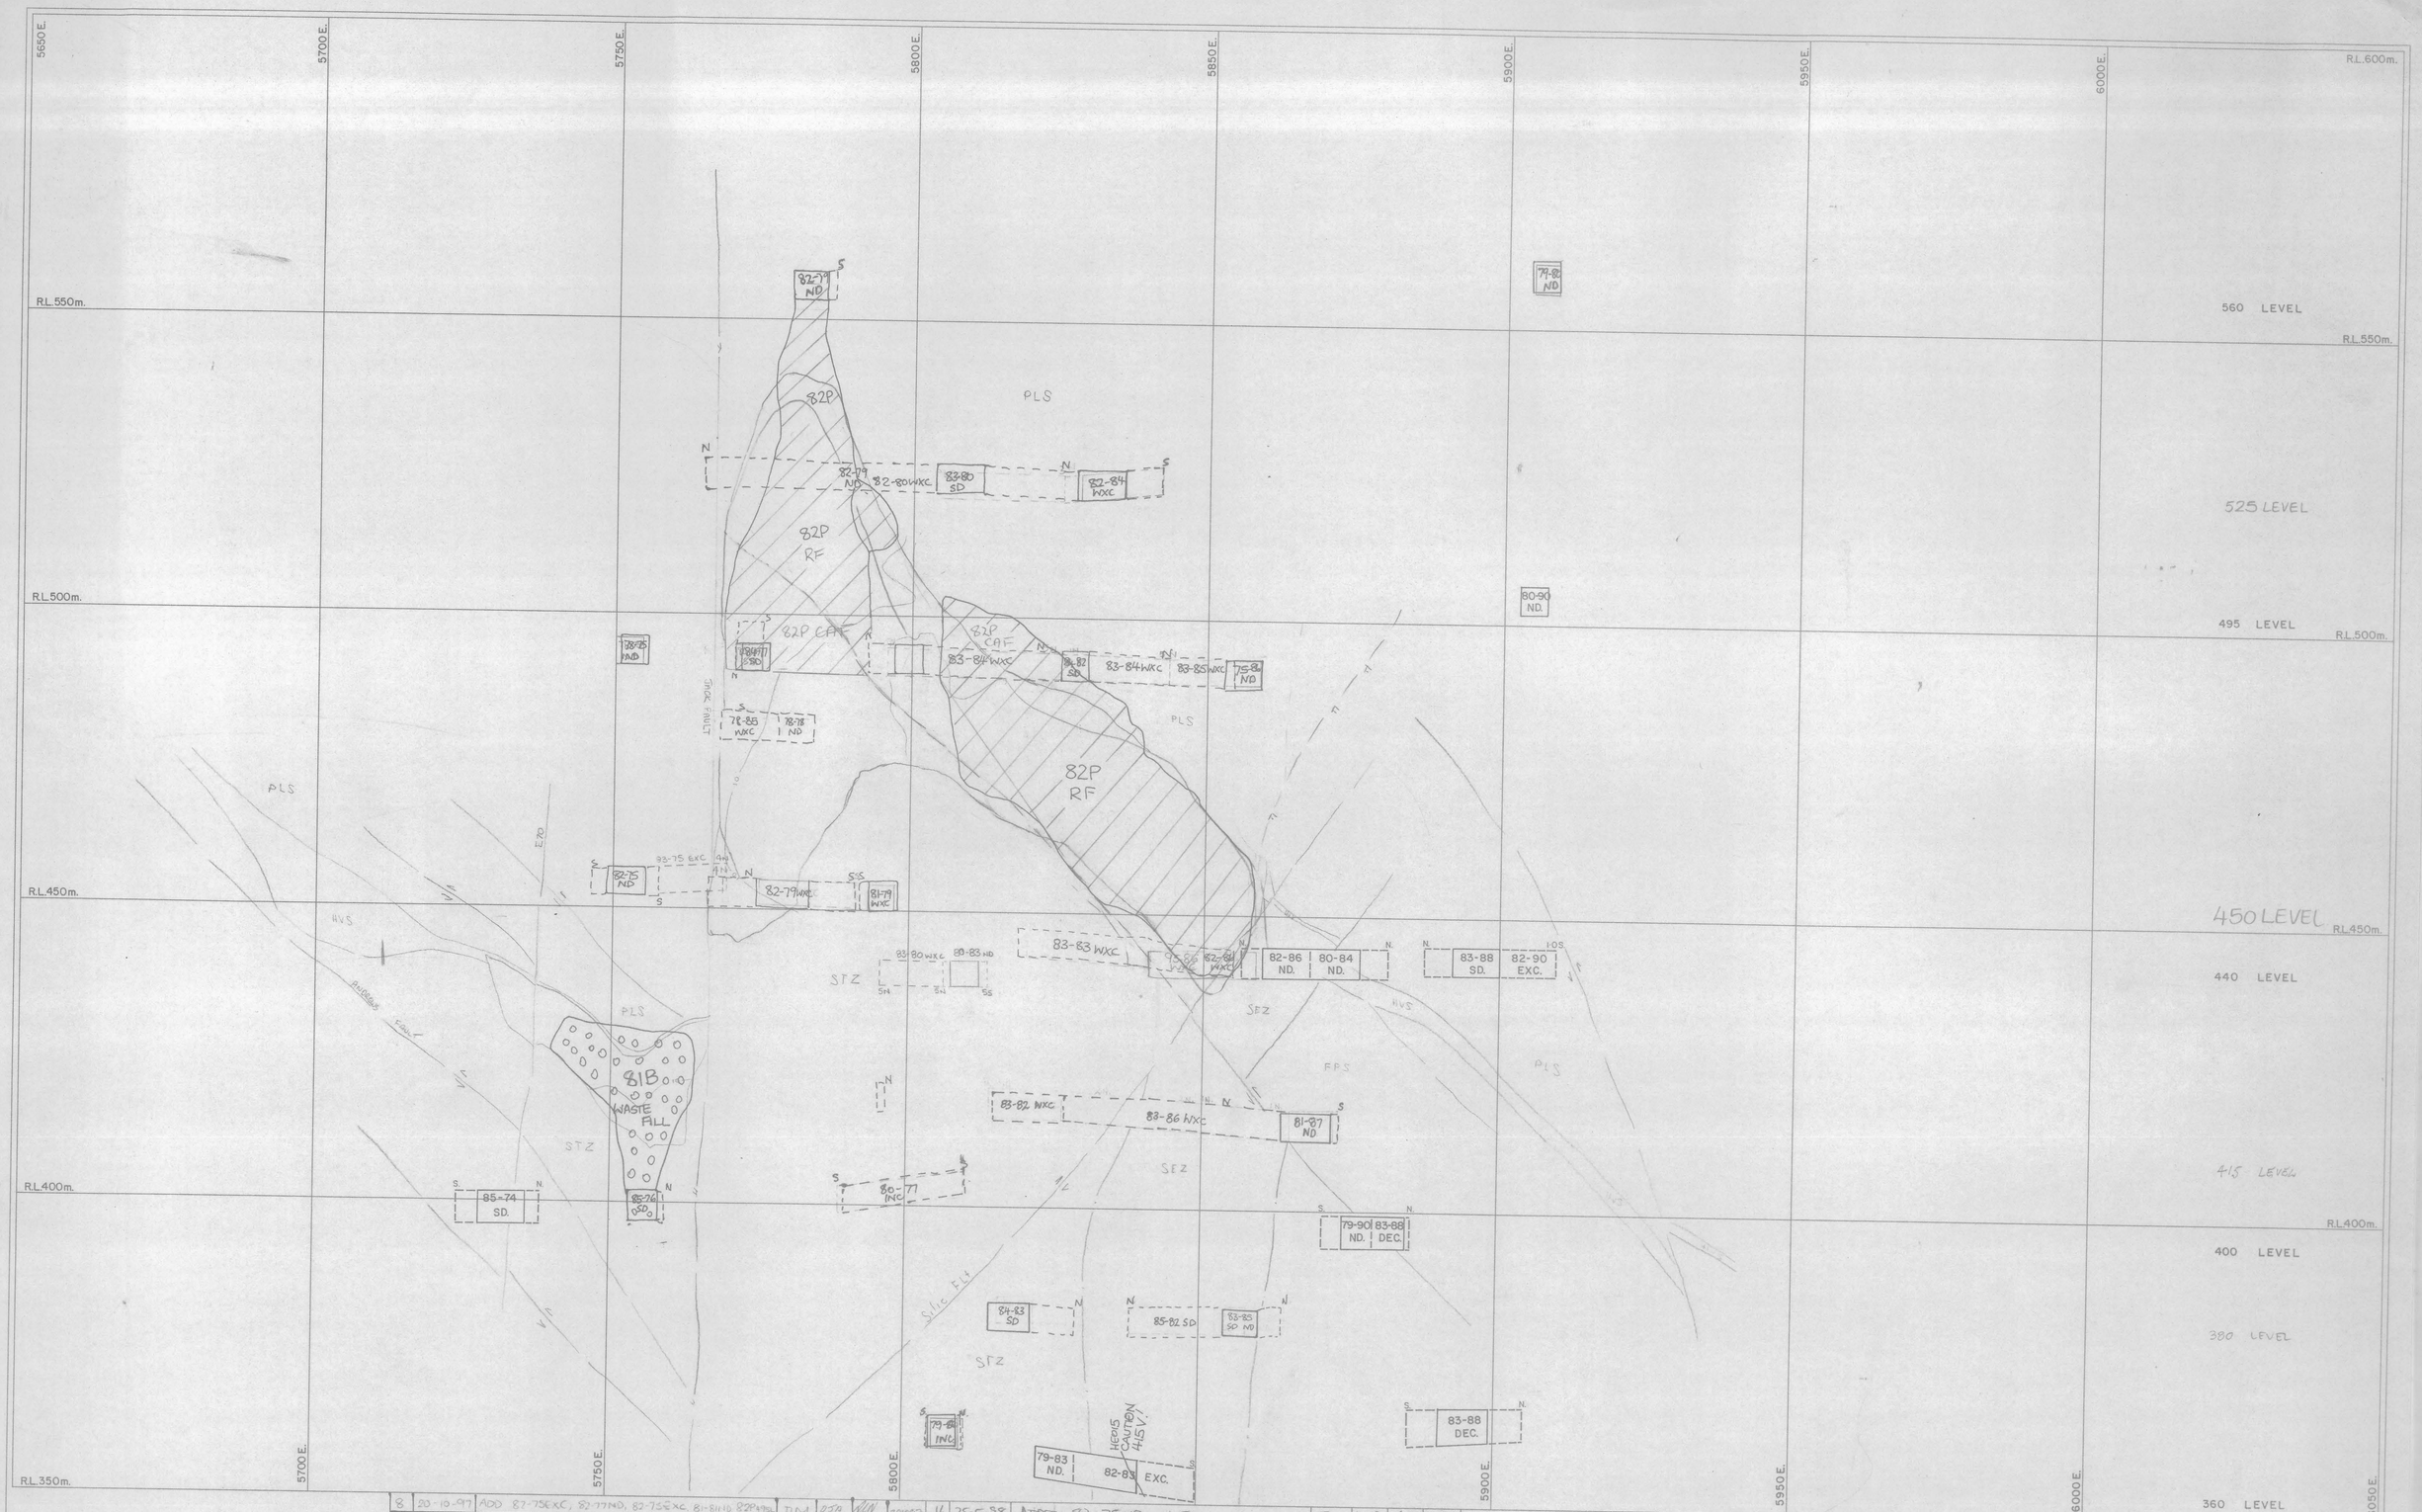

REV	DATE	REVISION	DRAWN	CKD	APP	APP
8	20-10-97	ADD 82-75EXC, 82-77ND, 82-75EXC, 81-81ND, 82P495L	TLM	DSA		
9	7-11-97	CHANGE 495L DEVT 82P	TLM	DSA		
10	10-11-97	UPDATE OREBODY OUTLINE	GMD			
11	12-11-97	ADD 81-80E, 82 84 N 450L, 81-77N 525L, 81-78N 560L 82P	TLM	DSA		
12	1-12-97	ADDED 82-86 WXC 440L 83-79 WXC 525L 82P	KDP	TLM		
13	28-1-98	CHANGE ALL LEVELS 82P	TLM	DSH		
14	20-3-98	LENGTHENED 82-86 WXC 440L	R.W	TLM		
15	23-3-98	ADD 85-76SD 400L	DSA	TLM		
16	25-5-98	ADDED 82-75 ND 415L	JMH	KDP		
17	04 06 98	UPDATED 82-77 ND, 83-80 SD	RW	KDP		
18	14 07 98	UPDATED 82-79 ND 82-80 WXC	RW	TLM		
19	10.12.98	ADD 83-75EXC 84A 450L / 82-78 WXC 84A 495L	RW	TLM		
20	23.12.98	ADD 80-83 ND 86P 440L & 83-80 WXC	RW			
6	2-8-96	ADD 83-82 WXC 82-86 WXC 525L, 78-78SD & 84-77SD & 83-84WXC & 84-87SD & 82-85 WXC & 75-88 ND & CHANGED 450L	TLM	DSH		
7	11-7-97	ADD 83-83 WXC DSA 440L	TLM	WJO		

NORTH

SCALE 1:500

SHEET No.

DRAWN		
CHECKED		
DESIGNED		
DESIGN CKD		
DESIGN APP		
PROJECT APP		

Aberfoyle Resources Limited
HELLYER DIVISION

DEVELOPMENT DESIGN
SECTION 10830N – 2

DRAWING No.

REVISION

0406 – 314