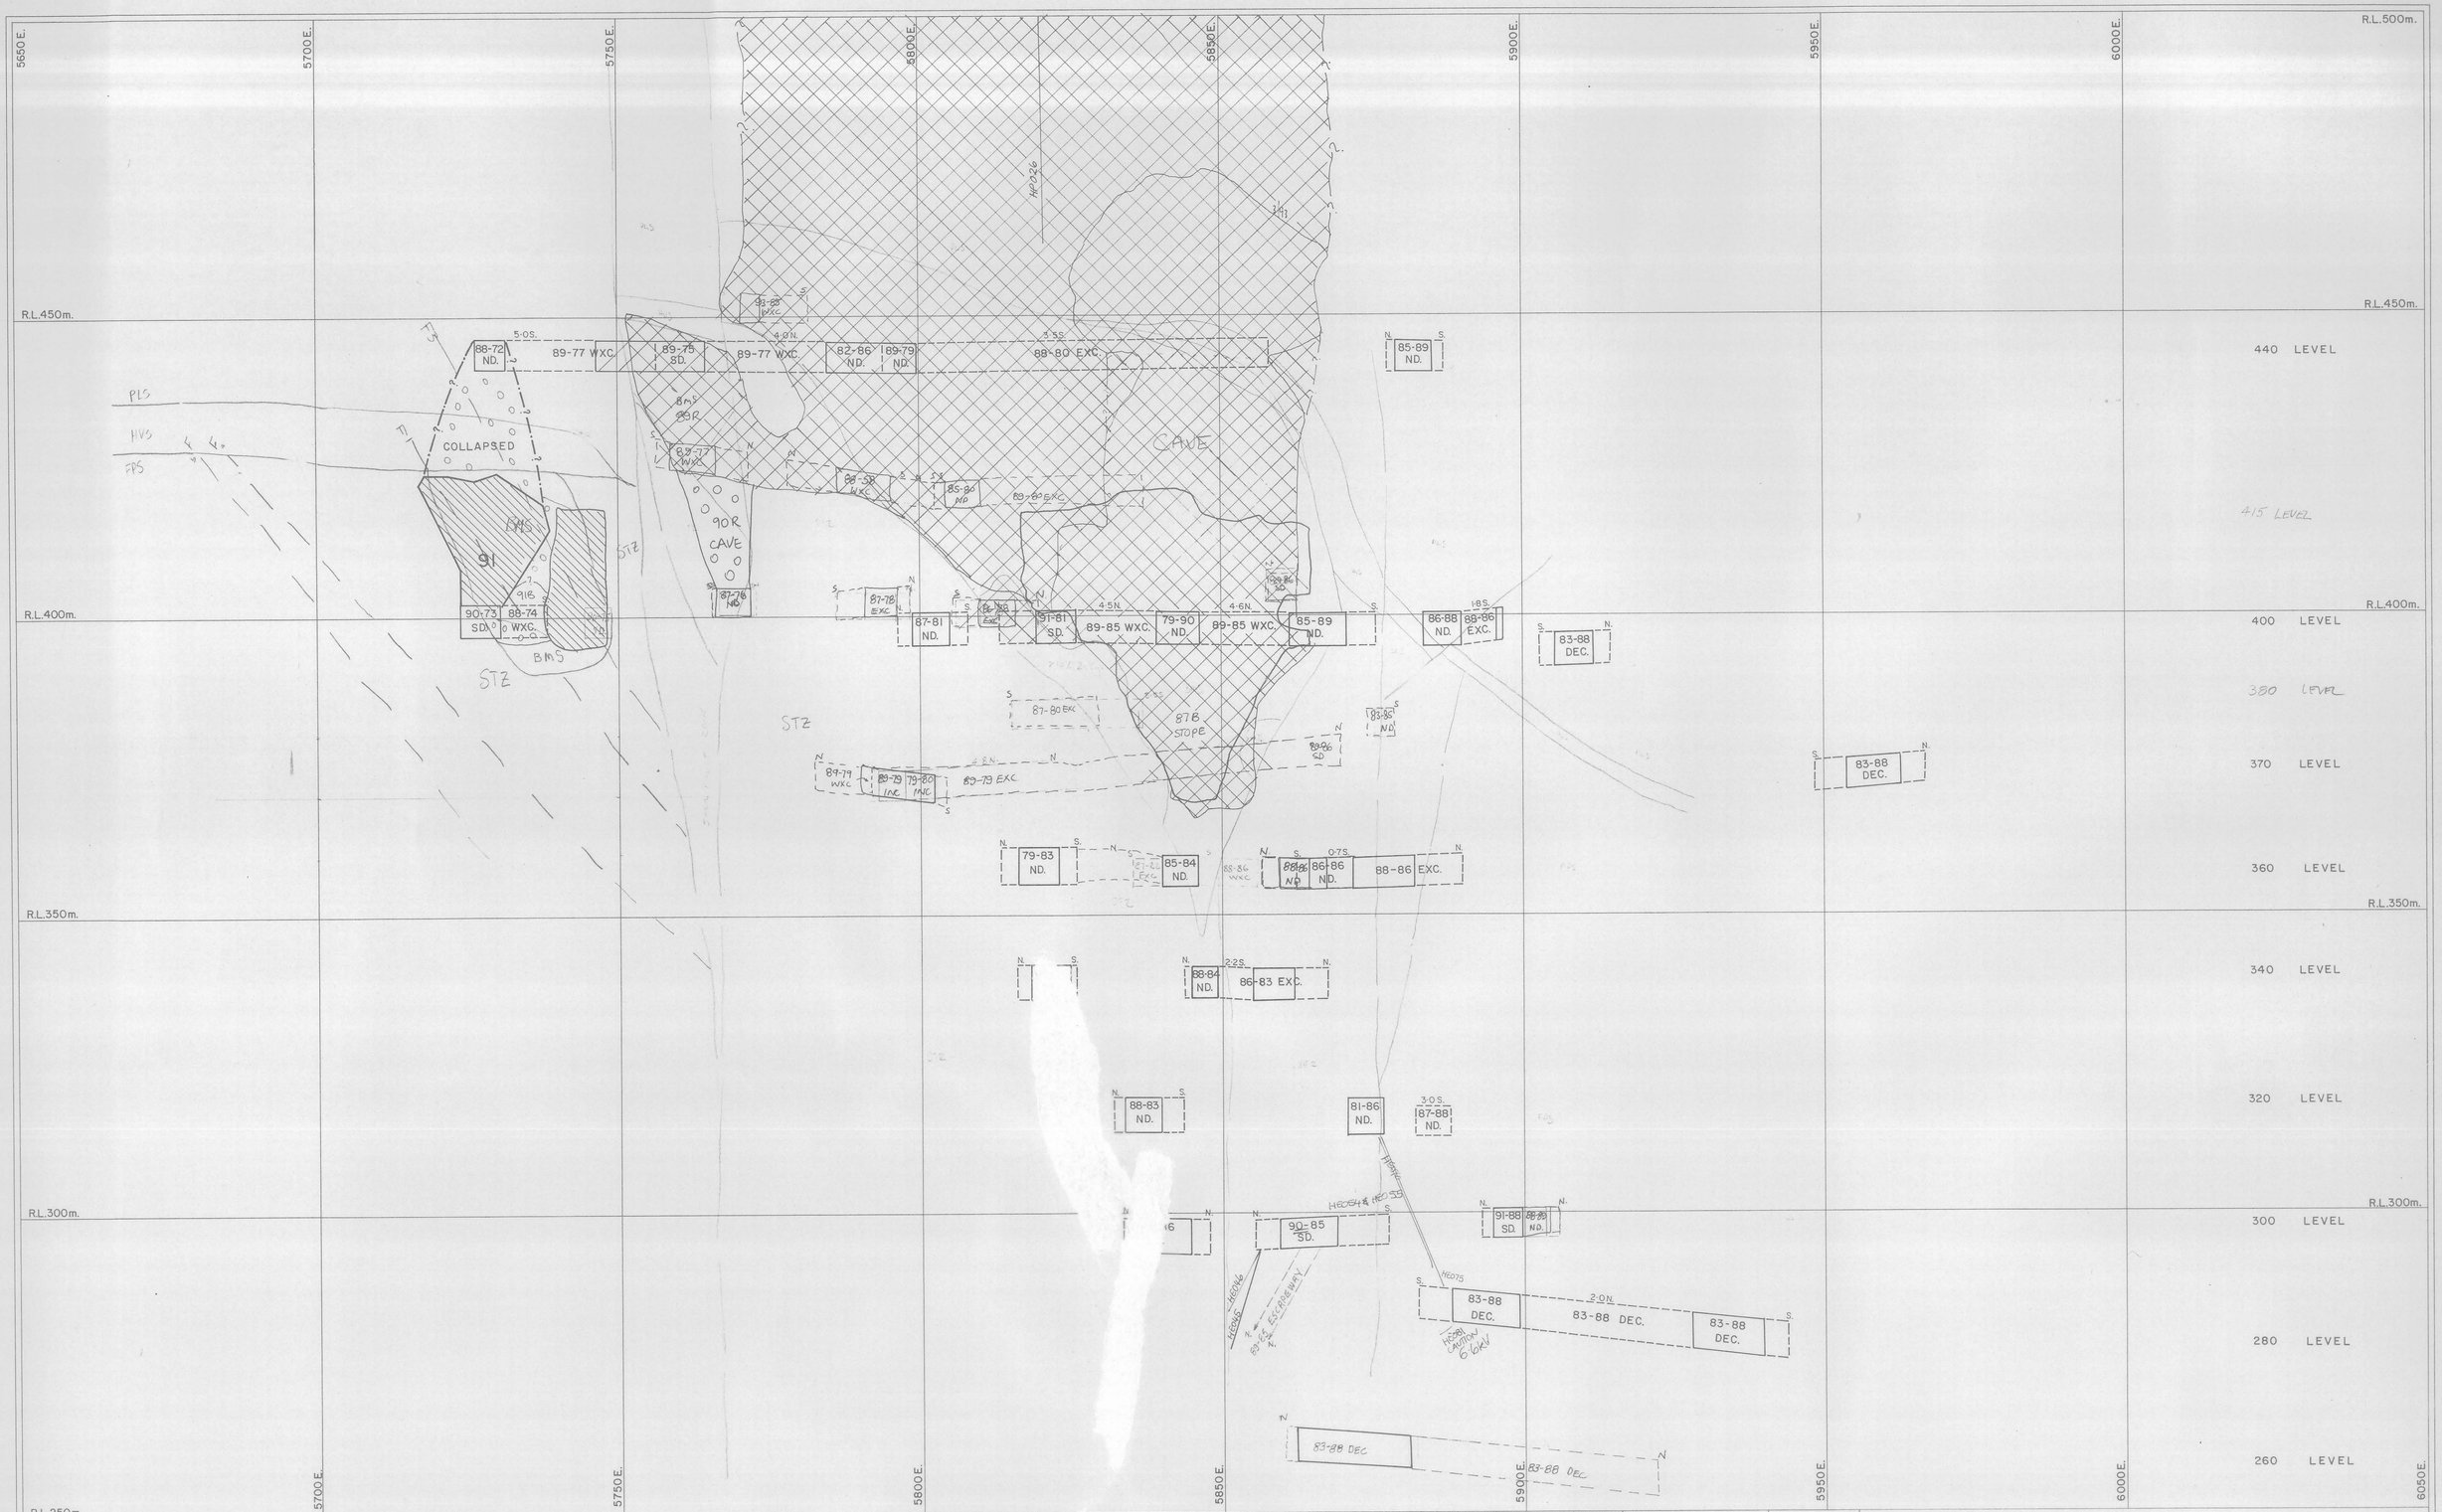

REV	DATE	REVISION	DRAWN	CKD	APP	APP
7	7/9/93	Added 89-86 SD 370L	GGM	GN		28993
8	28/9/93	Added 89-86 SD 400L	GGM	GN		28993
9	26/3/96	UPDATE HED54, HED55	TLM			
10	19/5/97	ADD HED75, 76 370L ELEC CABLE HOLES	TLM			
11	19/10/99	ADD 89-79WXC 370L 91B	TLM	DW		221099
12	13/2/99	ADDED 87-76 ND 400L	KDP	RW		14/2/99
6	2/7/93	89-77, 88-88, 88-86, 89-80 WXC; 89-79 EXC; 87-78 EXC; 87-80 EXC; 87-81 EXC; 88-86 EXC	AD			

7 25/09/96 91B GEOLOGY UPDATED RDM

NORTH

SCALE	1 : 500
SHEET No.	
DRAWN	
CHECKED	
DESIGNED	
DESIGN CKD	
DESIGN APP	
PROJECT APP	

Aberfoyle Resources Limited
HELLYER DIVISION

DEVELOPMENT DESIGN
SECTION 10890N - 1

DRAWING No.

5 cm

0406-3278