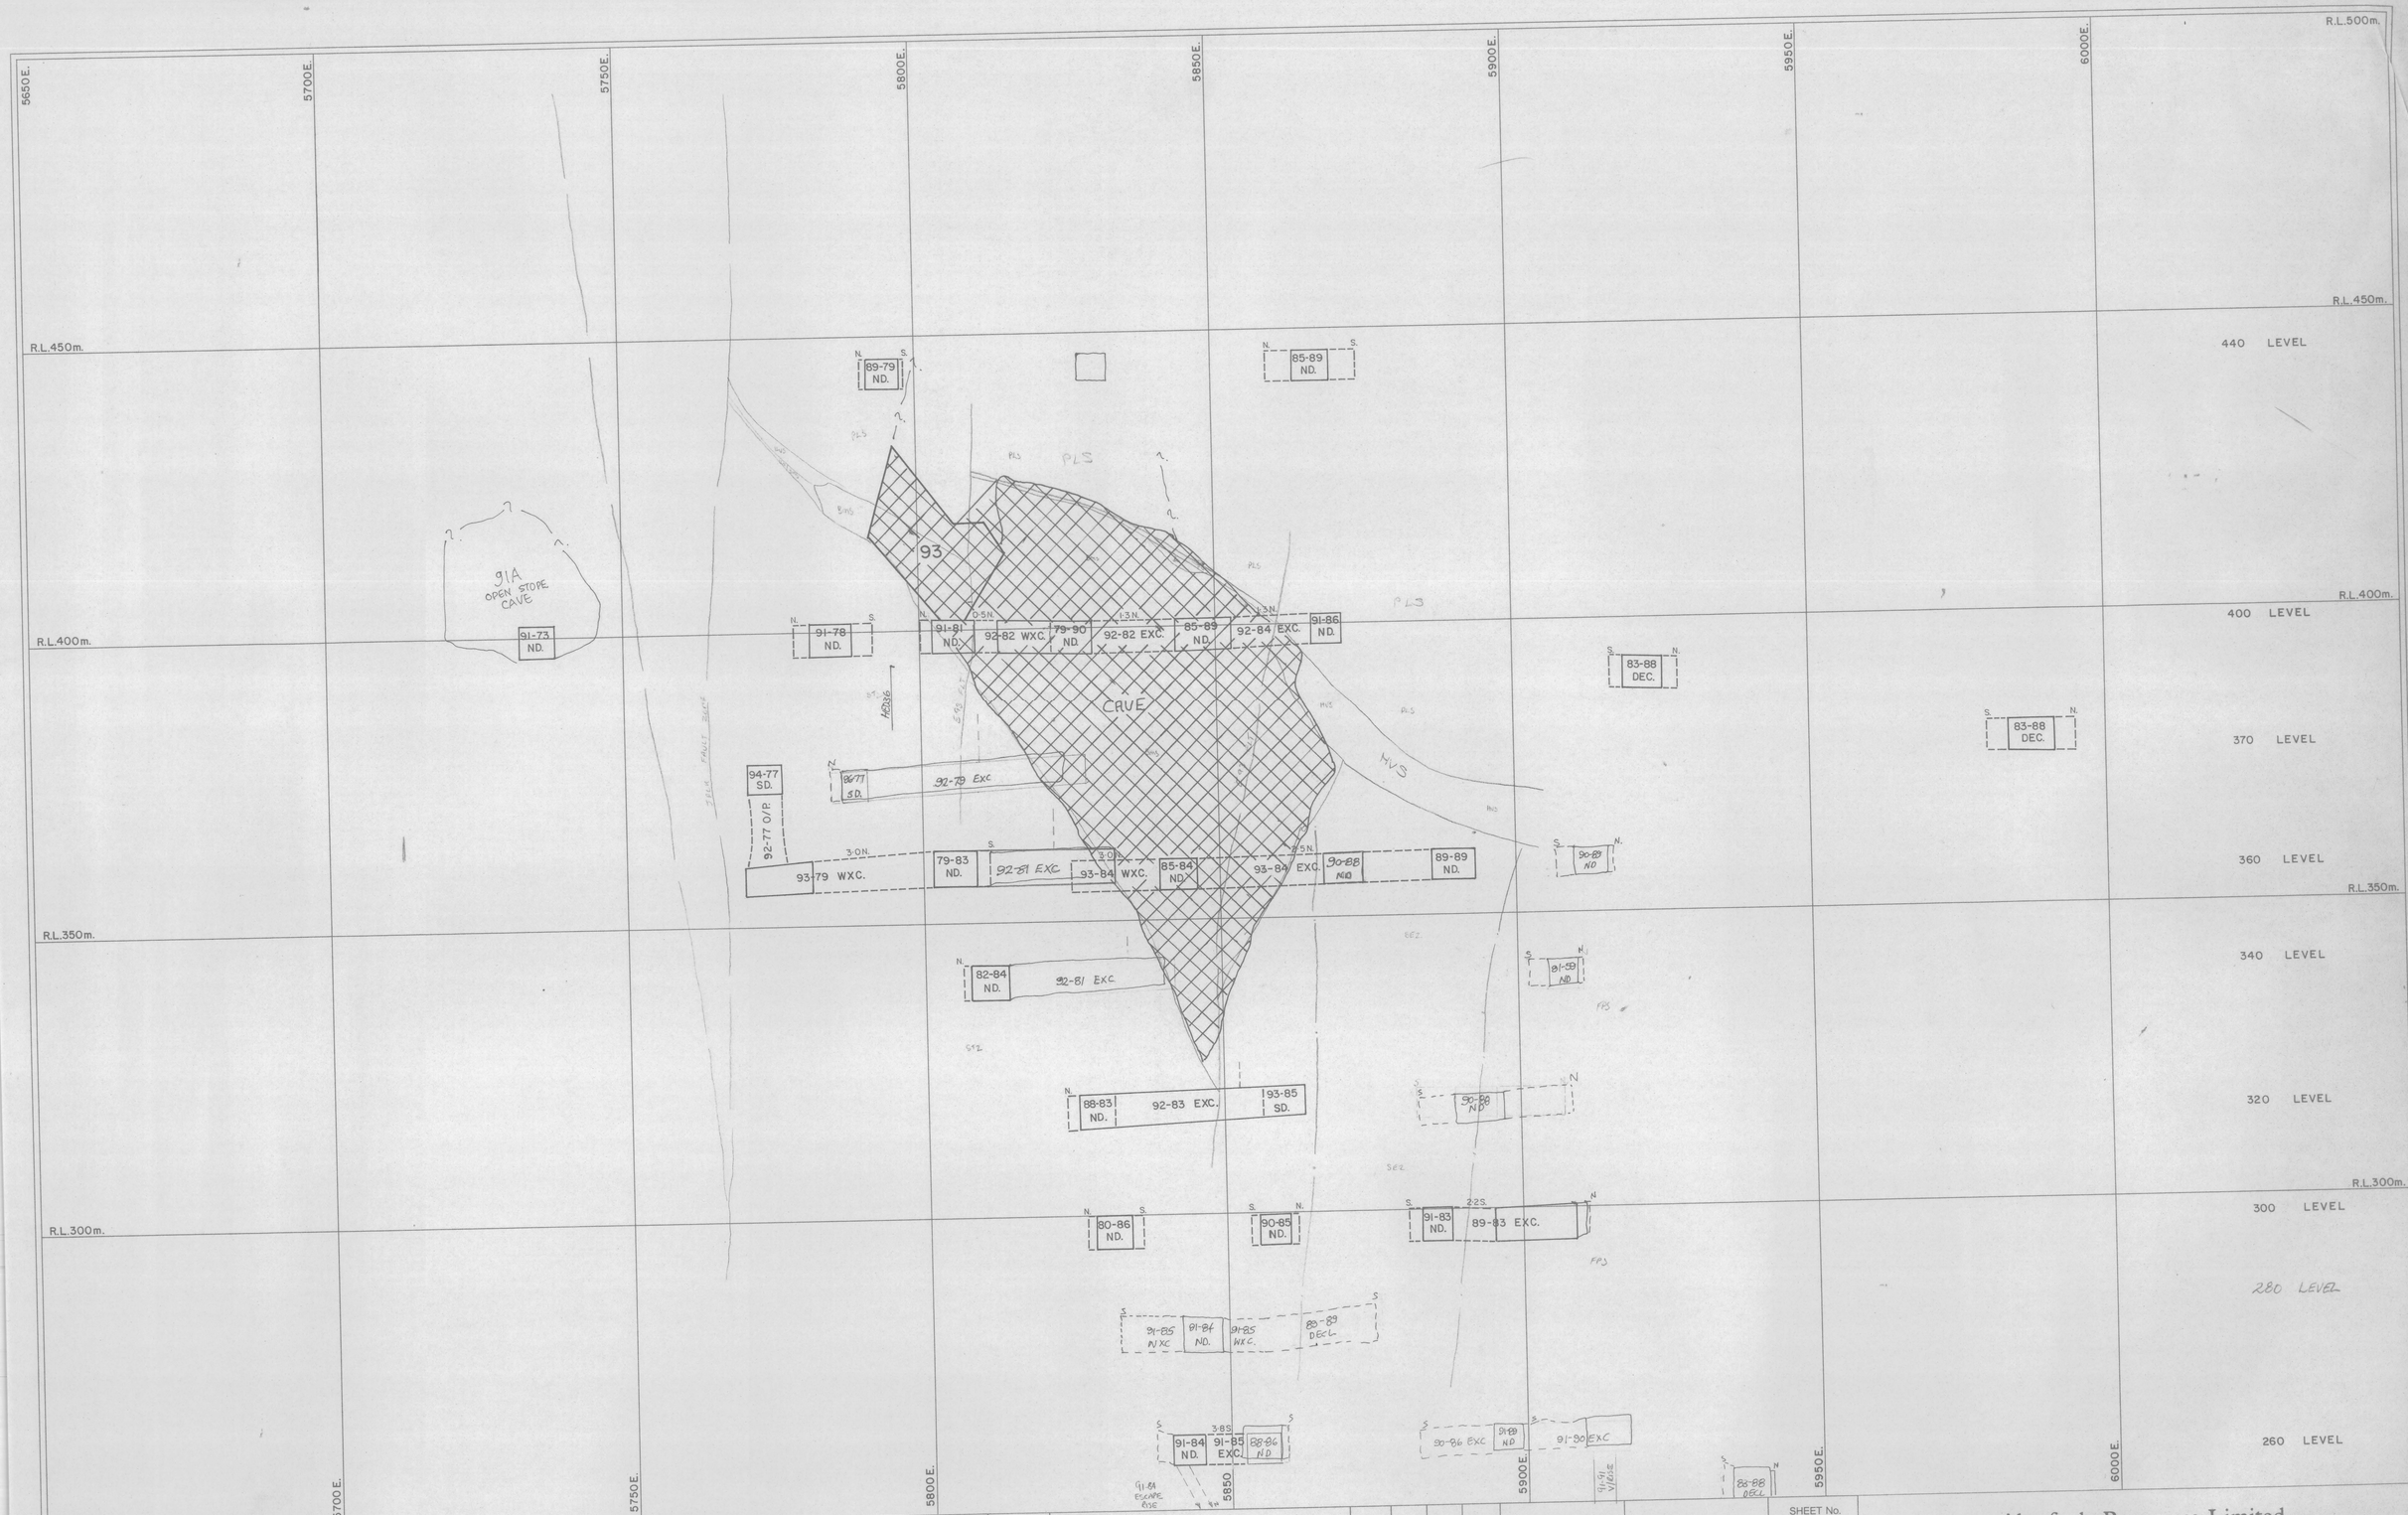

REV	DATE	REVISION	DRAWN	CKD	APP	APP
1	7-11-91	GEOLOGY	GEO			
2	6/11/92	Added 260/L 280/L 91-89 ND 340/L · 83-88 Decl	PR	GGM		
3	15/11/93	UPDATE	RR			
4	29/9/94	ADD 360/L 90-89 ND	WTS			

NORTH

SCALE	1 : 500
SHEET No.	
DRAWN	
CHECKED	
DESIGNED	
DESIGN CKD	
DESIGN APP	
PROJECT APP	

Aberfoyle Resources Limited
HELLYER DIVISION

DEVELOPMENT DESIGN
SECTION 10920N – 1

DRAWING No.

5 cm

0406 – 332