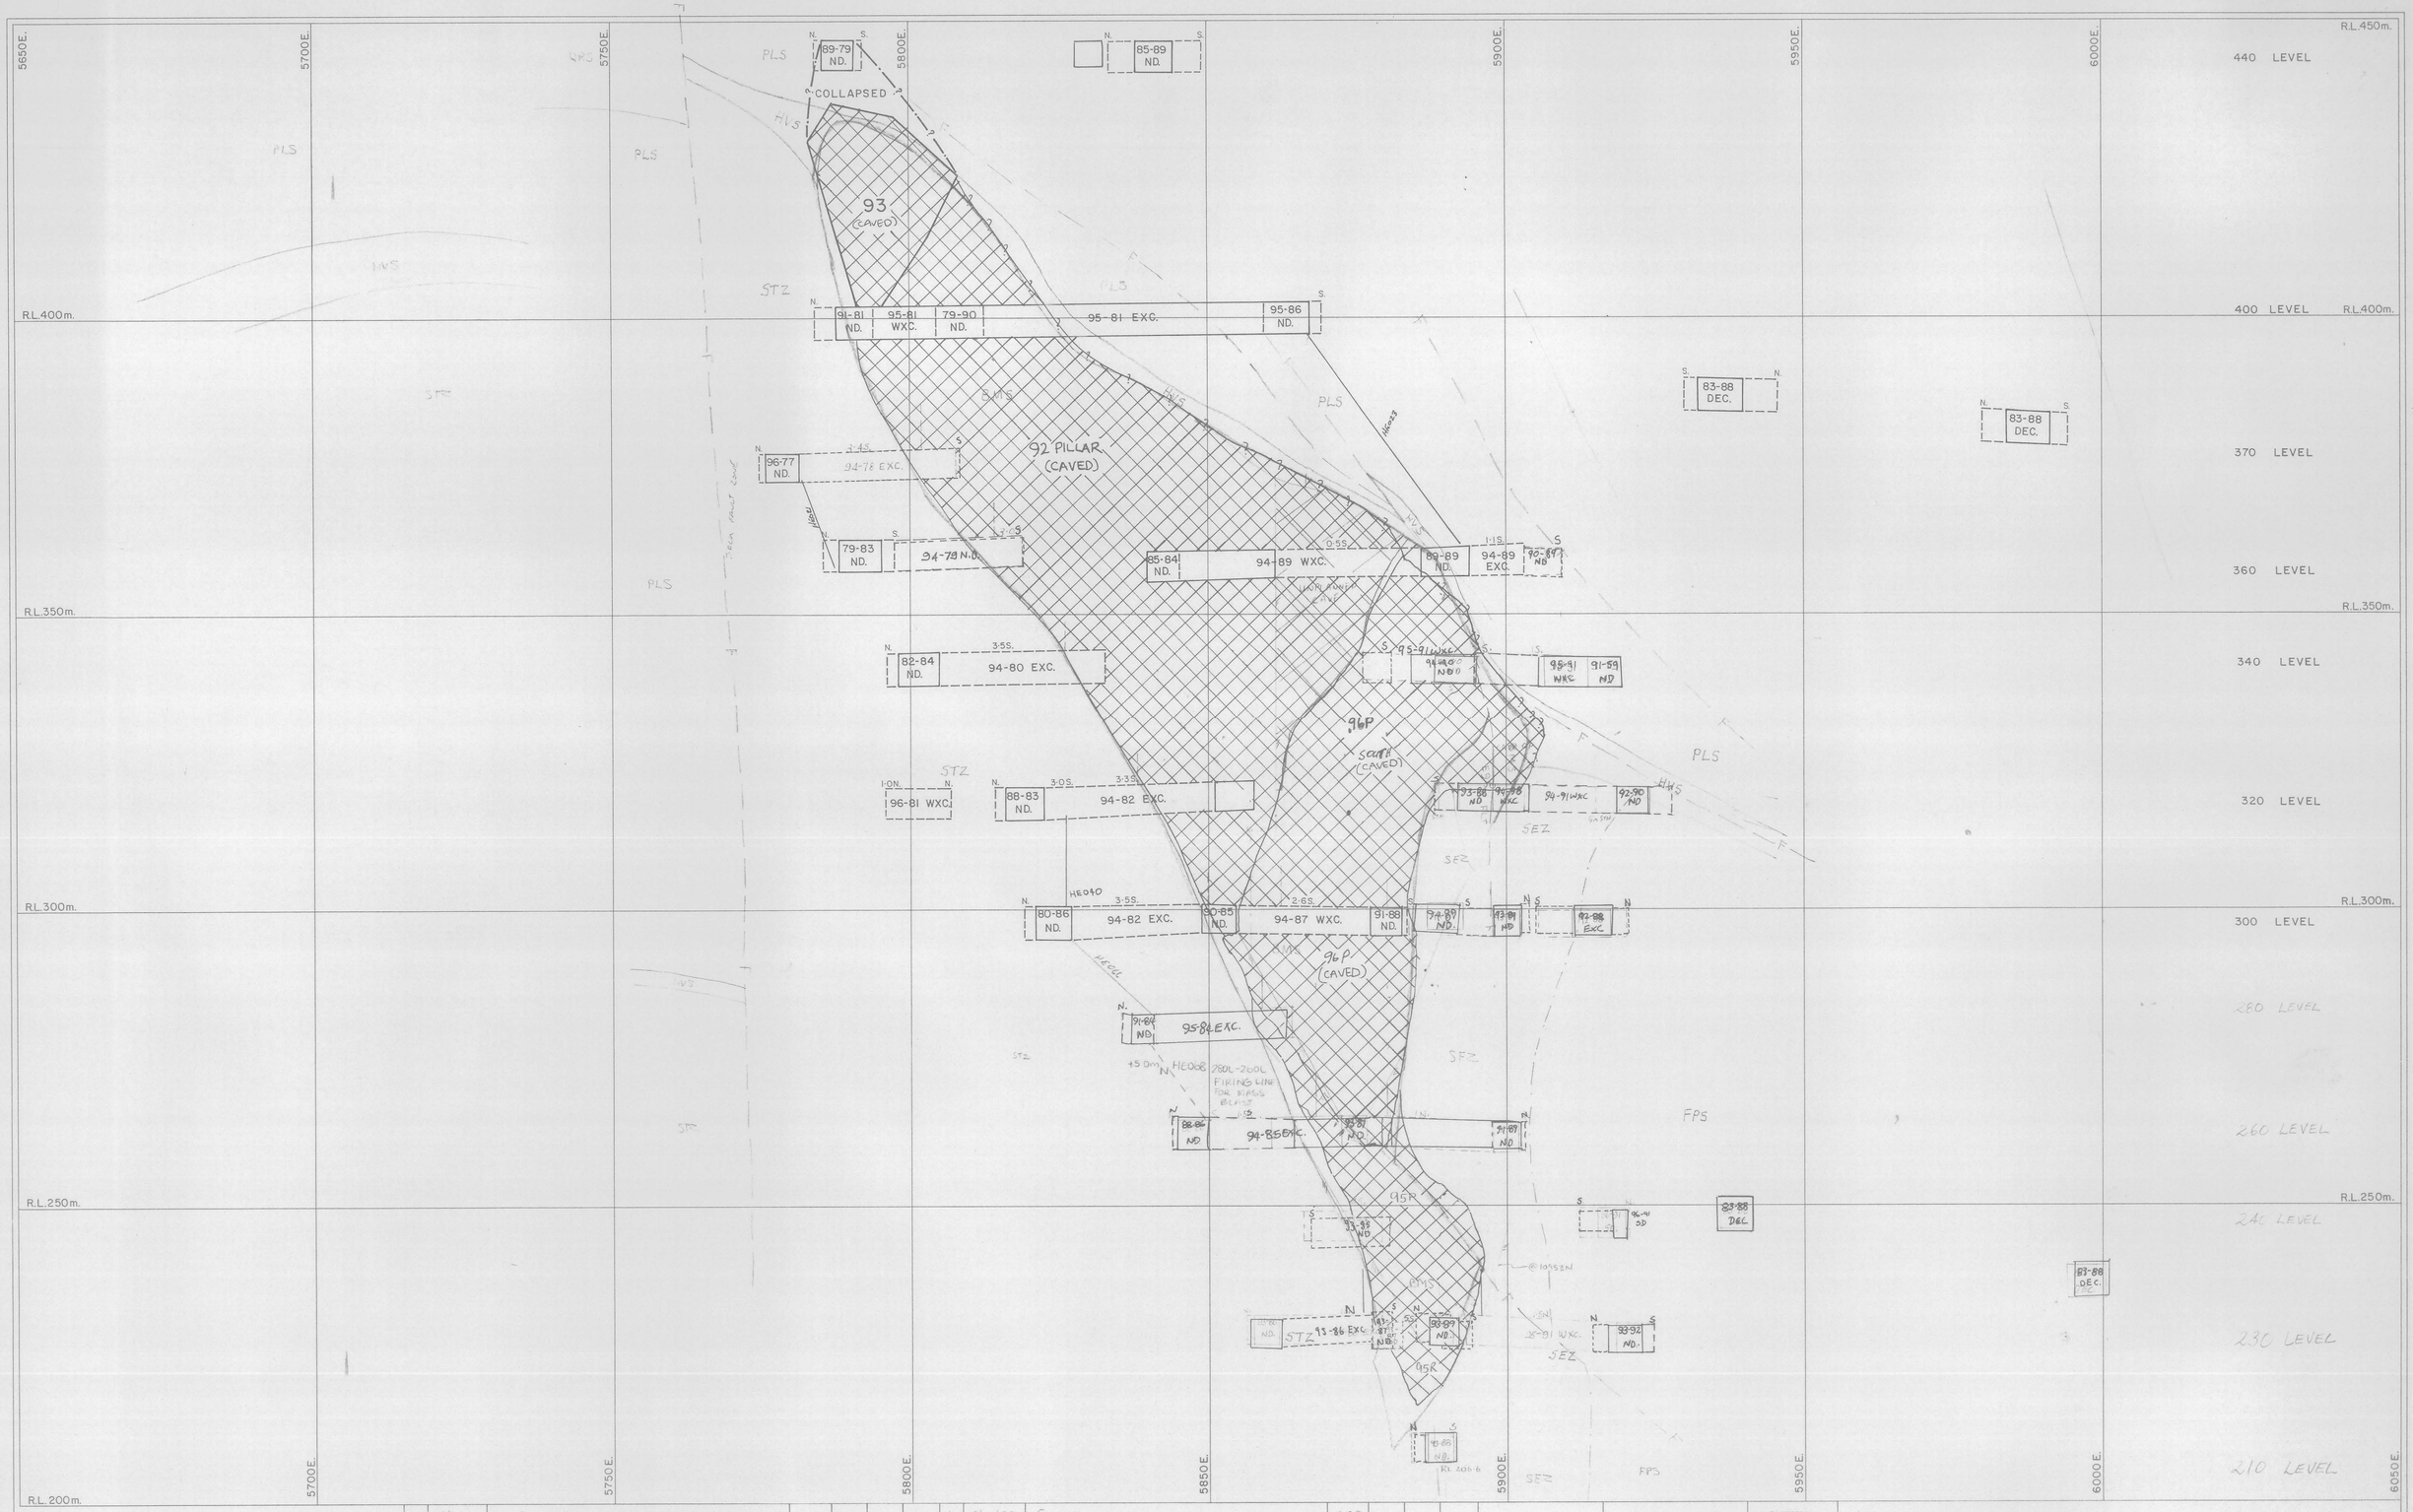

REV	DATE	REVISION	DRAWN	CKD	APP	APP
7	8/7/95	ADD 320L 93-85 ND, 93-90 ND, 94-91 WXC, CAVE OR.	WTS	MWL		
8	14/7/95	ADD 94-90 ND, UNPLANNED CAVE OUTLINE, DELETE 93-87 ND 340L	WTS	AD		
9	28/2/96	MOD HE 068 CABLE HOLE 300 → 280L	DSN			
10	24/5/96	ADD HE068 CABLE HOLE 280L-260L	TJM	DSN		
11	16/7/96	ADD FOR CAVE OF MASS BLAST	RNB	TJM		
12	9/12/96	ALTER 93-88 ND 260L	WJO	DSN		
13	26/8/98	ADD 92-87 ND 280L	JMH	TJM		31/08/98

REV	DATE	REVISION	DRAWN	CKD	APP	APP
1	4/10/90	GEOLOGY	CGD			
2	18-11-91	GEOLOGY	GRH			
3	16-6-92	GEOLOGY	RCD			
4	14/6/92	GEOLOGY	RCD			
5	6/1/92	Added 95-91 91-59 340L, 320L 360L 240L 230L 210L	RR	GSM		
6	3/10/94	ADD 92-89 ND, 340L	WTS	MW		
7	12/10/94	ADD 320L 93-87 93-92 95-91 WXC	WTS			

NORTH

SCALE	1 : 500
SHEET No.	
DRAWN	
CHECKED	
DESIGNED	
DESIGN CKD	
DESIGN APP	
PROJECT APP	

Aberfoyle Resources Limited
HELLYER DIVISION

DEVELOPMENT DESIGN
SECTION 10950N

DRAWING No.

5 cm

0470-337