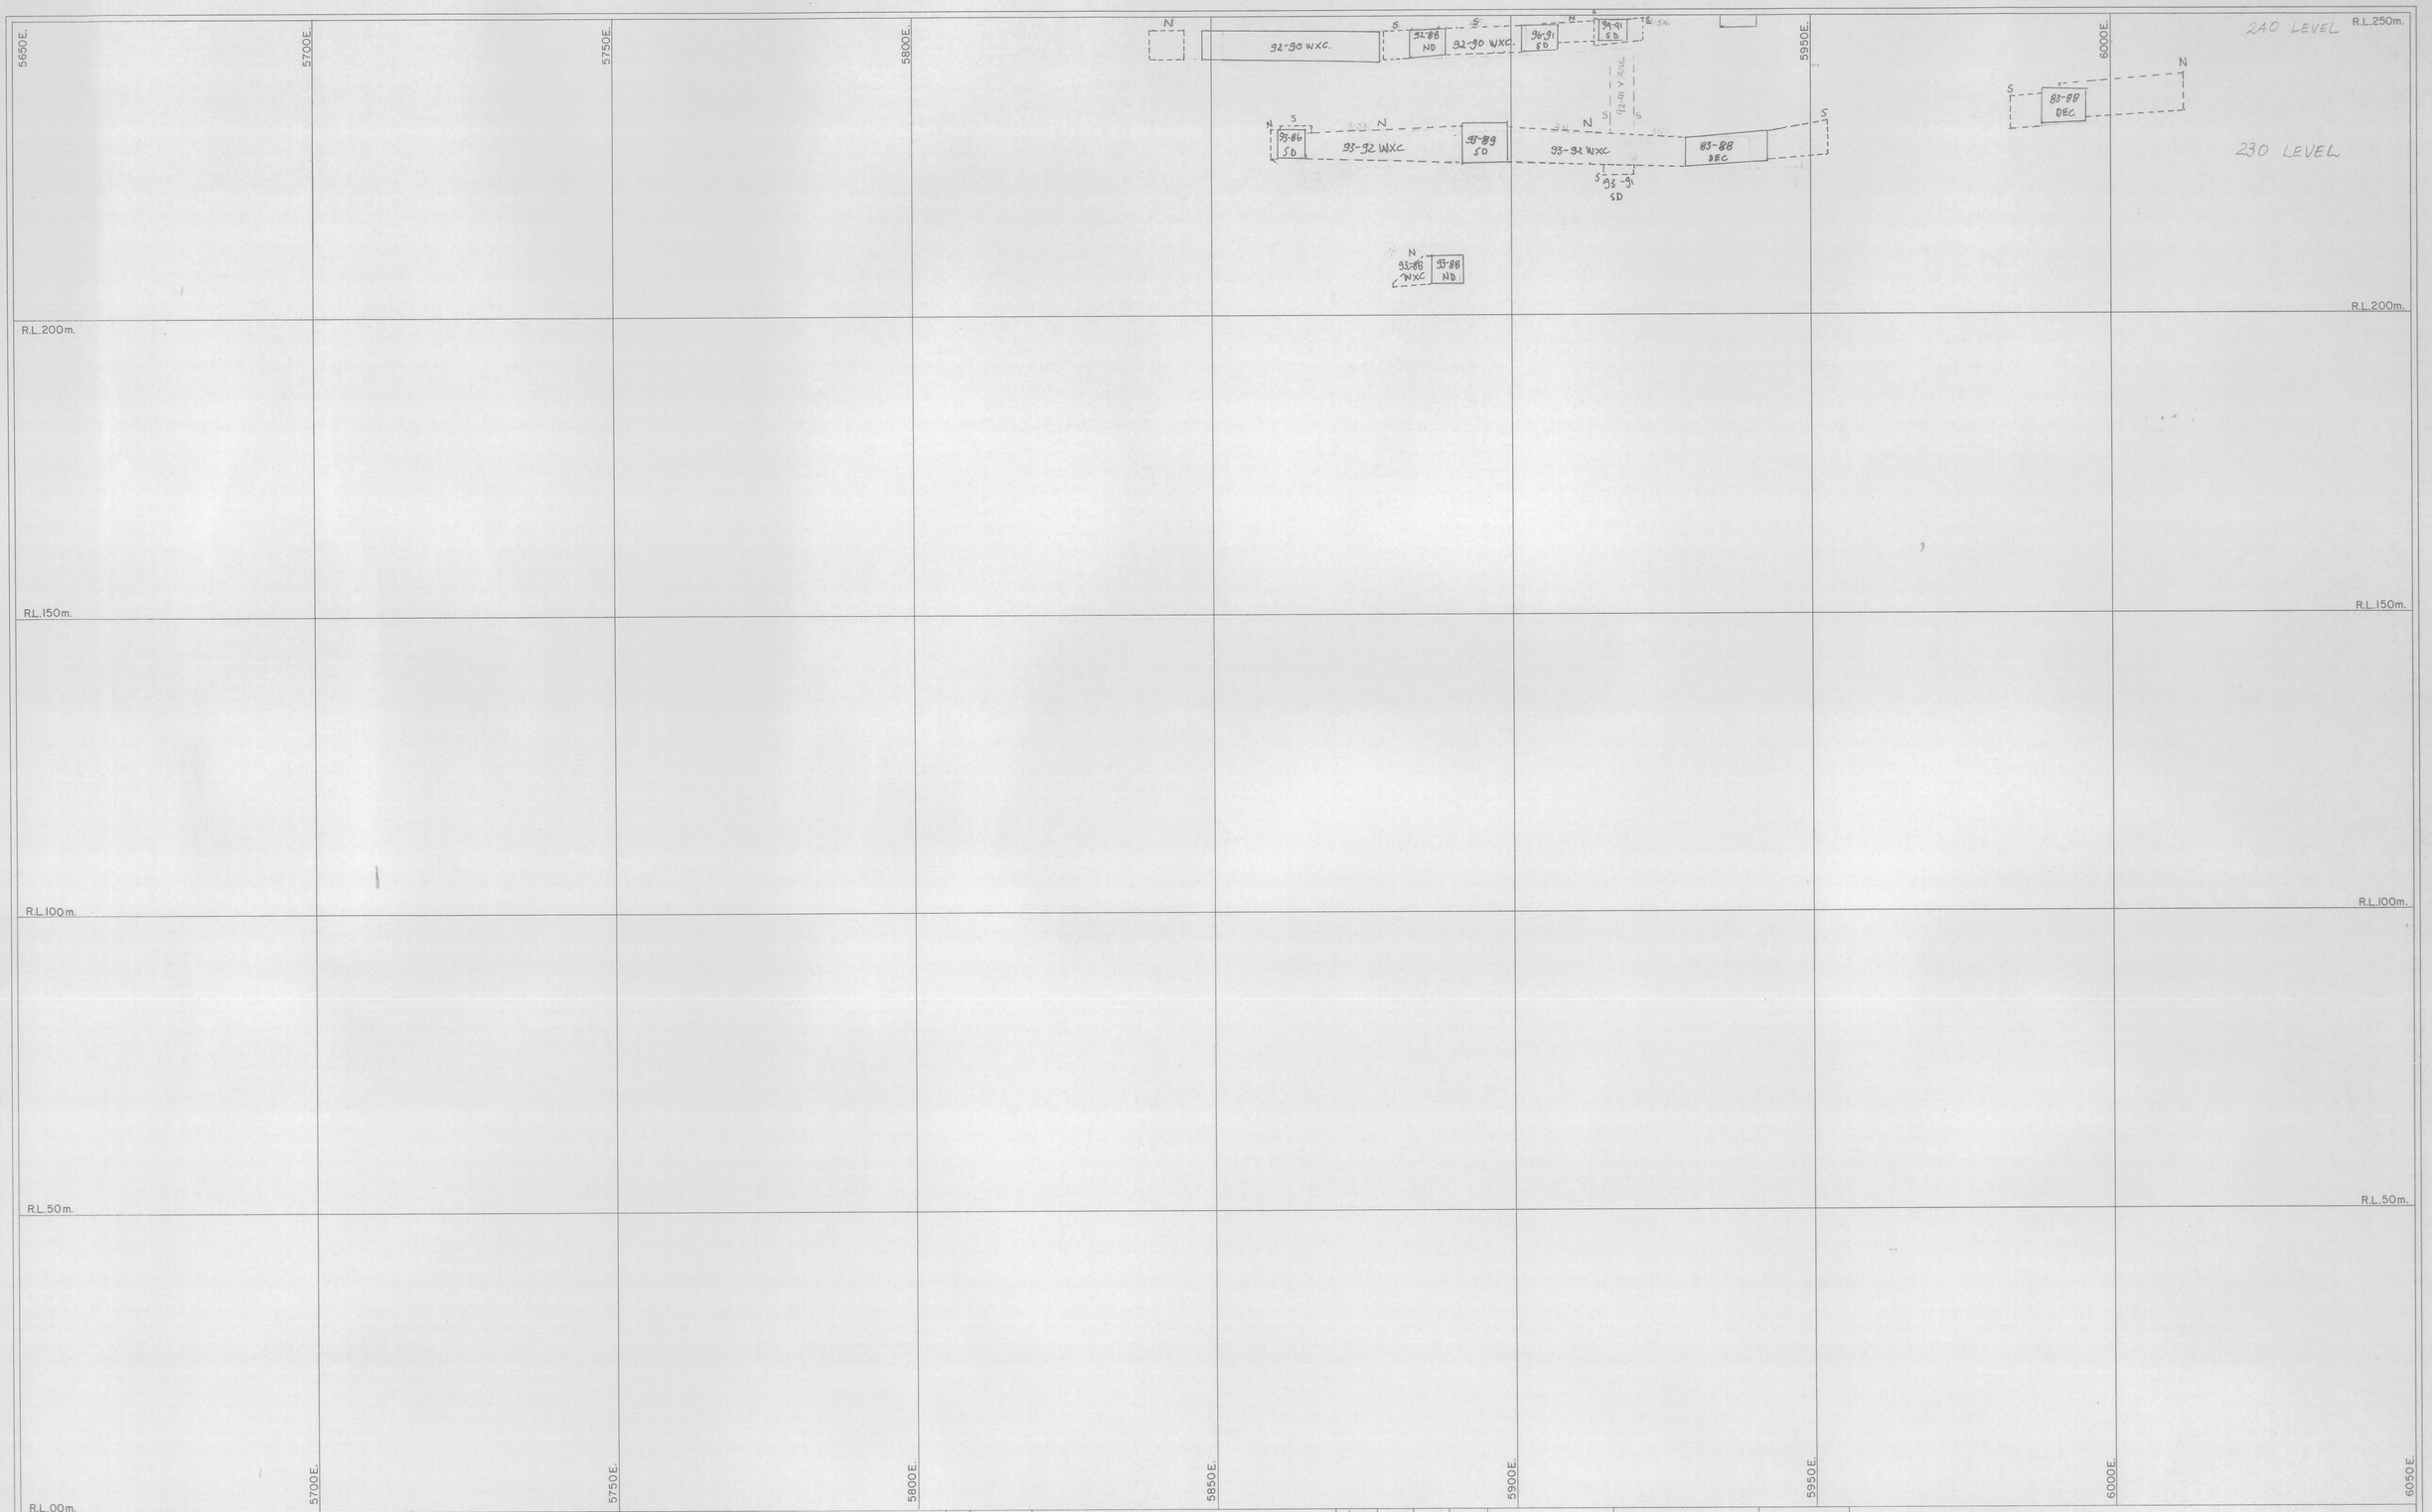

REV	DATE	REVISION	DRAWN	CKD	APP	APP
1	6/11/92	Added 280L, 230L + 210L	RR	GGM		

NORTH

SCALE 1:500

SHEET No.

DRAWN	
CHECKED	
DESIGNED	
DESIGN CKD	
DESIGN APP	
PROJECT APP	

Aberfoyle Resources Limited
HELLYER DIVISION

DEVELOPMENT DESIGN
SECTION 10930N

DRAWING No.

5 cm

0406 - 340