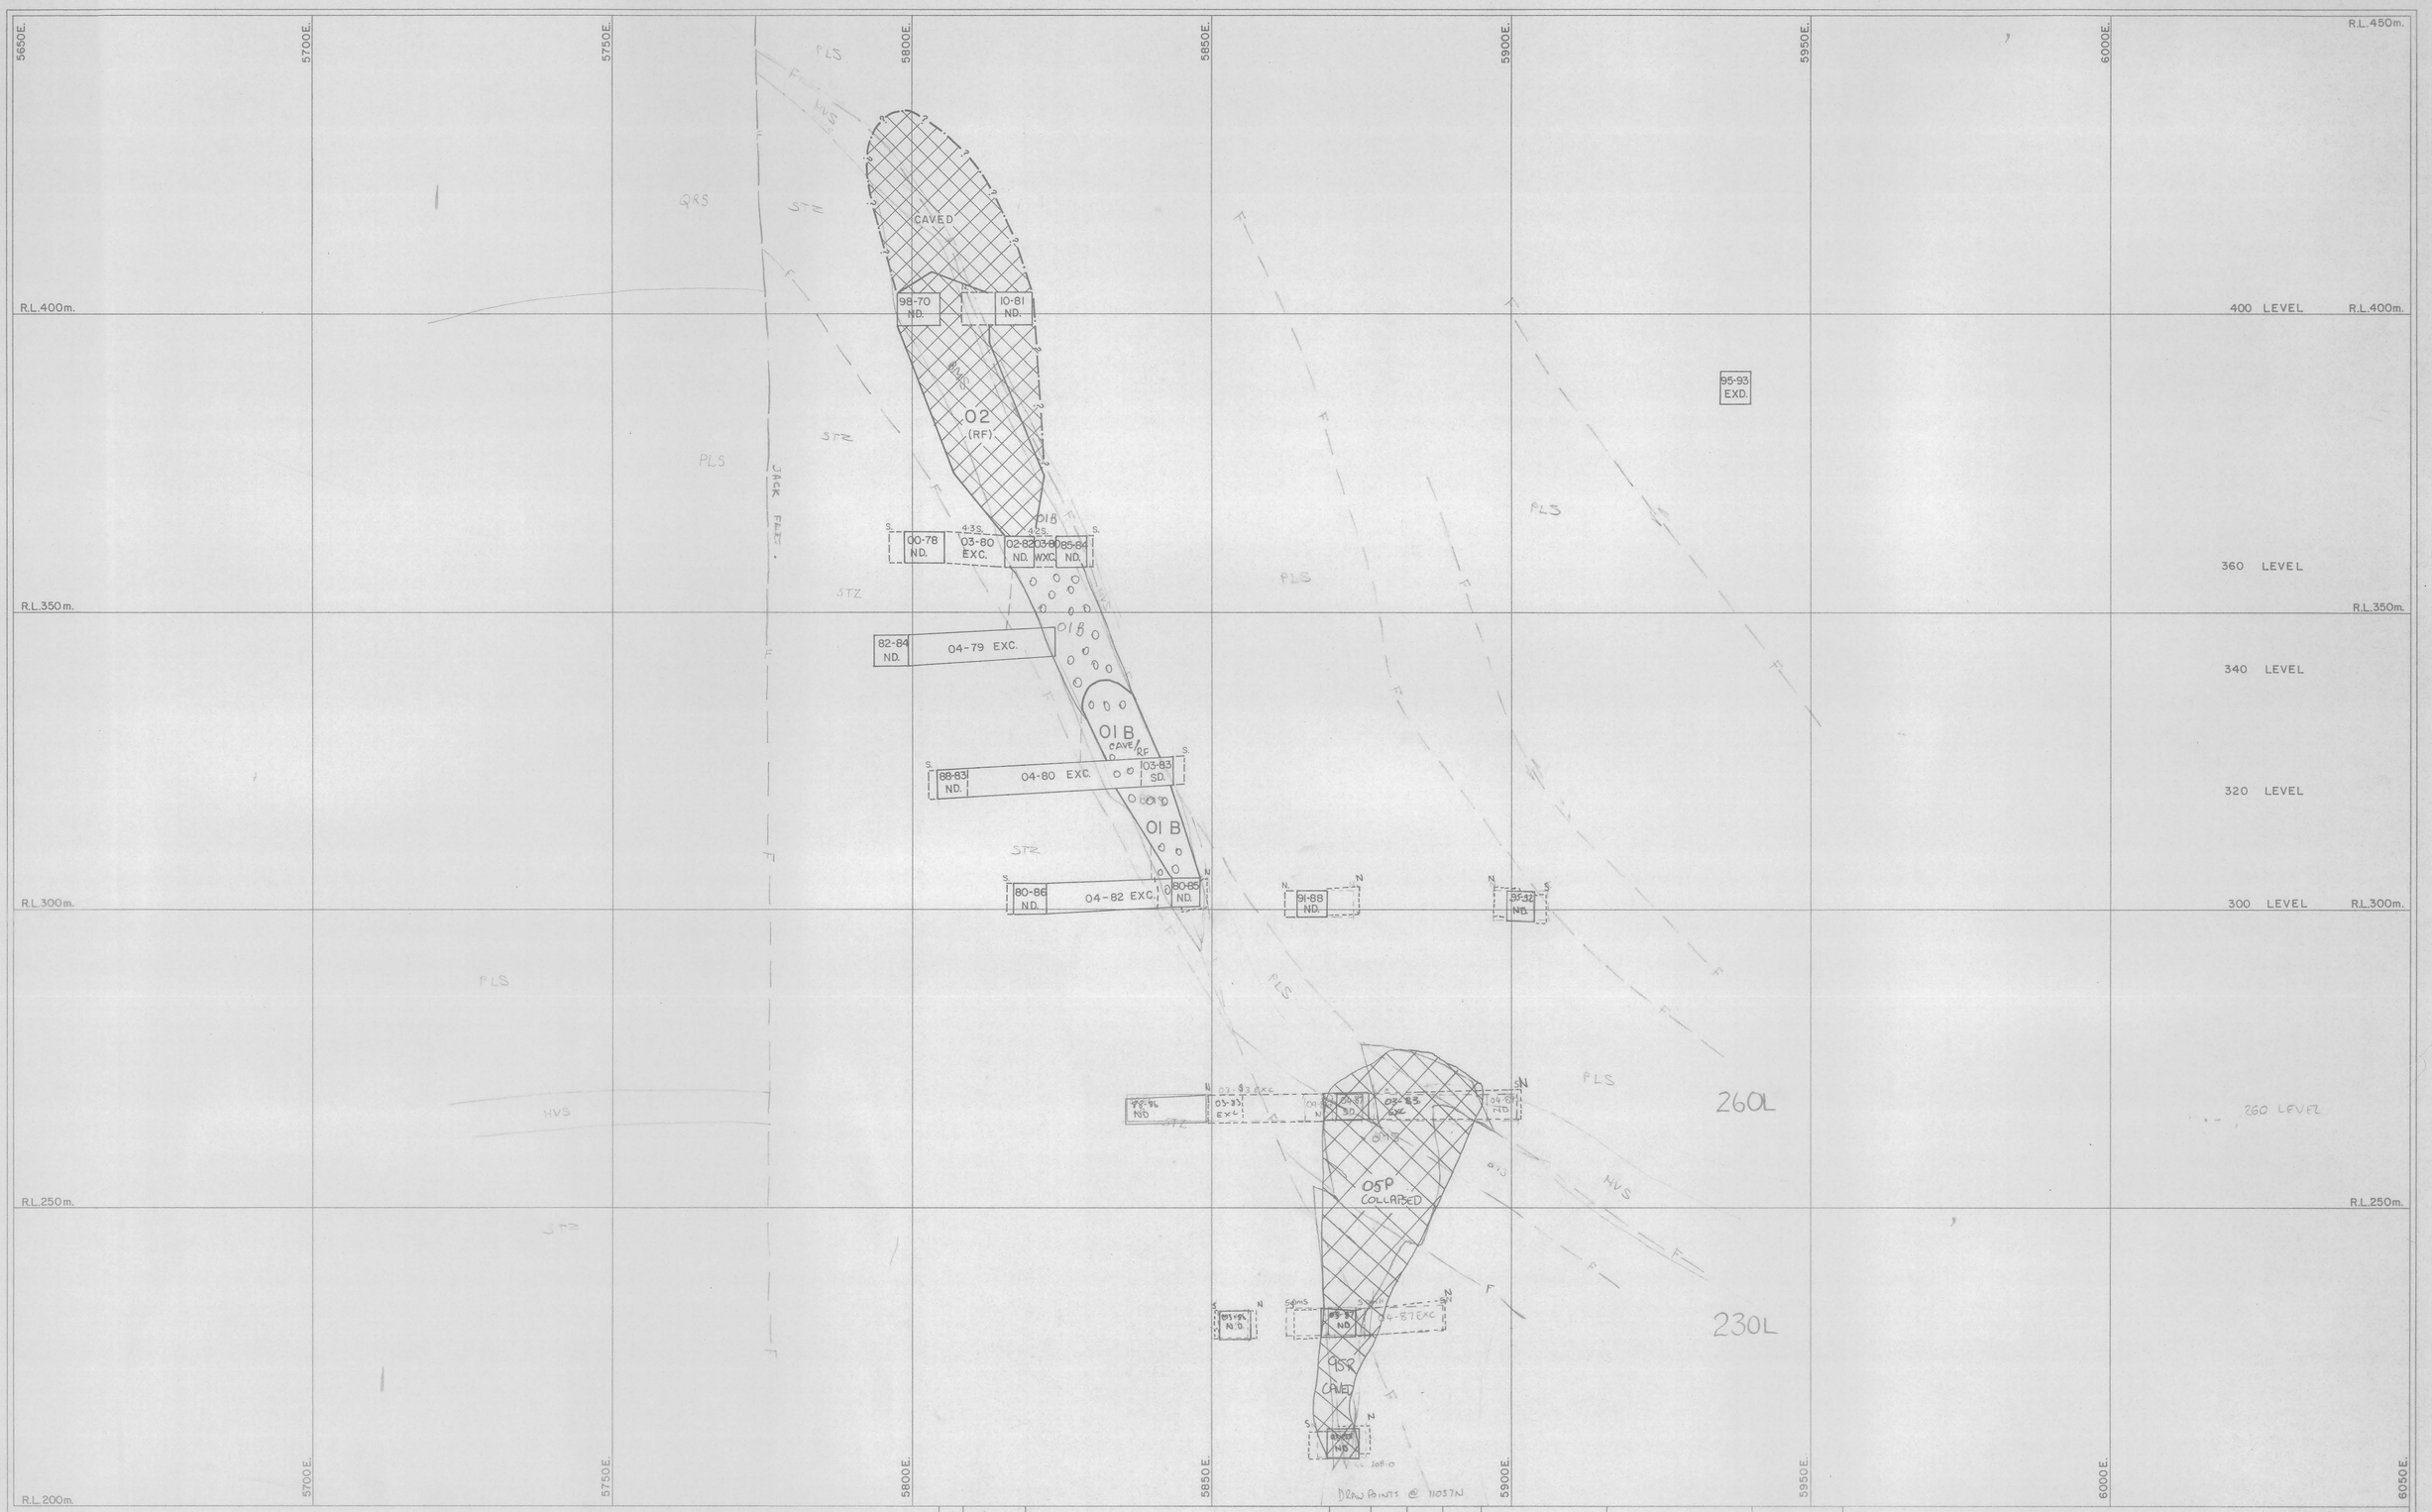

REV	DATE	REVISION	DRAWN	CKD	APP	APP
1	16/10/91	GEOLOGY	CGD			
2	27/4/92	Geology updated	RCD			
3	9/12/96	ADDED 93-88 ND	VJO	DJA		
4	13/8/95	UPDATE 260L	LJTC			
5	30/6/96	EXTEND 03-83EXC OS PILLAR 260L	TLM	DJA		
6	22/5/96	UPDATE 230L 03-87ND, ADD 04-86SD 05P	TLM	DJA		
7	18/11/96	ADD 04-81EXC 230L, 04-84ND 260L, EXTEND 03-83EXC 260L	TLM	DMS		

NORTH

SCALE 1 : 500	SHEET No.
DRAWN	
CHECKED	
DESIGNED	
DESIGN CKD	
DESIGN APP	
PROJECT APP	

Aberfoyle Resources Limited
HELLYER DIVISION

DEVELOPMENT DESIGN
SECTION 11040N

DRAWING No.

5 cm

0406 - 5 4