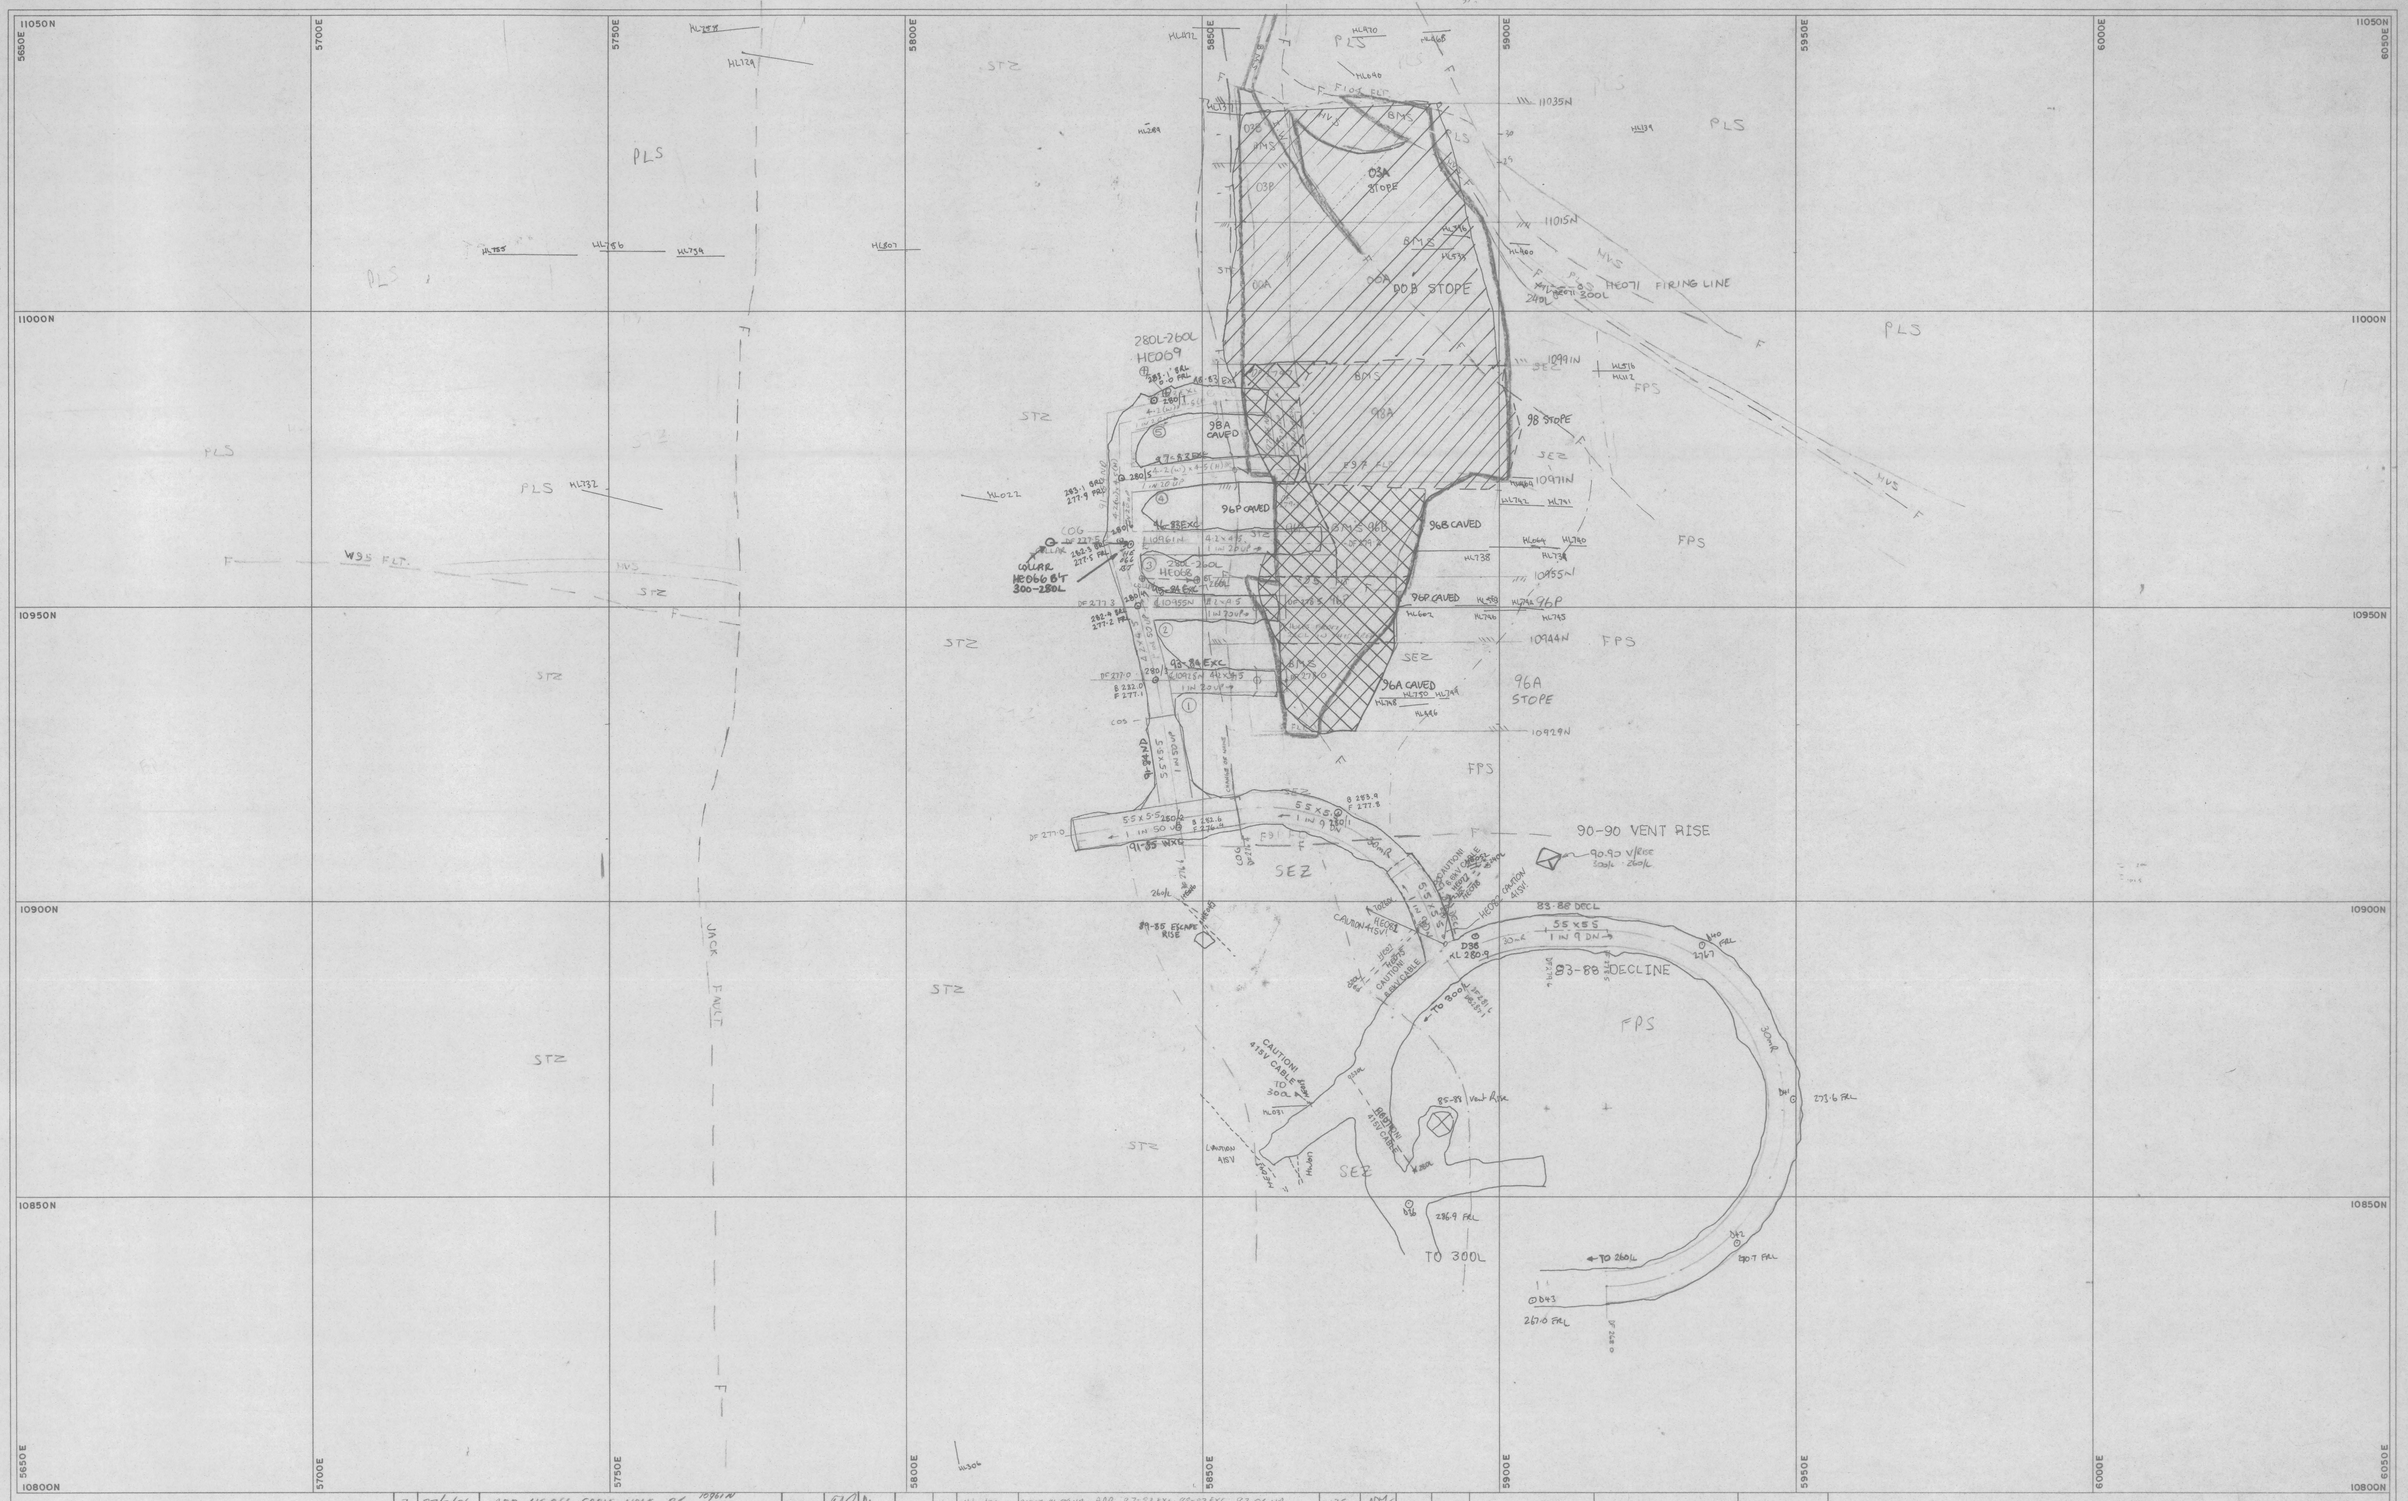

REV	DATE	REVISION	DRAWN	CKD	APP	DIGIT DATE
7	28/2/96	ADD HE066 CABLE HOLE AT 10961N 5838E	DSA			
8	24/5/96	ADD HE069 & HE066 CABLE HOLE 280L-260L FIRING LINE	TLM	DSA		
9	1/7/96	UPDATE CAVE 98A, 96P, 96B, 96A - MASS BLAST	TLM			
10	19/5/97	ADD HE074, 75, 76, 77, 78 CABLE HOLES	TLM			

REV	DATE	REVISION	DRAWN	CKD	APP	DIGIT DATE
6	11/10/94	Revise 91-94NW, ADD 97-99 EXC, 99-89 EXC, 97-86 NW	WJS	ADJ		
5	27/4/93	Orebody outline updated @ 280 RL	RCD			
	1.11.90	BMS outline updated + internal waste added 260L	RCD			
1	3/12/90	Added 89-89 Decl.	GGM	ADJ		14/12/90
2	25/3/92	Added 90-90 V/Rise	GGM	AJW	RD	25392
3	18/5/92	Redrawn @ 250 RL	RCD			
4	5/11/92	Added 91-85W, 91-84N, 92-84E, 95-84E, 96-83E, 89-85E Rise	GGM	AJW	RD	19/11/92

NORTH

SCALE 1:500	SHEET No. 1105-605	
DRAWN	GGM	3/12/90
CHECKED		
DESIGNED		
DESIGN CKD		
DESIGN APP		
PROJECT APP		

Aberfoyle Resources Limited
HELLYER DIVISION

DEVELOPMENT DESIGN

280 LEVEL

DRAWING No.

5 cm

0409-356