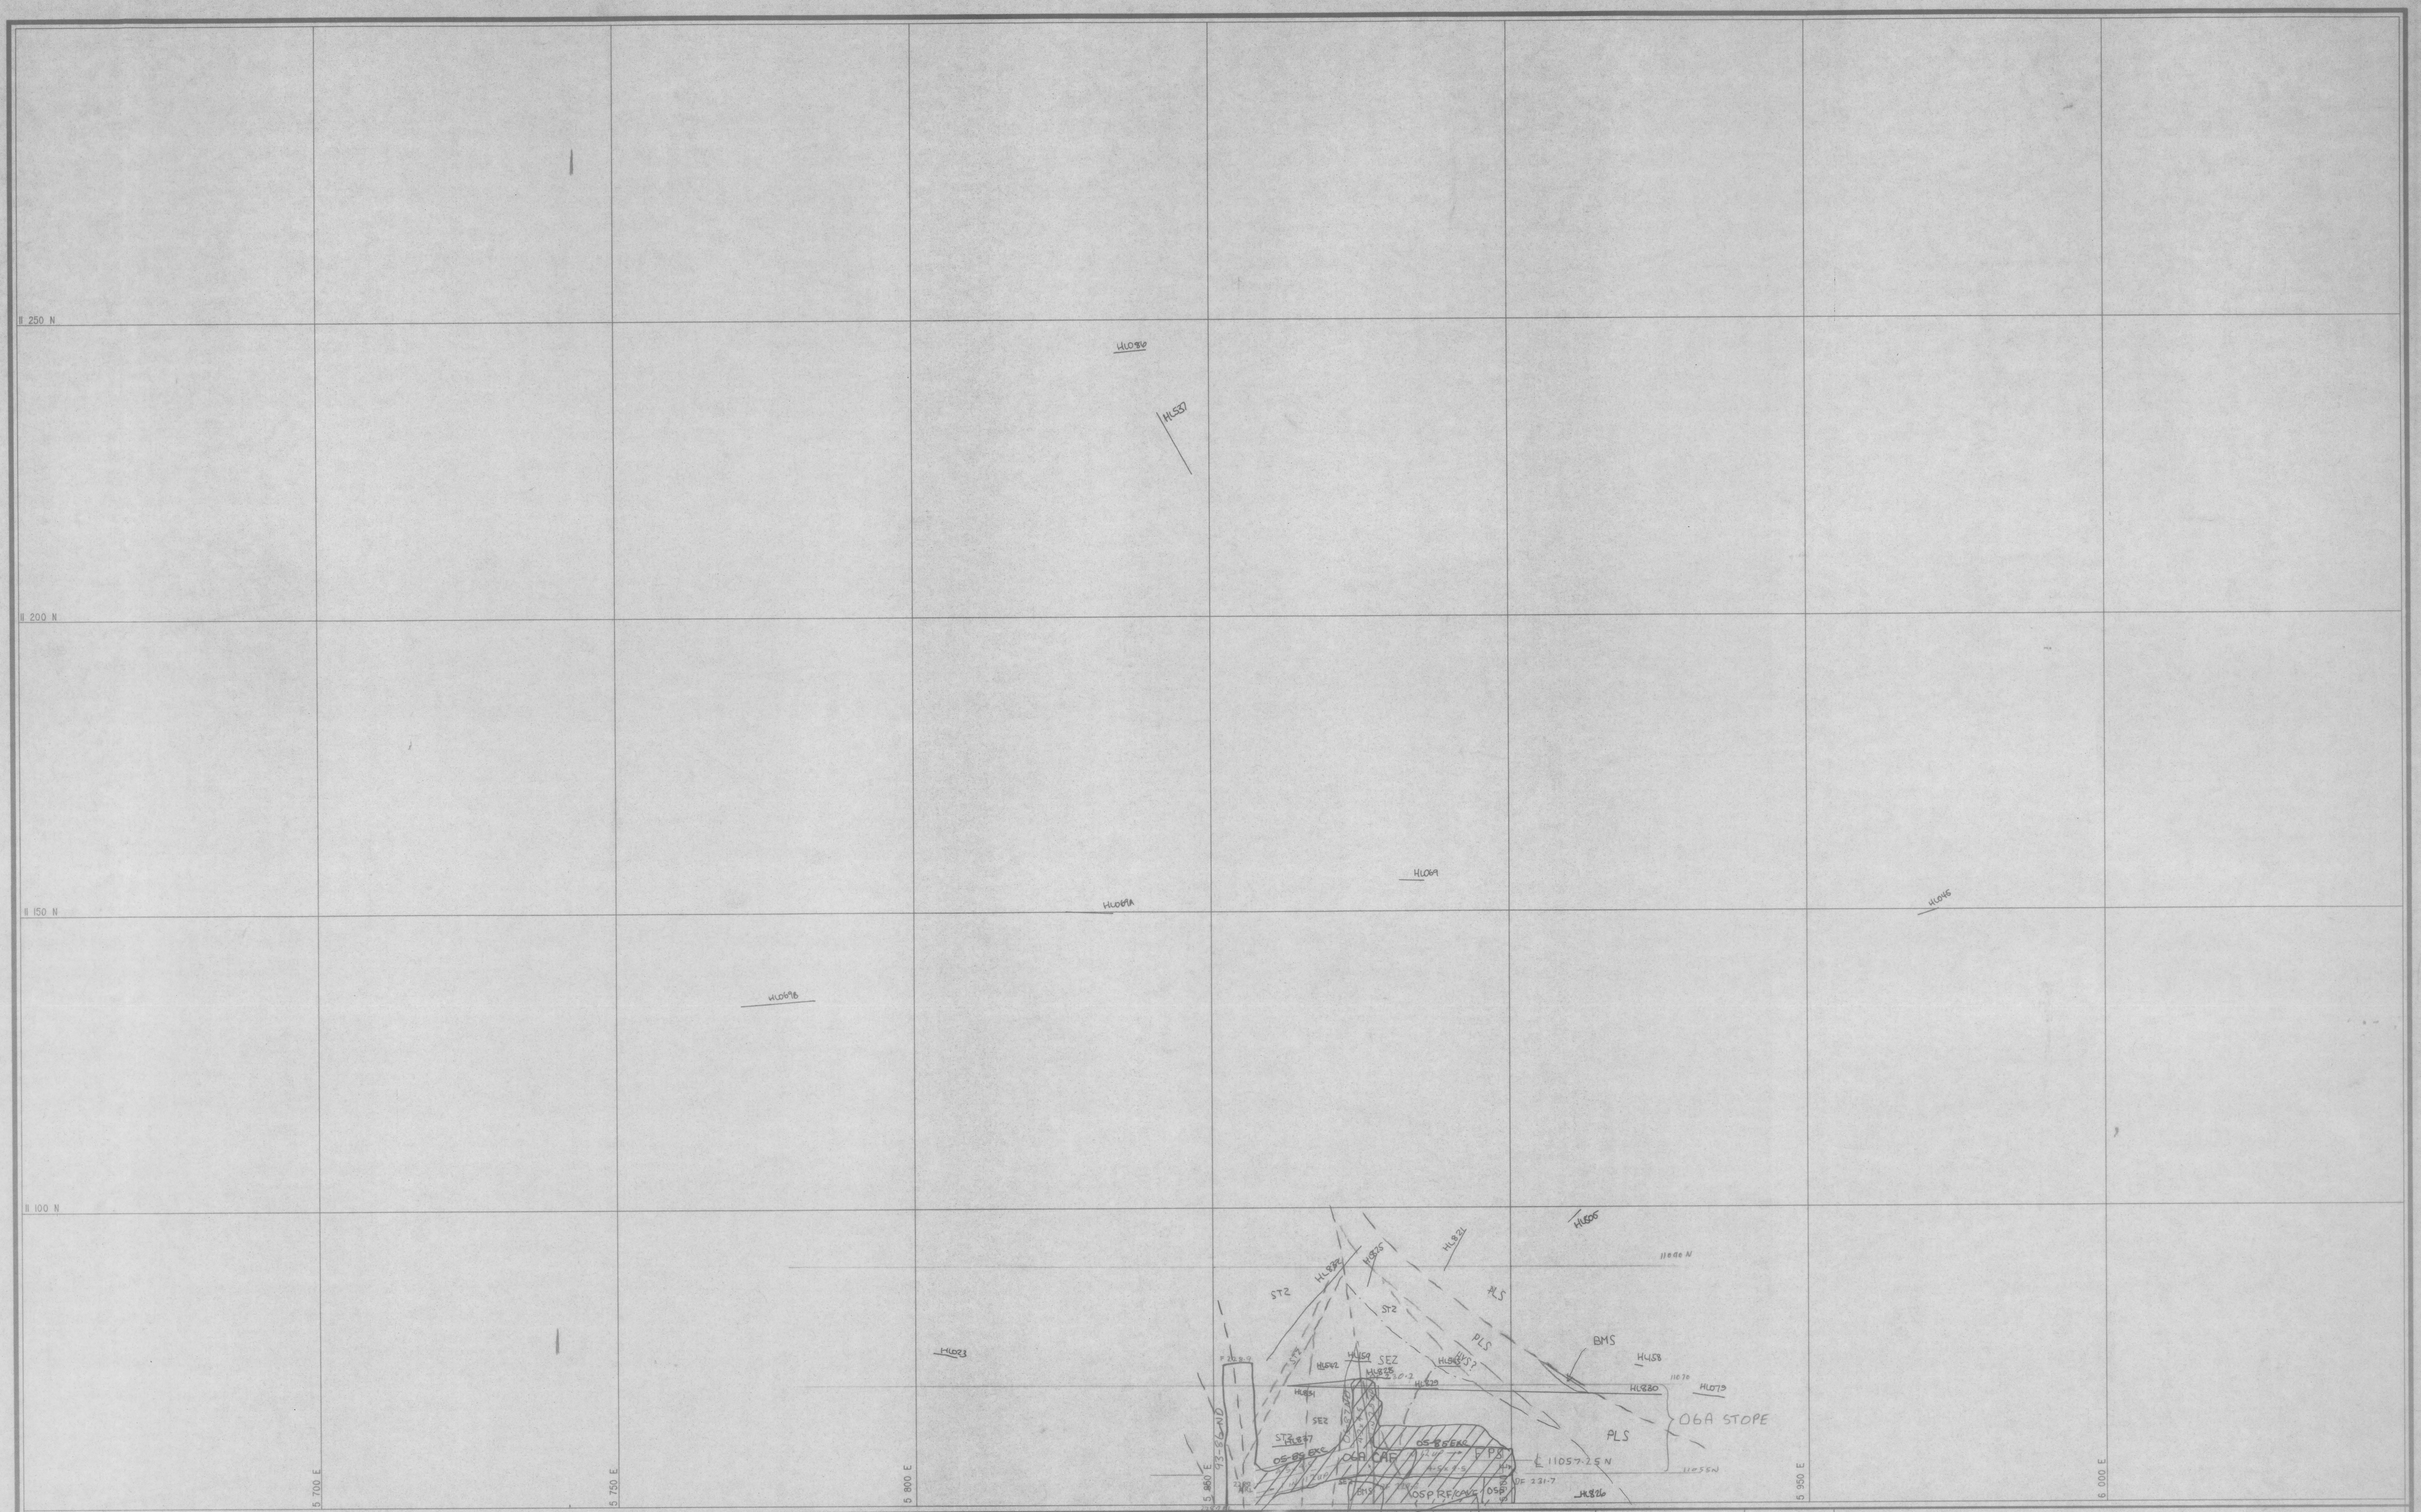

REV.	DATE	REVISION	DRAWN	CKD.	APP.	APP.	REV.	DATE	REVISION	DRAWN	CKD.	APP.	APP.
1	2/3/95	Geology Added	TEA										
2	3/4/95	ADD 05-85EXC, 05-87ND	WTS										

NORTH

SCALE 1:500		
DRAWN	SFM	02/03/95
CHECKED		
DESIGNED		
DESIGN CKD		
DESIGN APP		
PROJECT APP		

Aberfoyle Resources Limited
HELLYER DIVISION
A.C.N. 004 664 108

DEVELOPMENT PLAN
LEVEL 230 -1

DRAWING No.

5 cm

G:\DRAFTED\GEOLOGY\MAPPING\230

0406-361