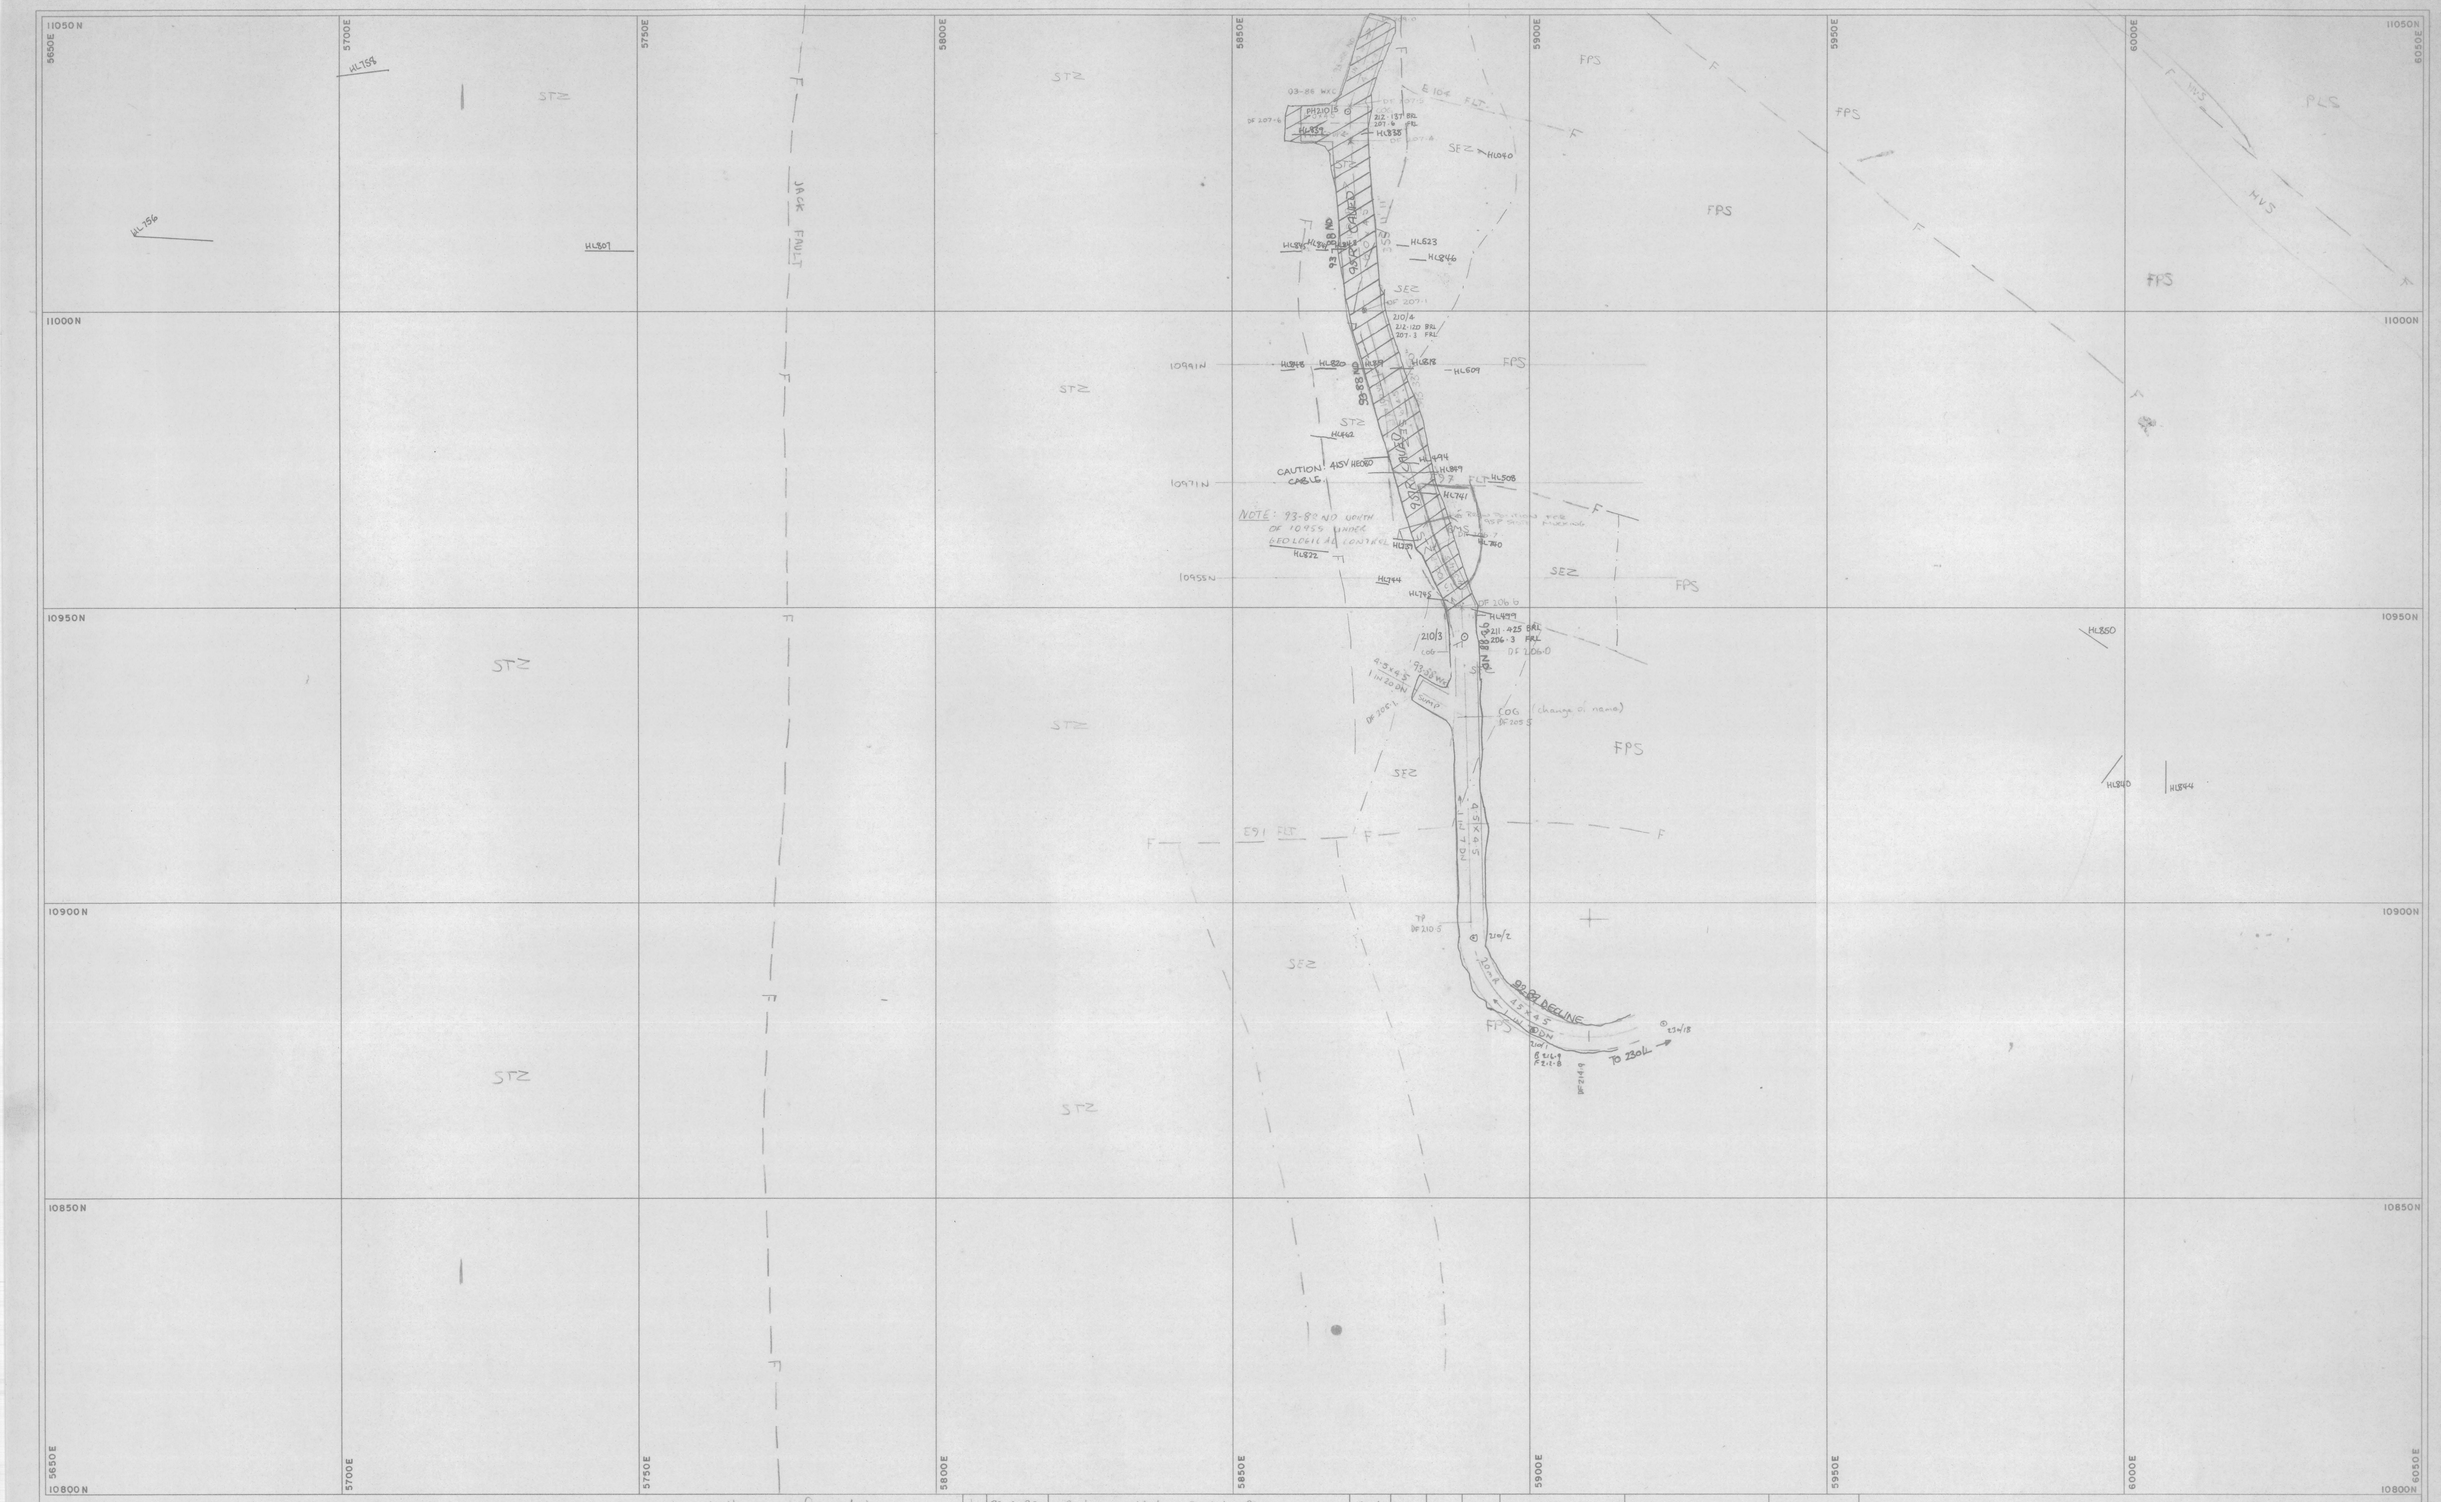

NB Geology boundaries are approximate only, due to limited drilling information
Drilling information extremely sparse south of 10950 to this RL.

REV	DATE	REVISION	DRAWN	CKD	APP	DIGIT DATE
1	22-3-90	Geology added @ 206m RL	AJK			
2	14/1/92	Geology intrp @ 210m RL	RGD			
3	6/11/92	Added 92-89 Decl, 92-88 ND, 93-88 WXC	GGM			19/11/92
4	6/10/94	ALTER 93-88 SD NORTH OF 10942.5	WTS			
5	4/12/96	ALTER 93-38ND NORTH OF 10942.5	VJO	DJR		
6	5/5/97	ADD HADDOCK 230-210		TLM		10/5/97

NORTH

SCALE 1:500		SHEET No. 1105-605
DRAWN	GGM	6/11/92
CHECKED		
DESIGNED	GGM	6/11/92
DESIGN CKD		
DESIGN APP		
PROJECT APP		

Aberfoyle Resources Limited
HELLYER DIVISION

DEVELOPMENT DESIGN

210 LEVEL

DRAWING No.

5 cm

0406-362