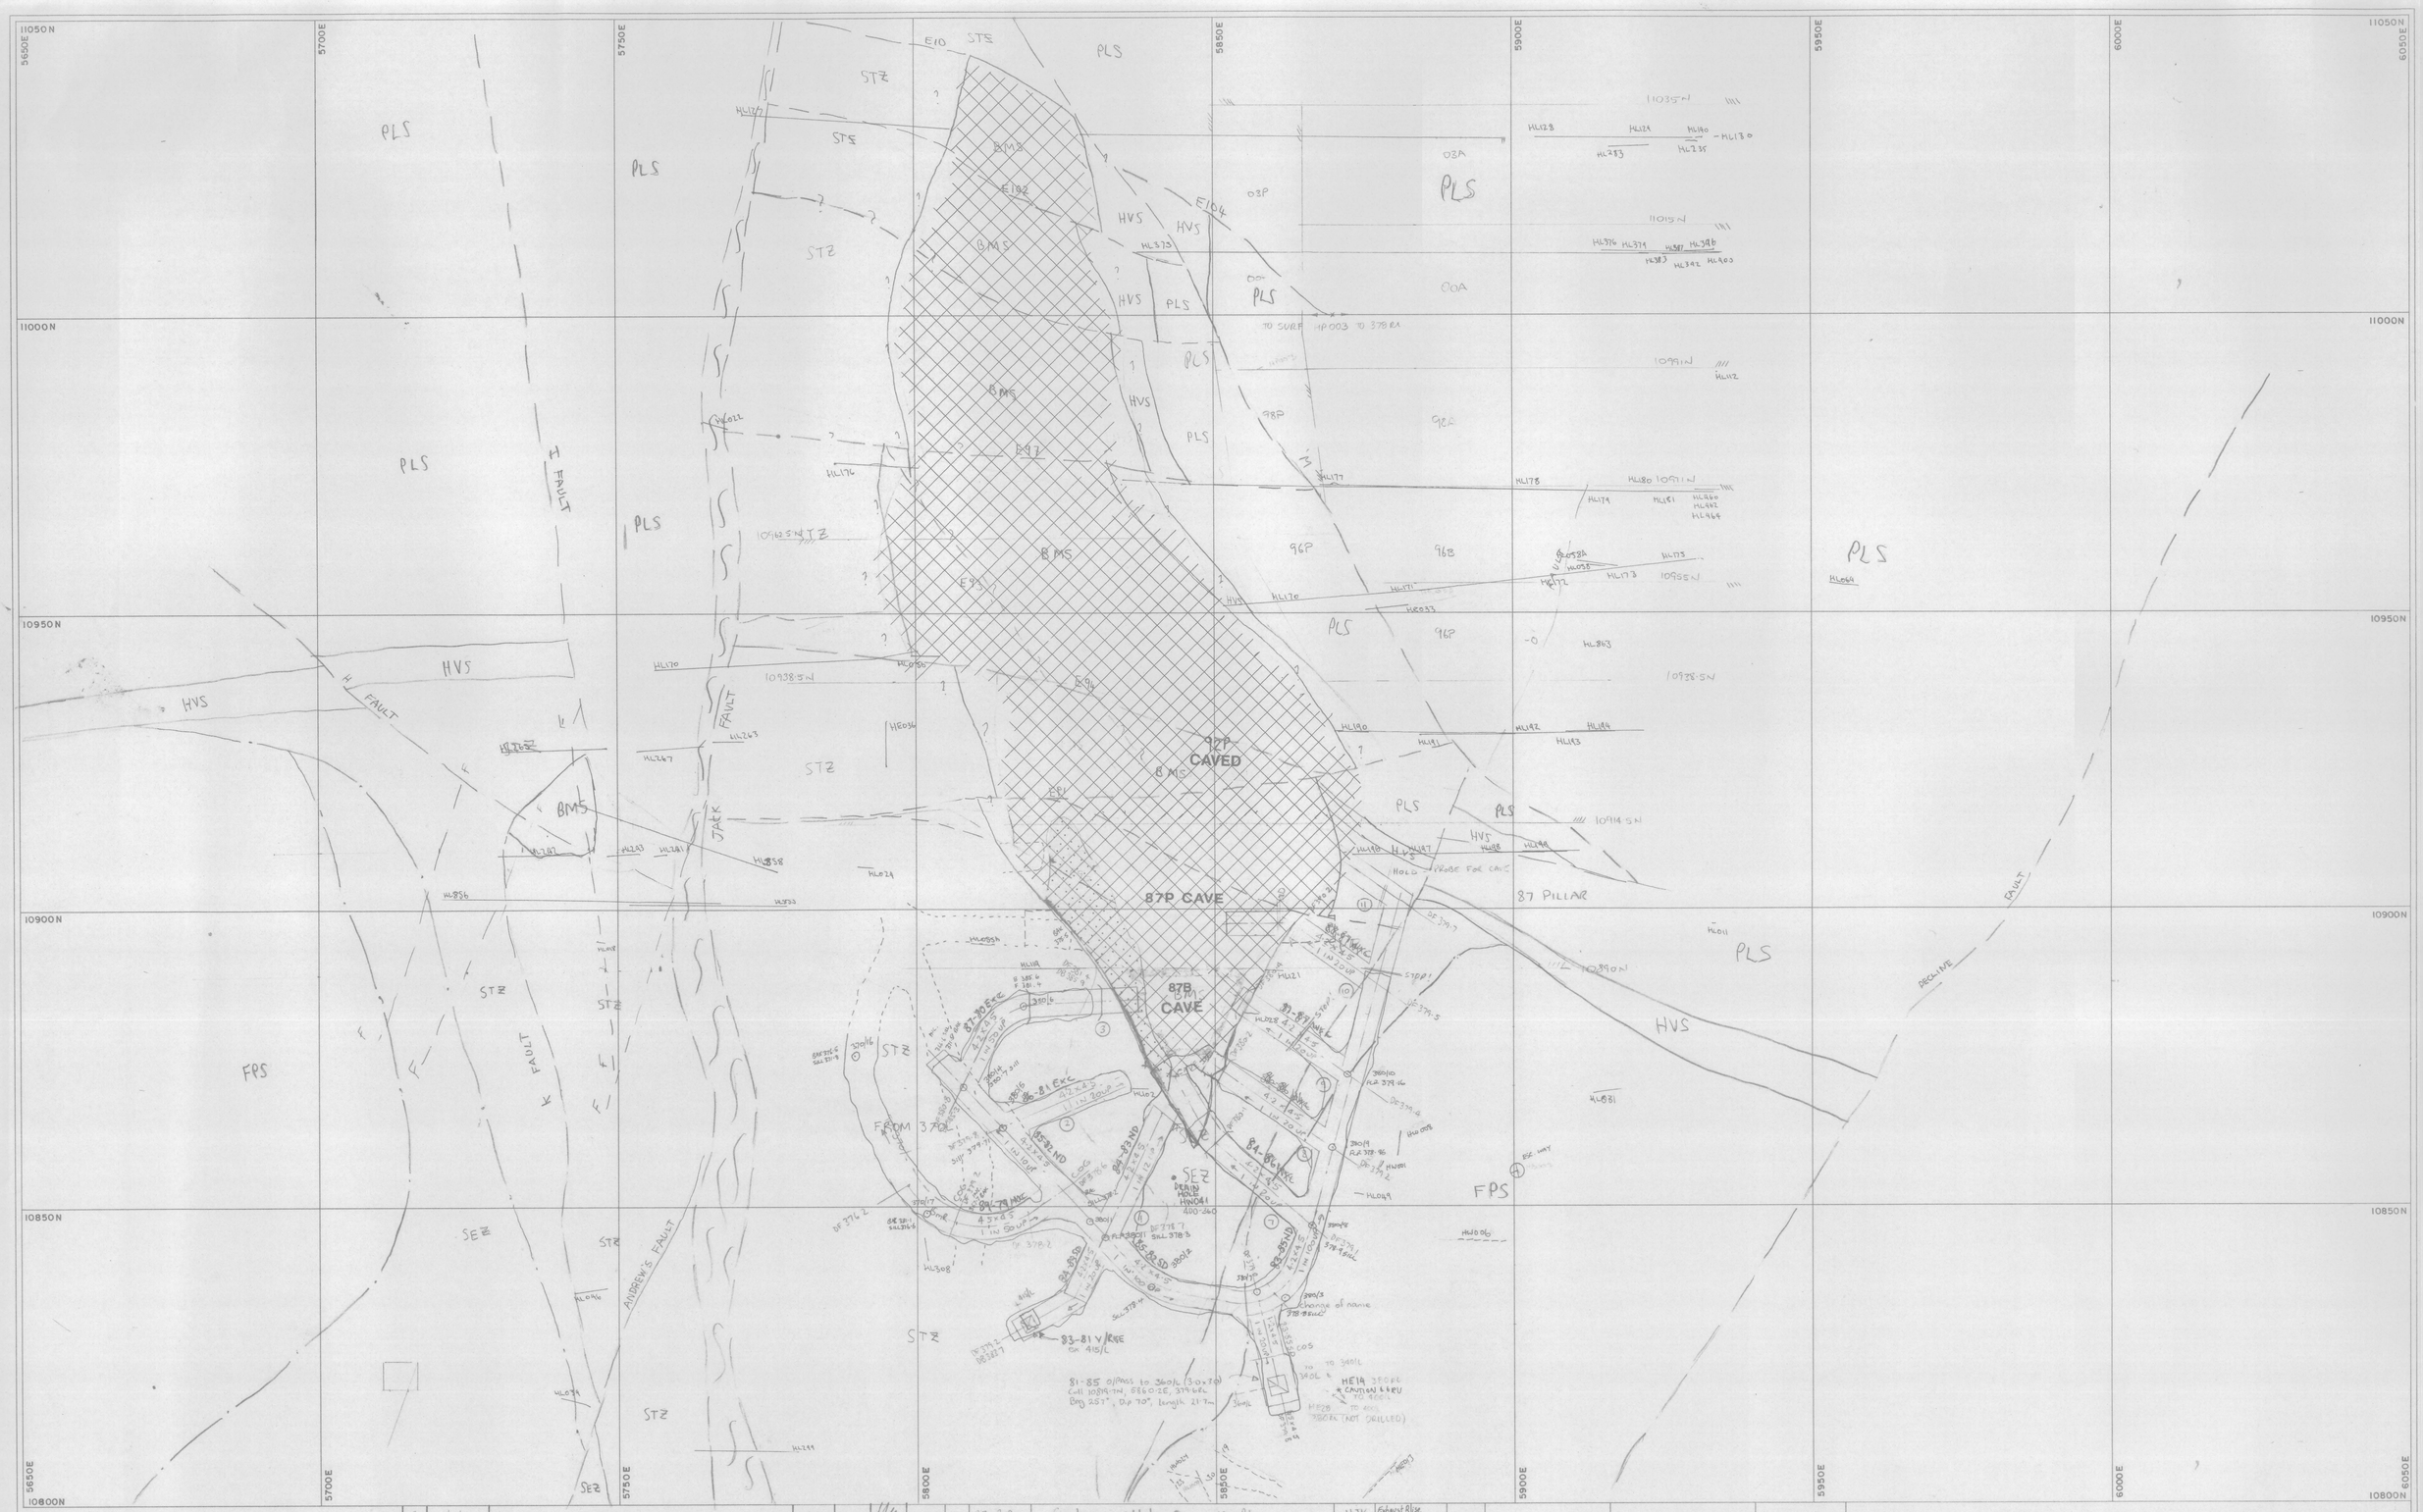

REV	DATE	REVISION	DRAWN	CKD	APP	DIGIT DATE
8	10/7/95	CHANGE/EXTEND 5A-86 CUNC	WTS			
9	29/7/95	91B GEOLOGY ADDED	RDH			
10	11/9/96	ADDED HW041	TLM	DJA		

REV	DATE	REVISION	DRAWN	CKD	APP	DIGIT DATE
1	27-3.90	Geology added @ 350 RL	HJK			
2	22/5/91	HE28 SERVICE HOLE ADDED	AJW			
3	23/9/91	HP003 ADDED	AJW			
4	2/7/92	Added all 380/L developments + mses	GGM	AJW		3.7.92
5	14/10/92	Extended 5A-83 SD + added 83-81 V/Rise	GGM	AJW		14/10/92
6	27/10/92	Altered 83-85 SD + added 81-85 O/P	GGM	AJW		27/10/92
7	27/4/93	Entirely outline updated @ 380 RL	RCD			

NORTH

SCALE 1:500	SHEET No. 1105-605	
DRAWN	GGM	2/7/92
CHECKED		
DESIGNED	GGM	2/7/92
DESIGN CKD		
DESIGN APP		
PROJECT APP		

Aberfoyle Resources Limited
HELLYER DIVISION

DEVELOPMENT DESIGN

380 LEVEL

DRAWING No.

5 cm

0406-368