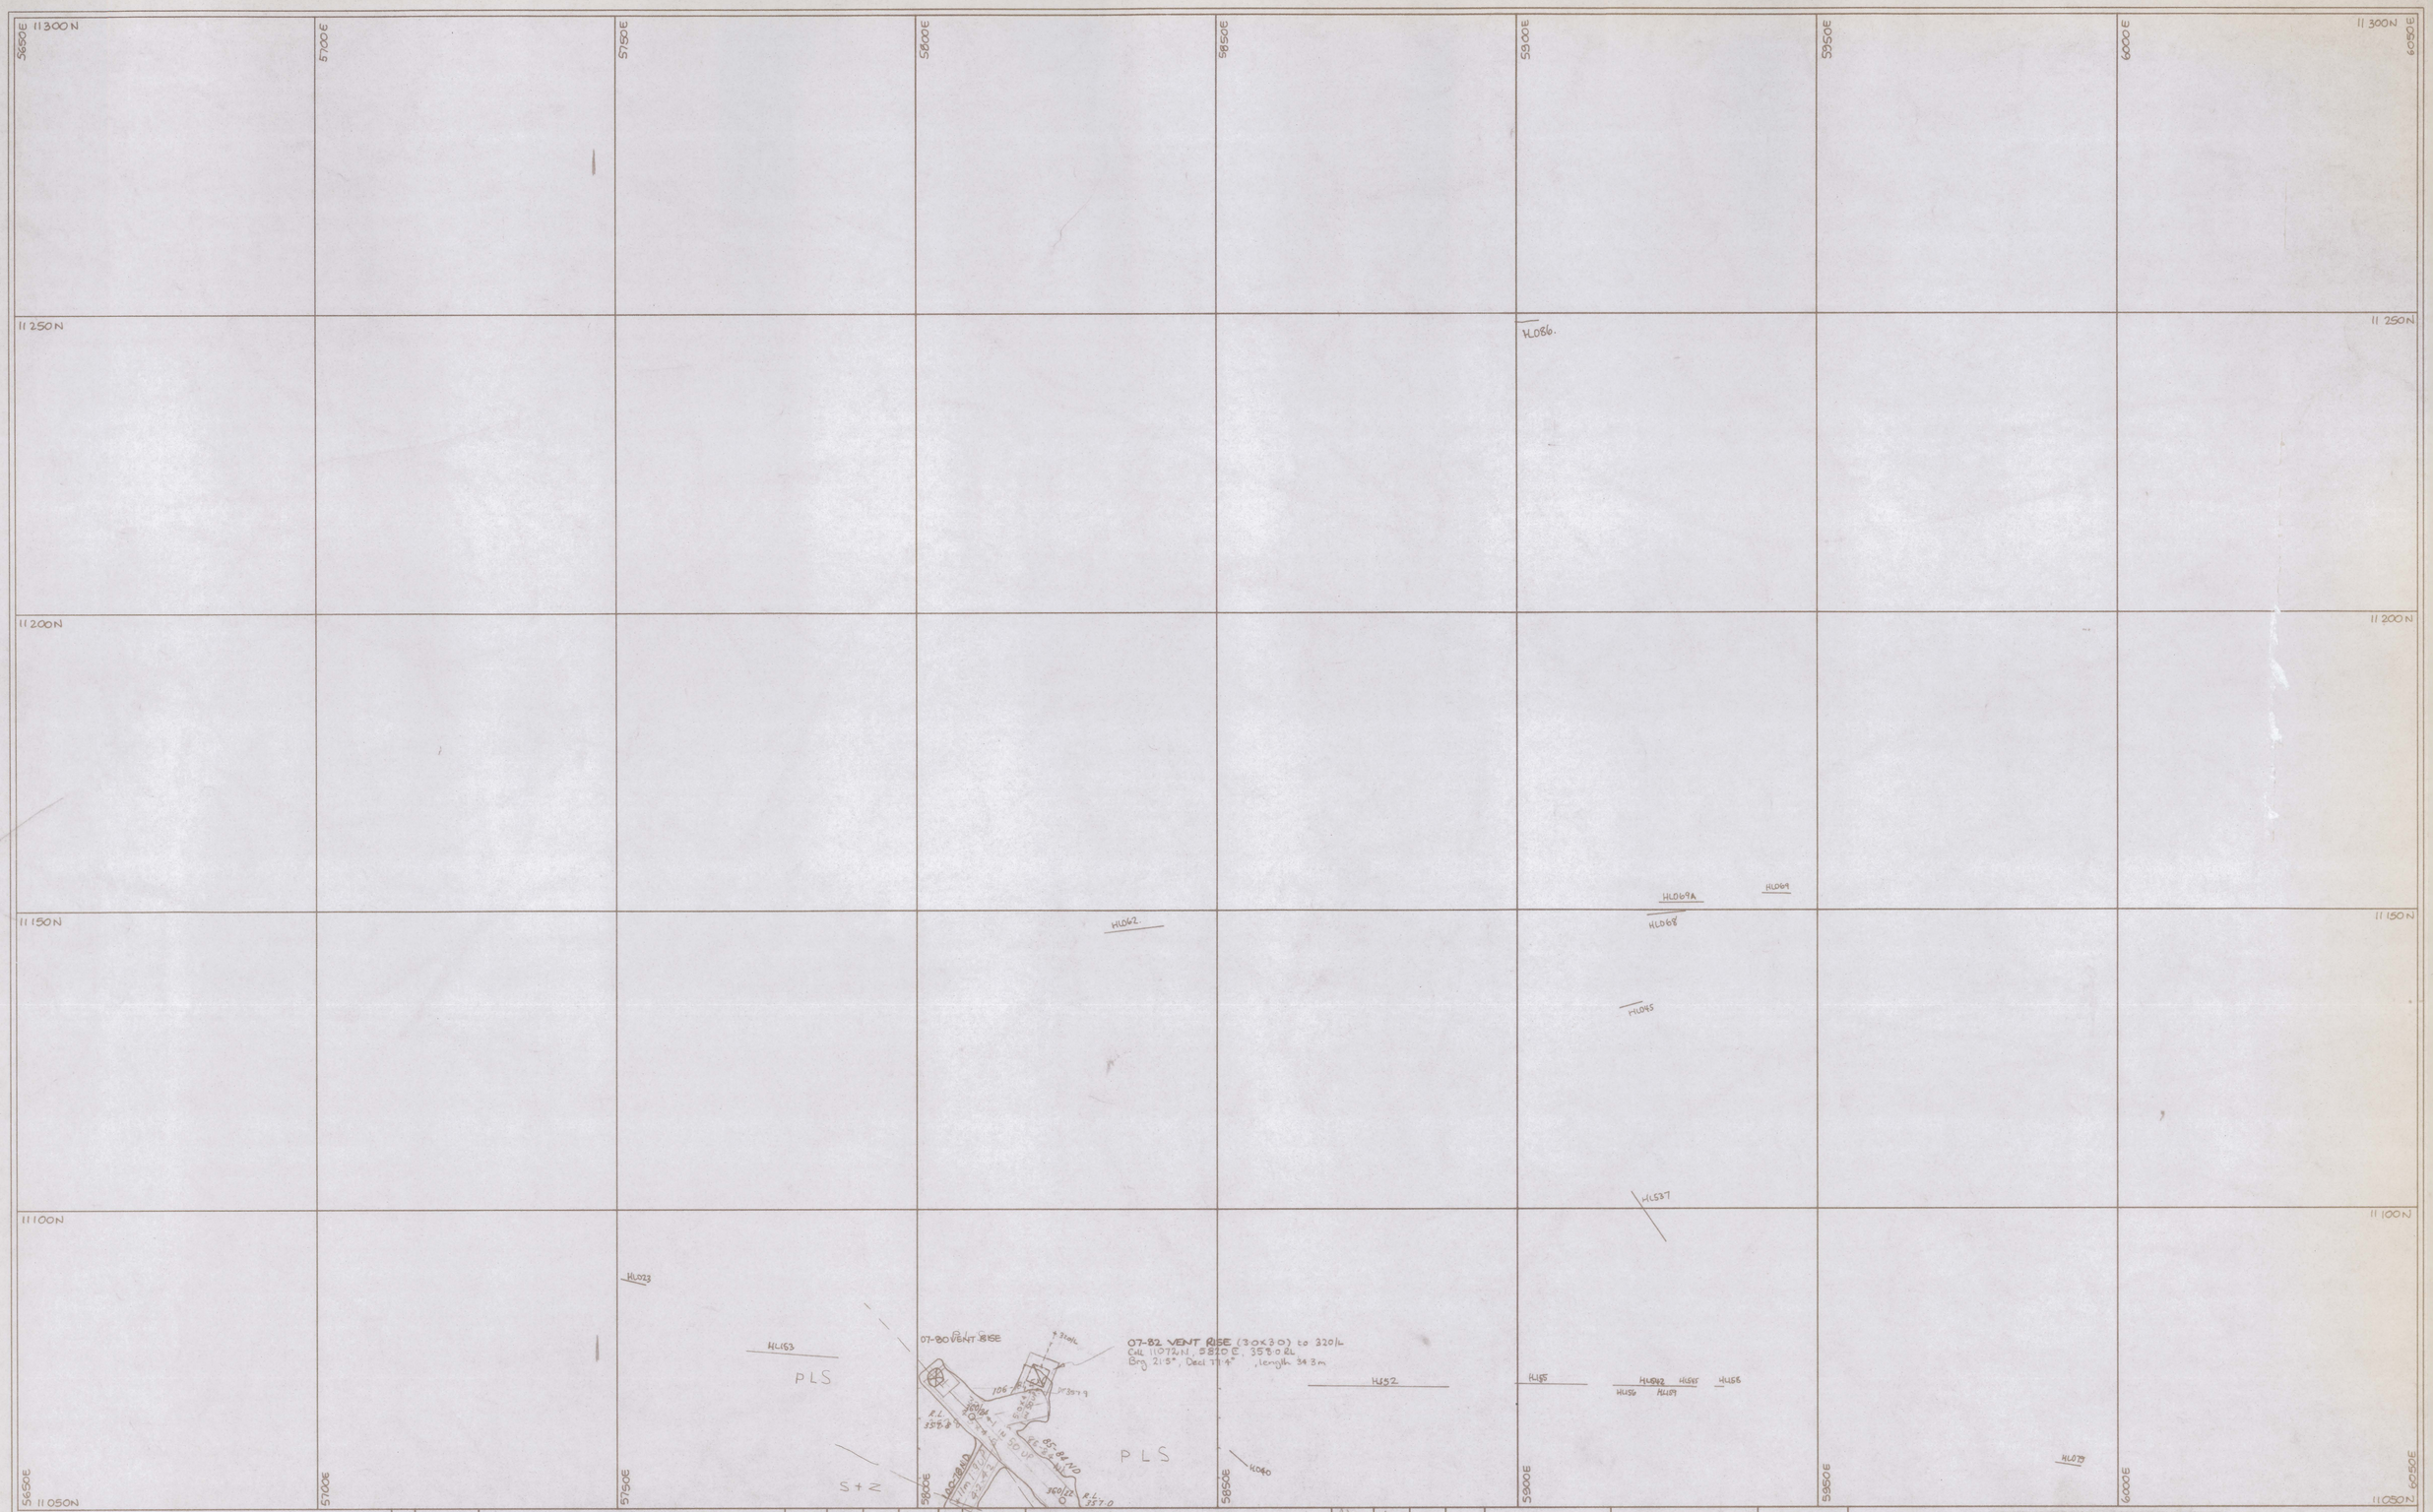

REV	DATE	REVISION	DRAWN	CKD	APP	DIGIT DATE
1	6-10-88	NORTH END DEVELOPMENT ADDED	ADS	AJW		
2	14-4-89	1020-78 N.D. " "	ADS	AJW		
3	22/10/90	Added 06-81 Vent Rise	GGM	ADS	HMB	
4	4/12/90	Extended 106-81 Exc + Altered Vent Rise	GGM	ADS	HMB	
5	4/1/00	Updated Diamond Drill Holes	TJM			

NORTH

SCALE 1:500	SHEET Nº 1130-605	
DRAWN	AJW	6/10/88
CHECKED		
DESIGNED		
DESIGN CKD		
DESIGN APP		
PROJECT APP		

Aberfoyle Resources Limited
HELLYER DIVISION

PROJECT :

DEVELOPMENT DESIGN

360 LEVEL - 3

DRAWING NO.

5 cm

06040 - 371