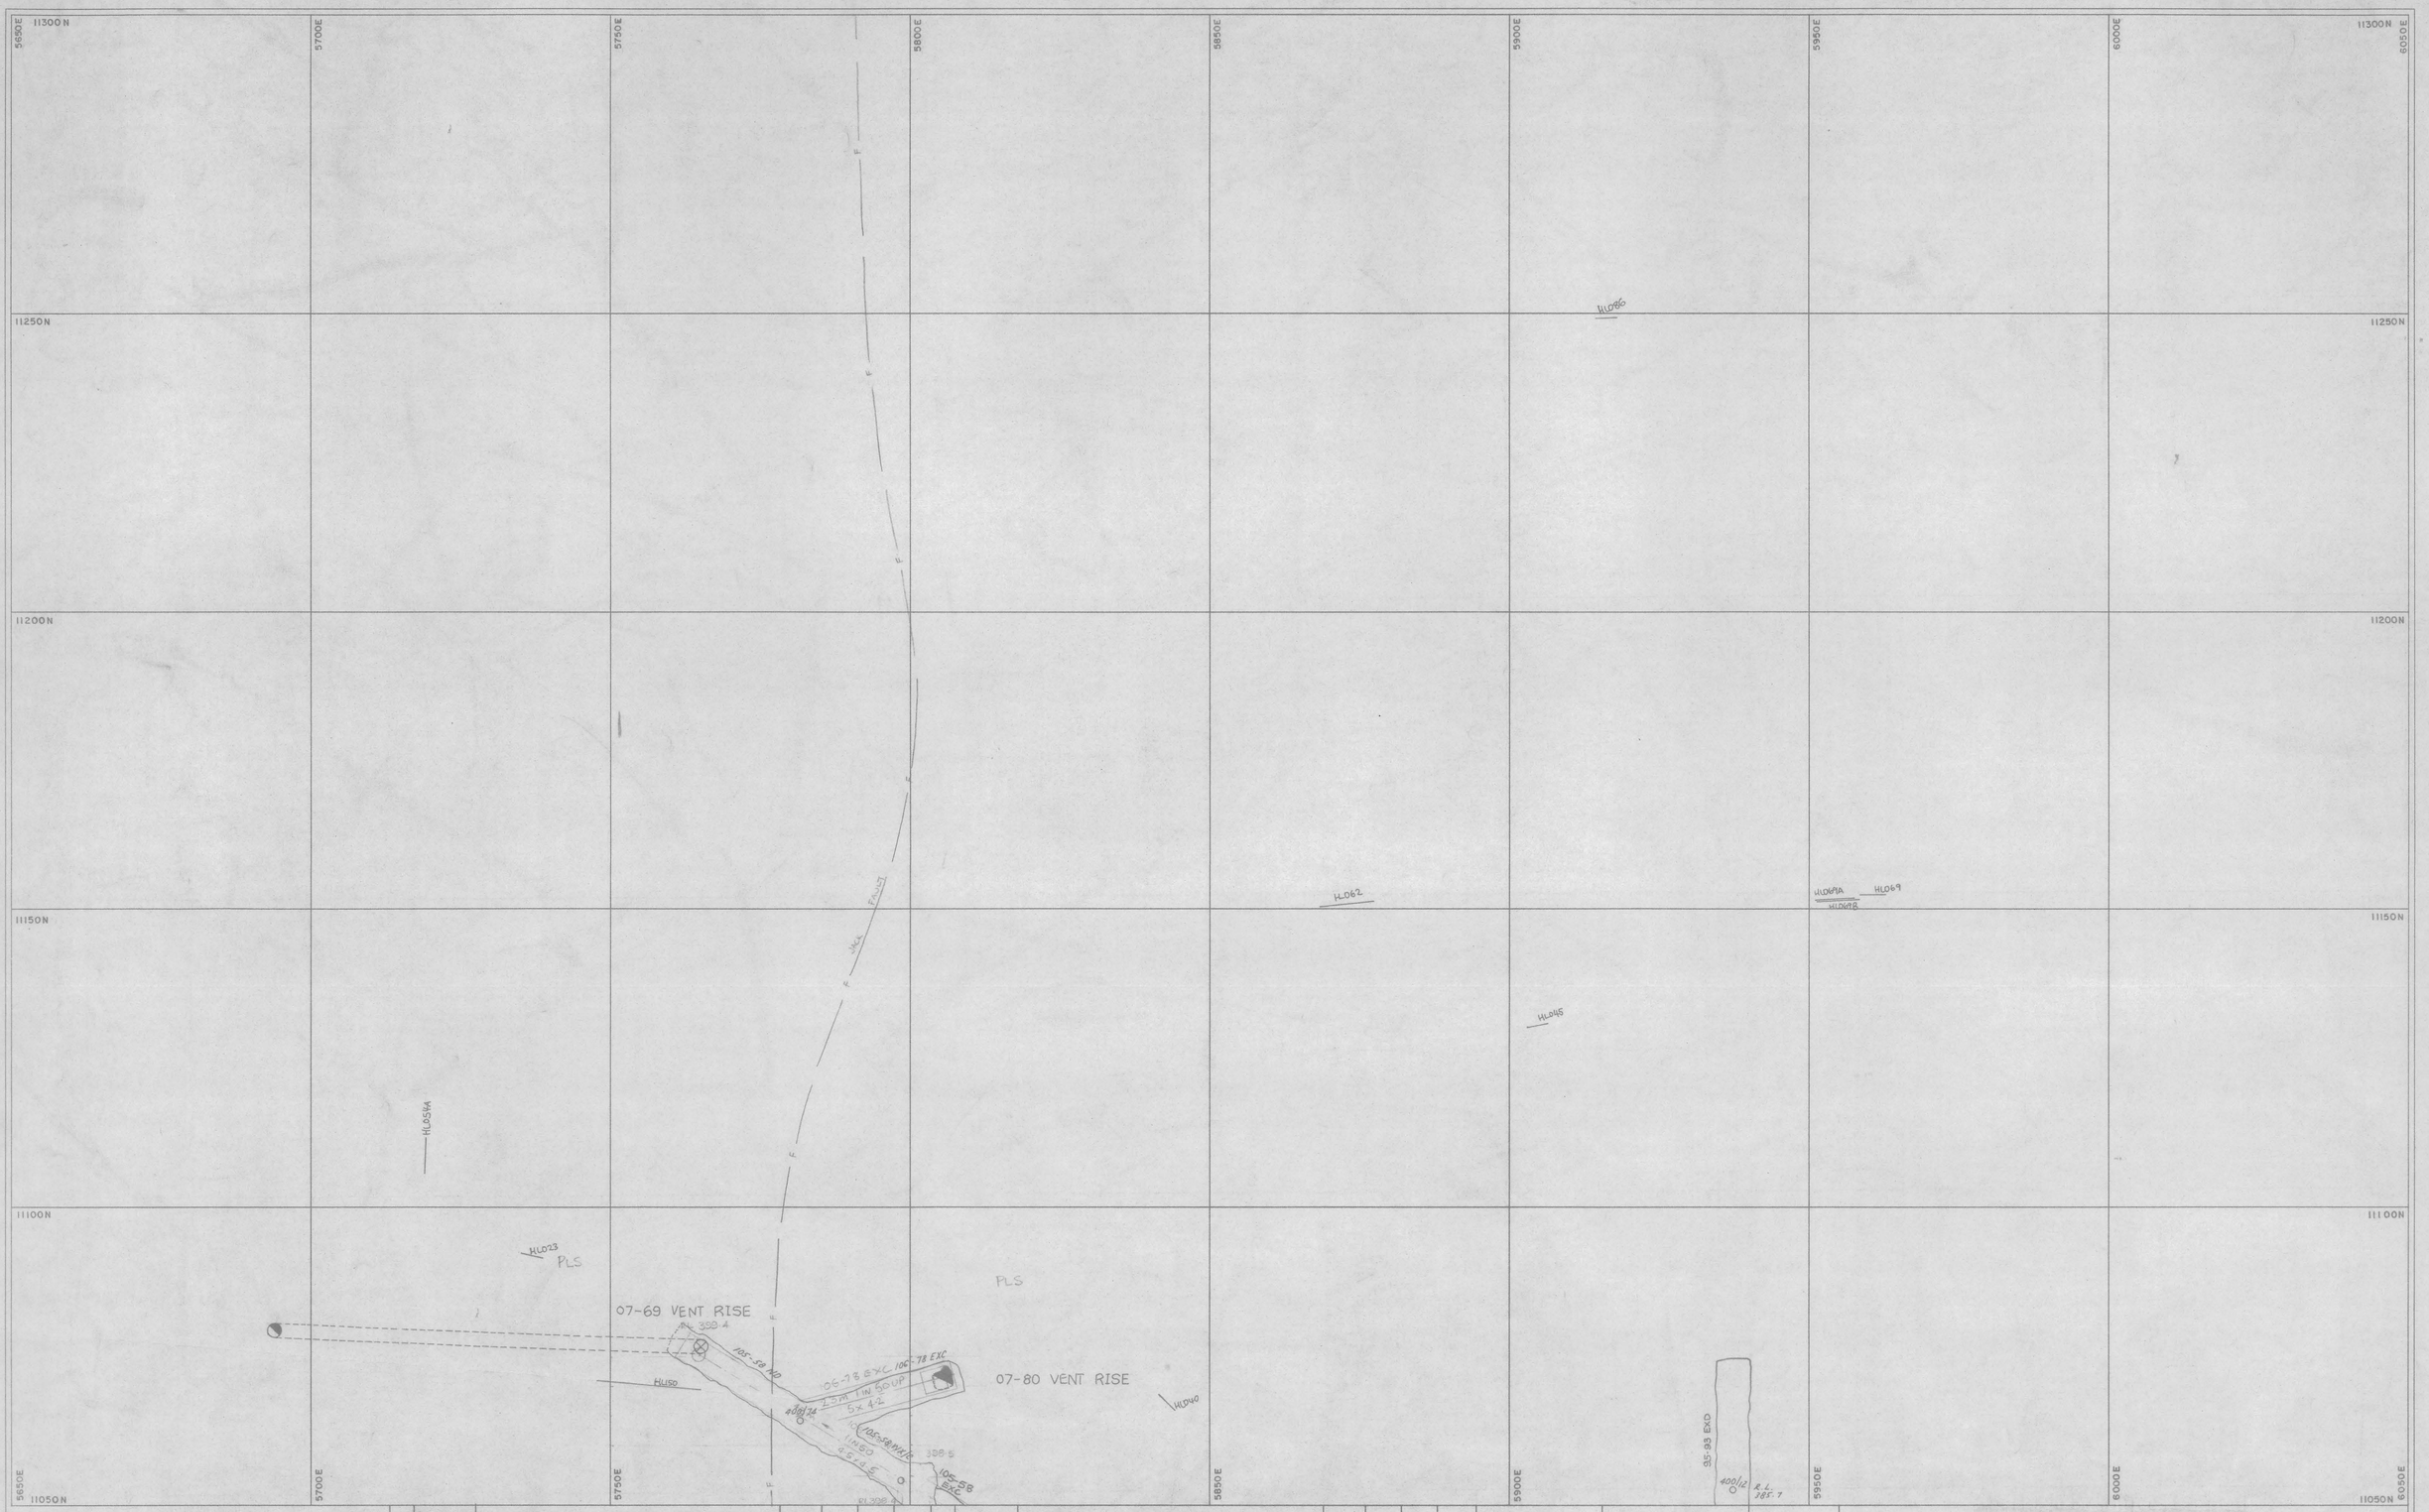

REV.	DATE	REVISION	DRAWN	CKD	APP	DIGIT DATE
	10-7-87	NORTH STYD DEVELOPMENT ADDED	AJW			
	6-10-88	106-78 EXC ADDED	ADS			
	4-01-00	UPDATED DIAMOND DRILL HOLES	TLM			

NORTH

SCALE 1:500		1130-605
DRAWN	AJW	22-2-96
CHECKED		
DESIGNED		
DESIGN CKD		
DESIGN APP		14-1-0
PROJECT APP		

Aberfoyle Resources Limited
HELLYER DIVISION

PROJECT :

DEVELOPMENT DESIGN
400 LEVEL - 2

DRAWING NO.

5 cm

0406-377