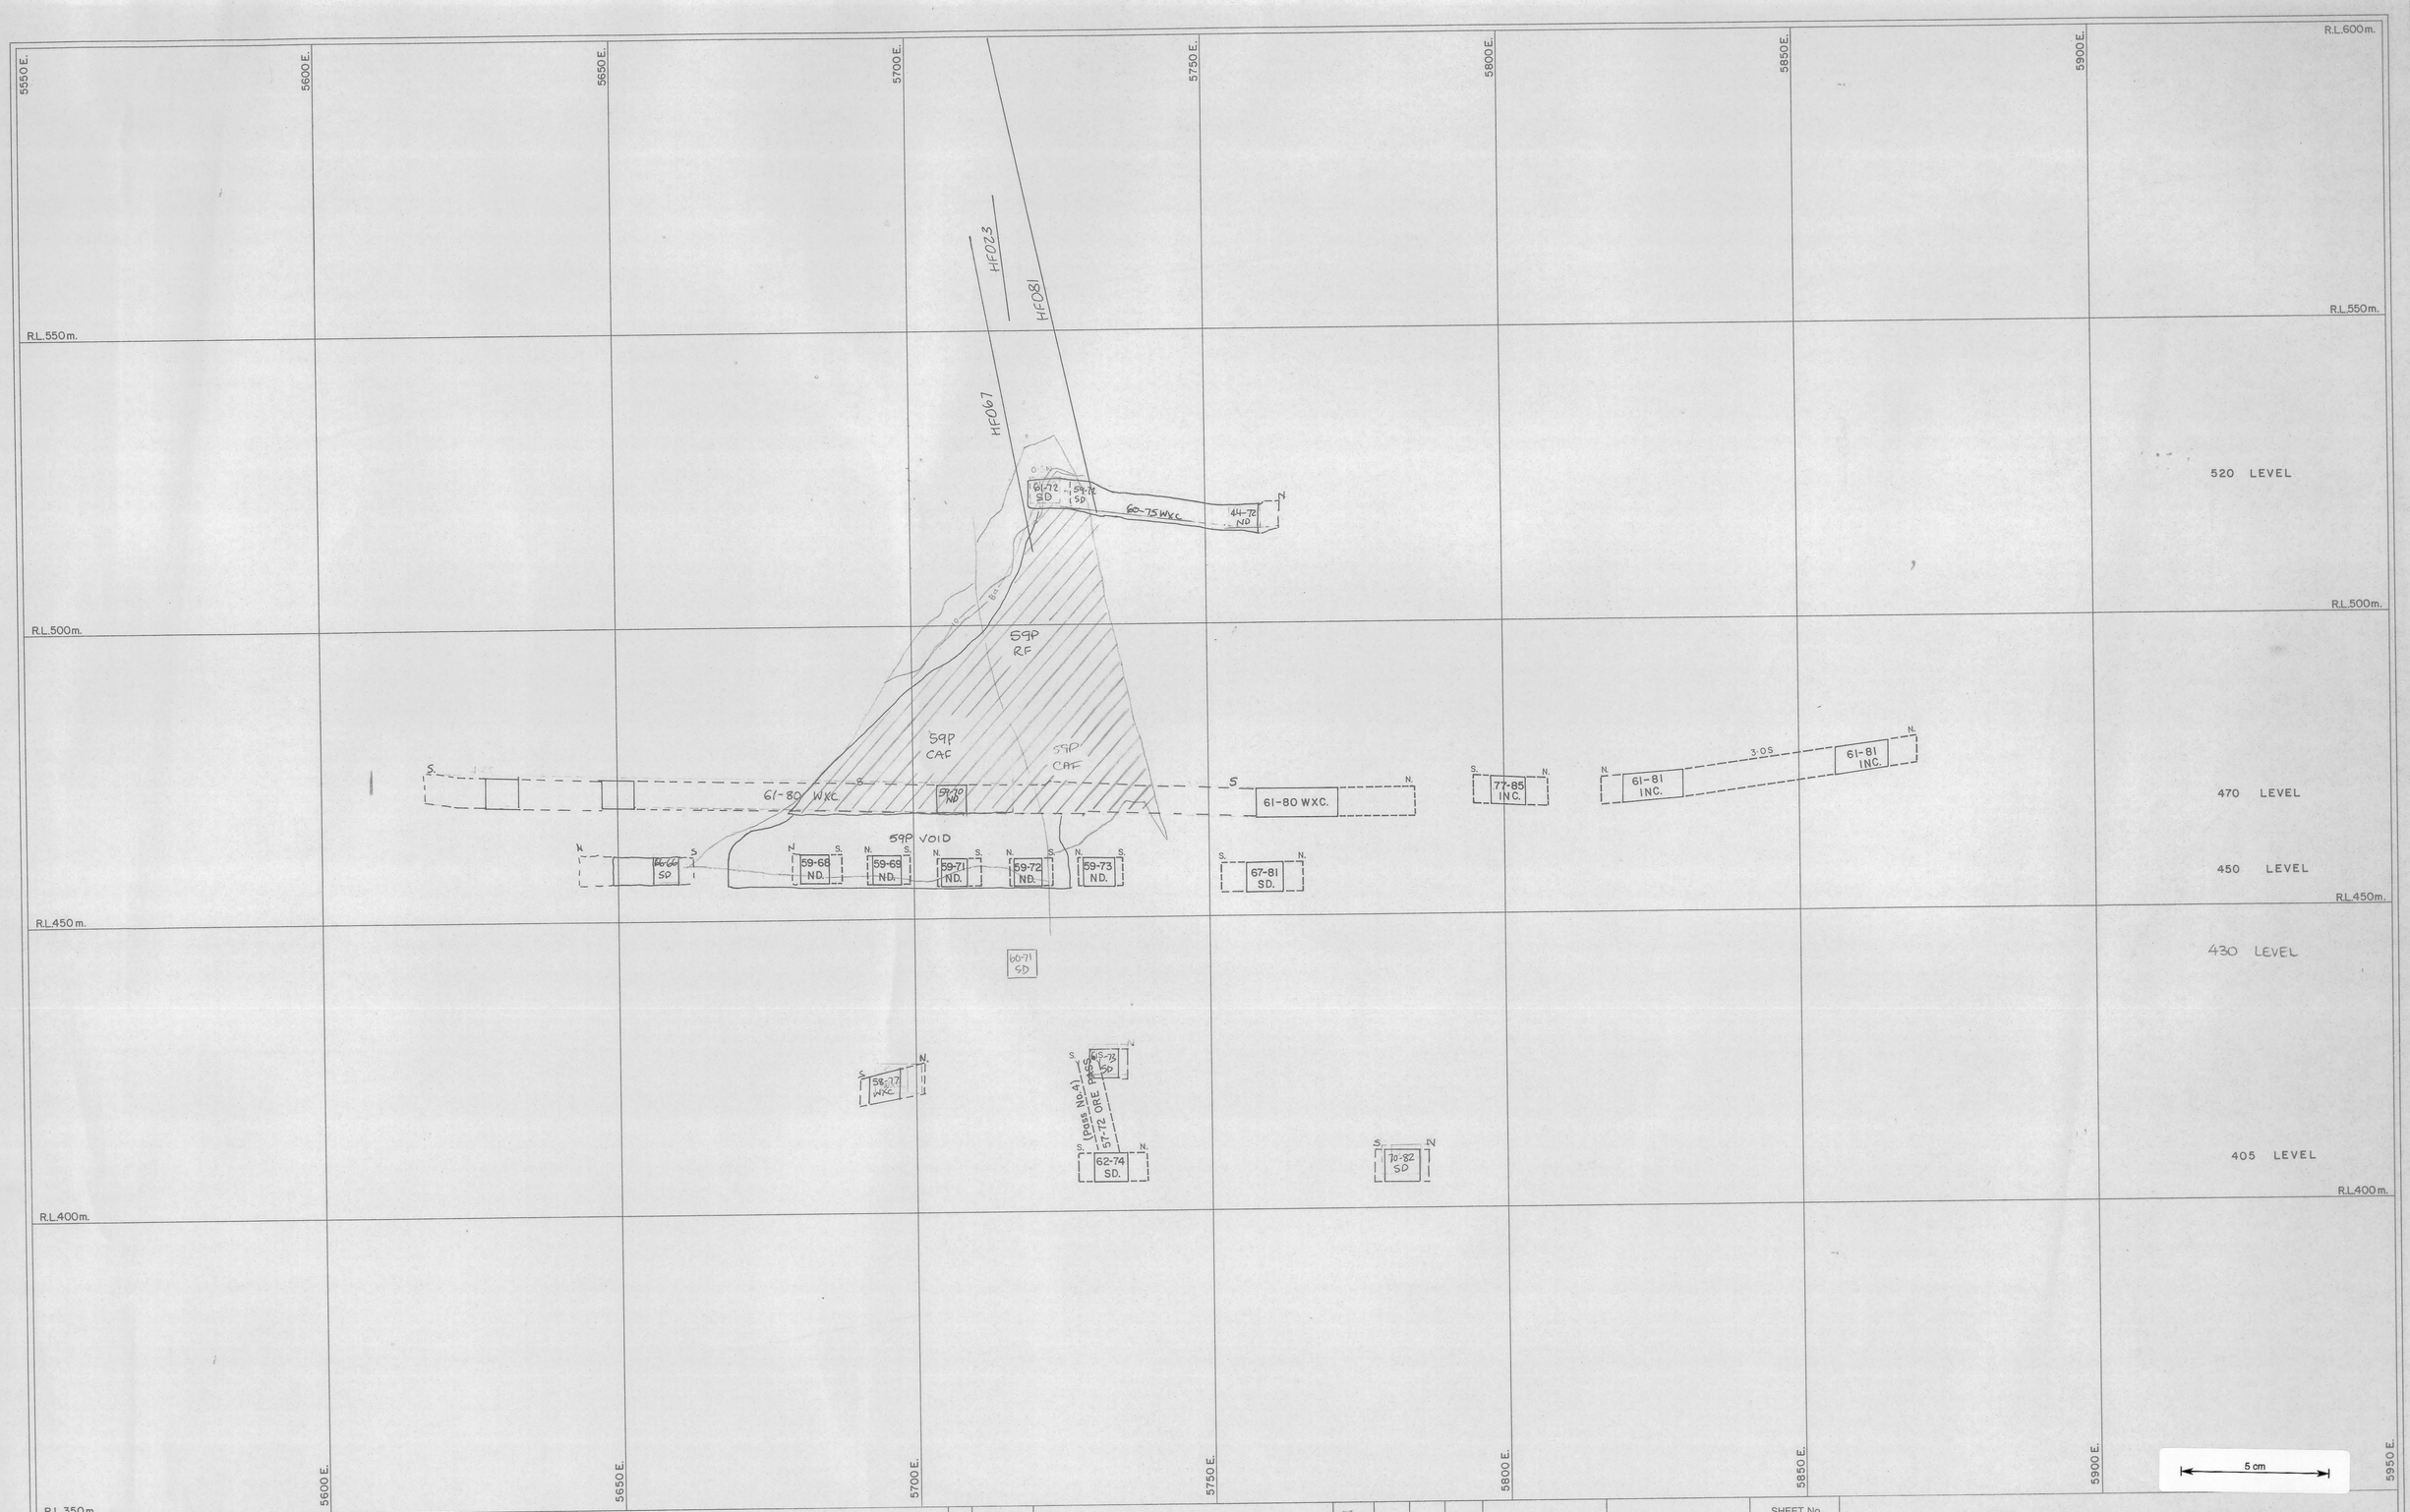

REV	DATE	REVISION	DRAWN	CKD	APP	APP
1	11/7/90	ADD 44-72 ND	WTS			
2	28/7/94	ADD 60-75 WXC, 59-72 ND	WTS			
3	11/95	ADD 59-70 ND 470L	WTS			
4	24/11/95	DELETE 59-72 ND, ADD 59-72 SD 510L	WTS			
5	16 6 99	ADD 60-71 SD 60B STOPE 430L	TJM	KJ		

NORTH

SCALE	1:500
SHEET No.	
DRAWN	
CHECKED	
DESIGNED	
DESIGN CKD	
DESIGN APP	
PROJECT APP	

Aberfoyle Resources Limited
HELLYER DIVISION

DEVELOPMENT DESIGN
SECTION 10600N

DRAWING No.

REVISION

0406-3788