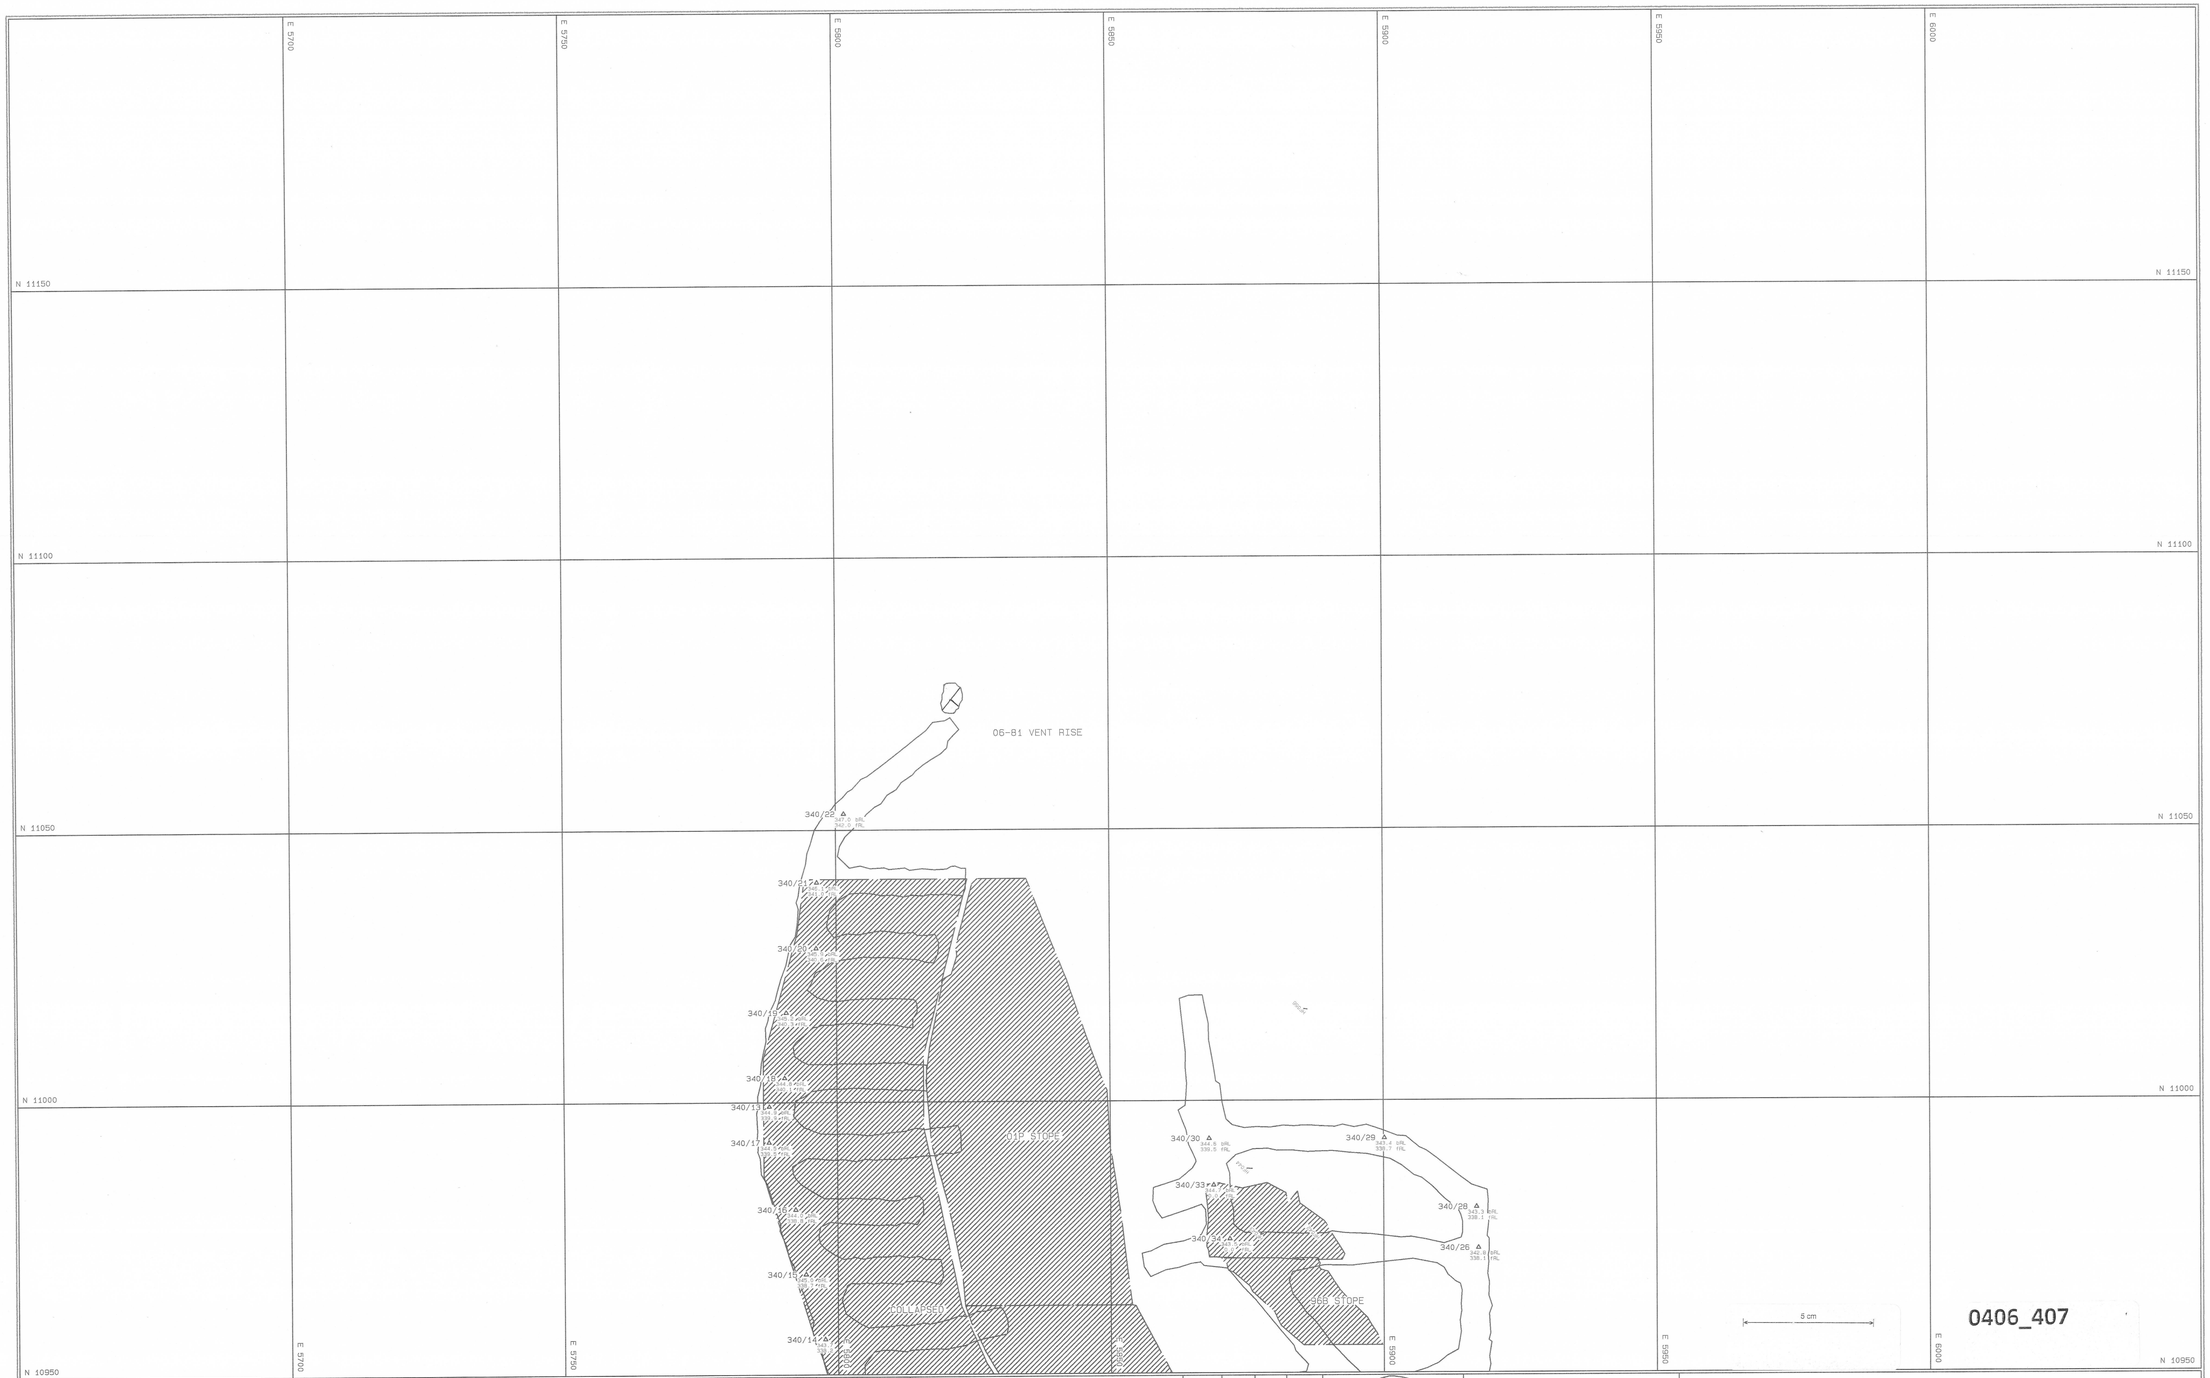

KEY

HP = PROBE HOLE
HA = COMP. AIR HOLE
HV = VENT HOLE
HE = ELECTRICAL HOLE
HW = WATER HOLE
HF = FILL HOLE

REV	DATE	REVISION	DRAWN	CKD	APP	APP

NORTH

SCALE 1:500		
DRAWN	DAS	8-Feb-96
CHECKED	TAT.	
DESIGNED		
DESIGN CKD.		
DESIGN APP.		
PROJECT APP.		

ABERFOYLE RESOURCES LTD.
HELLYER DIVISION

HELLYER MINE
LEVEL PLAN
HORIZON 340mRL

Drawing No.

REVISION

zzza.pf

SURPAC SOFTWARE INTERNATIONAL. AUSTRALIA

0406_407