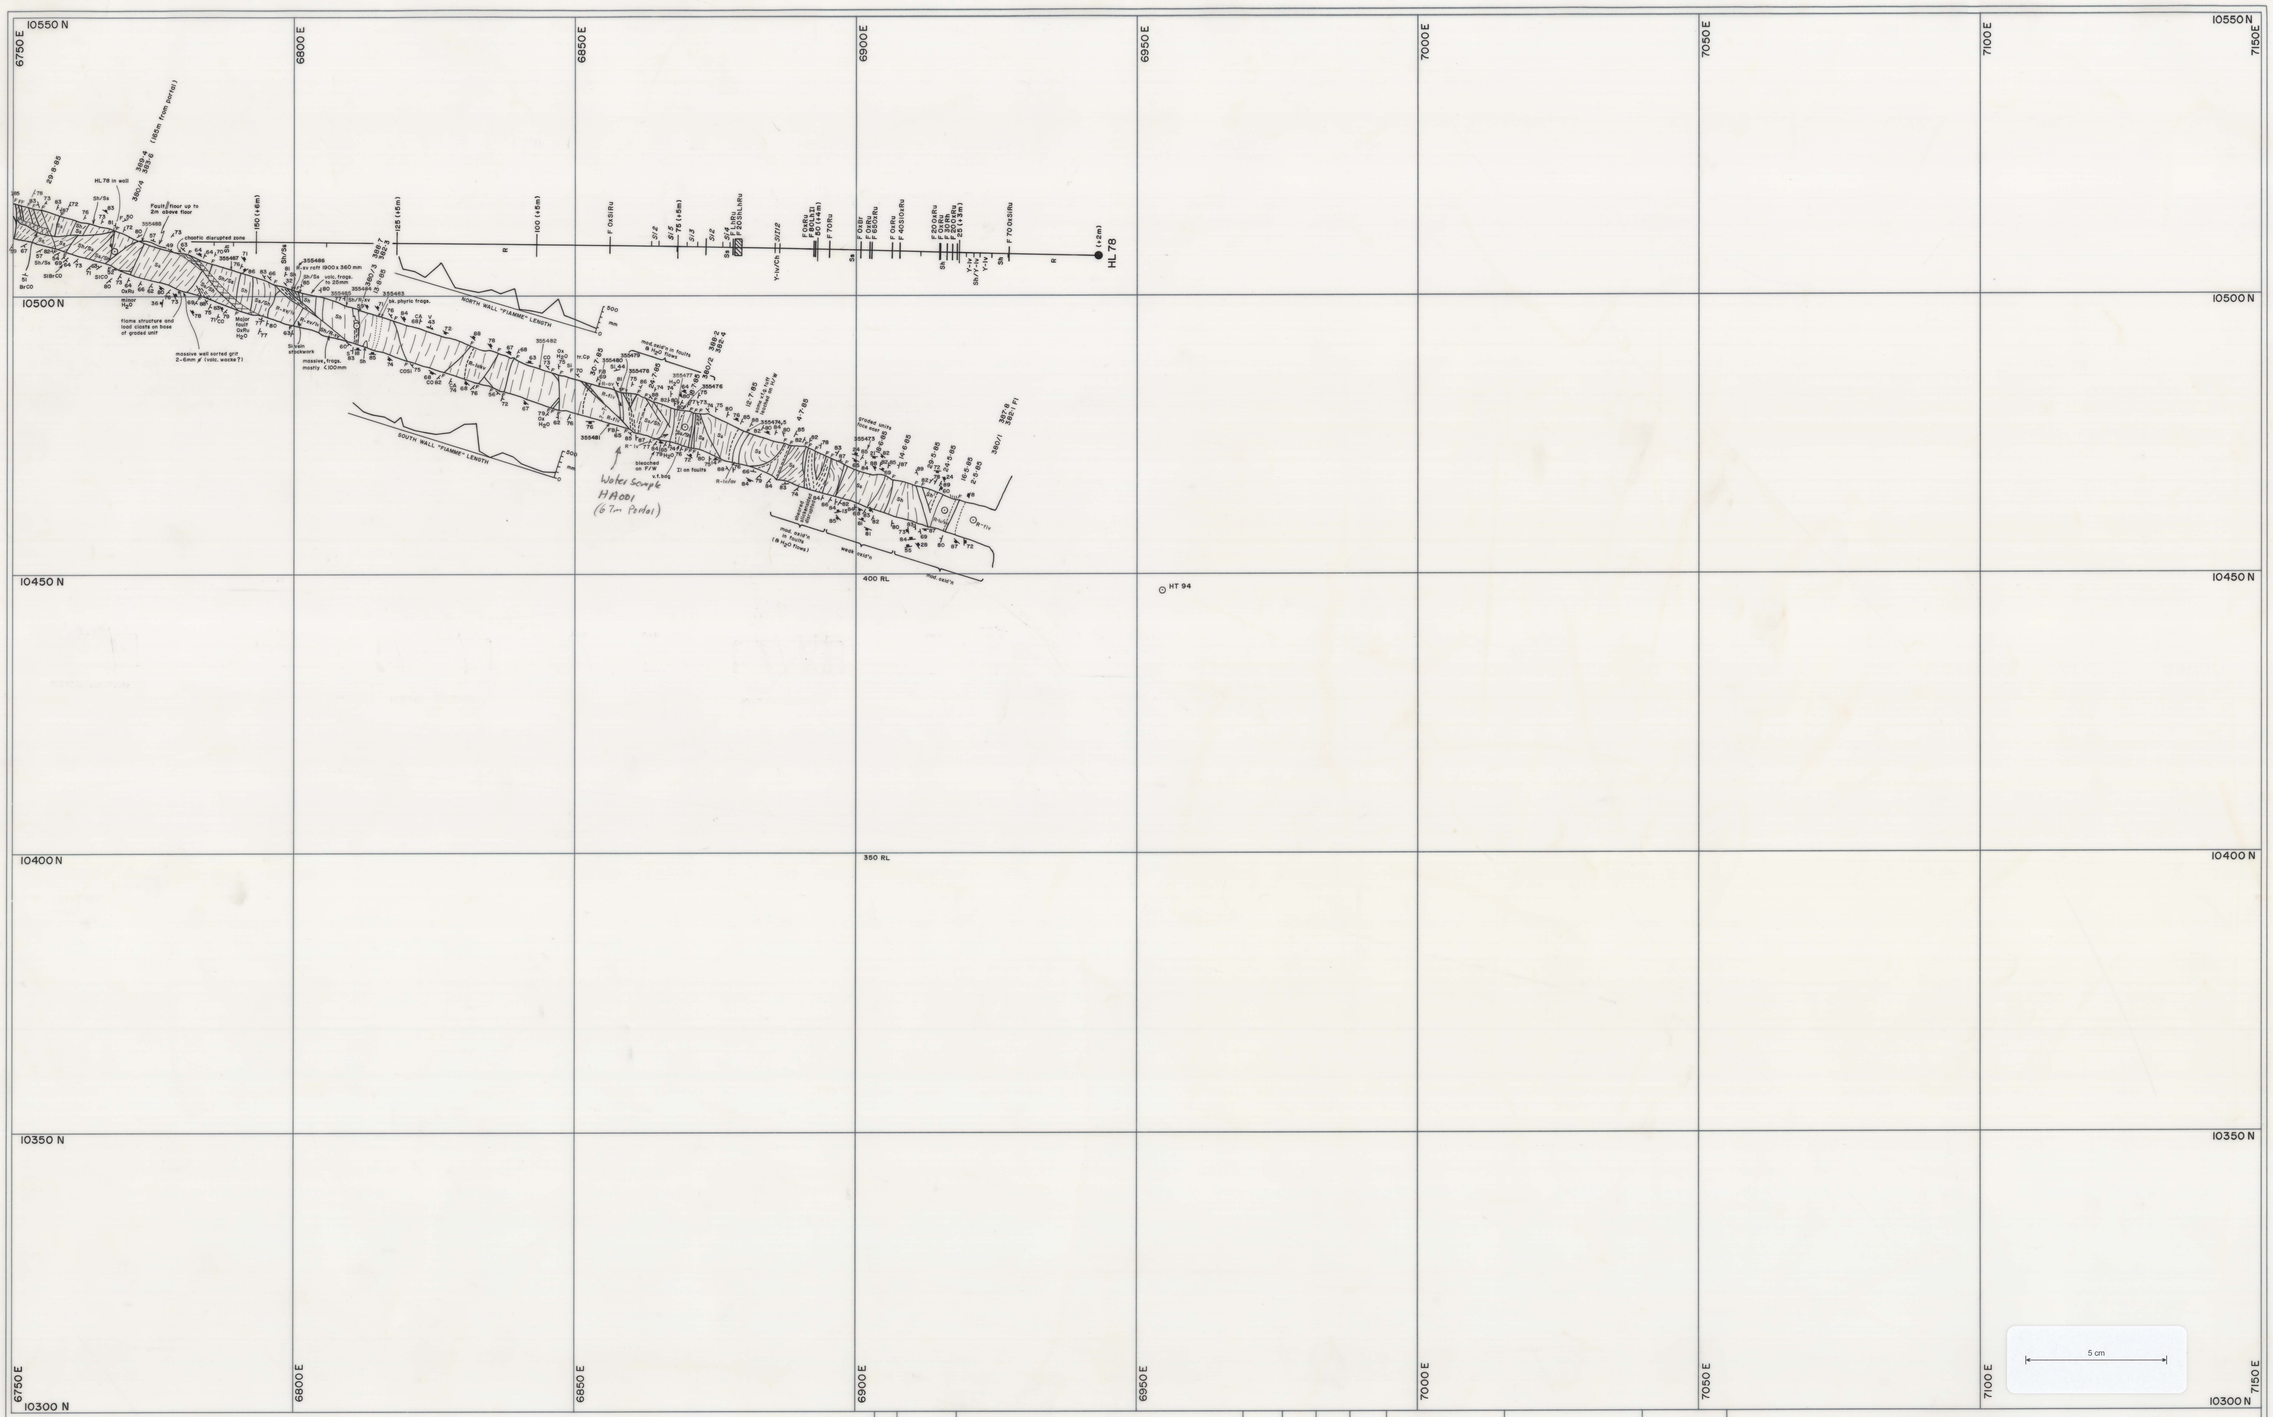

REV	DATE	REVISION	DRAWN	CKD	APP	APP

NORTH

SCALE 1: 500		Sheet No. 1055-715
DRAWN	GLC	18·9·85
CHECKED		
DESIGNED		
DESIGN CKD		
DESIGN APP		
PROJECT APP		

MACKINTOSH MINING PTY LTD

PROJECT : HELLYER PROJECT

380 LEVEL

DRAWING NO. HEL 66

REVISION

HEL 66

L 4276

04-06-444