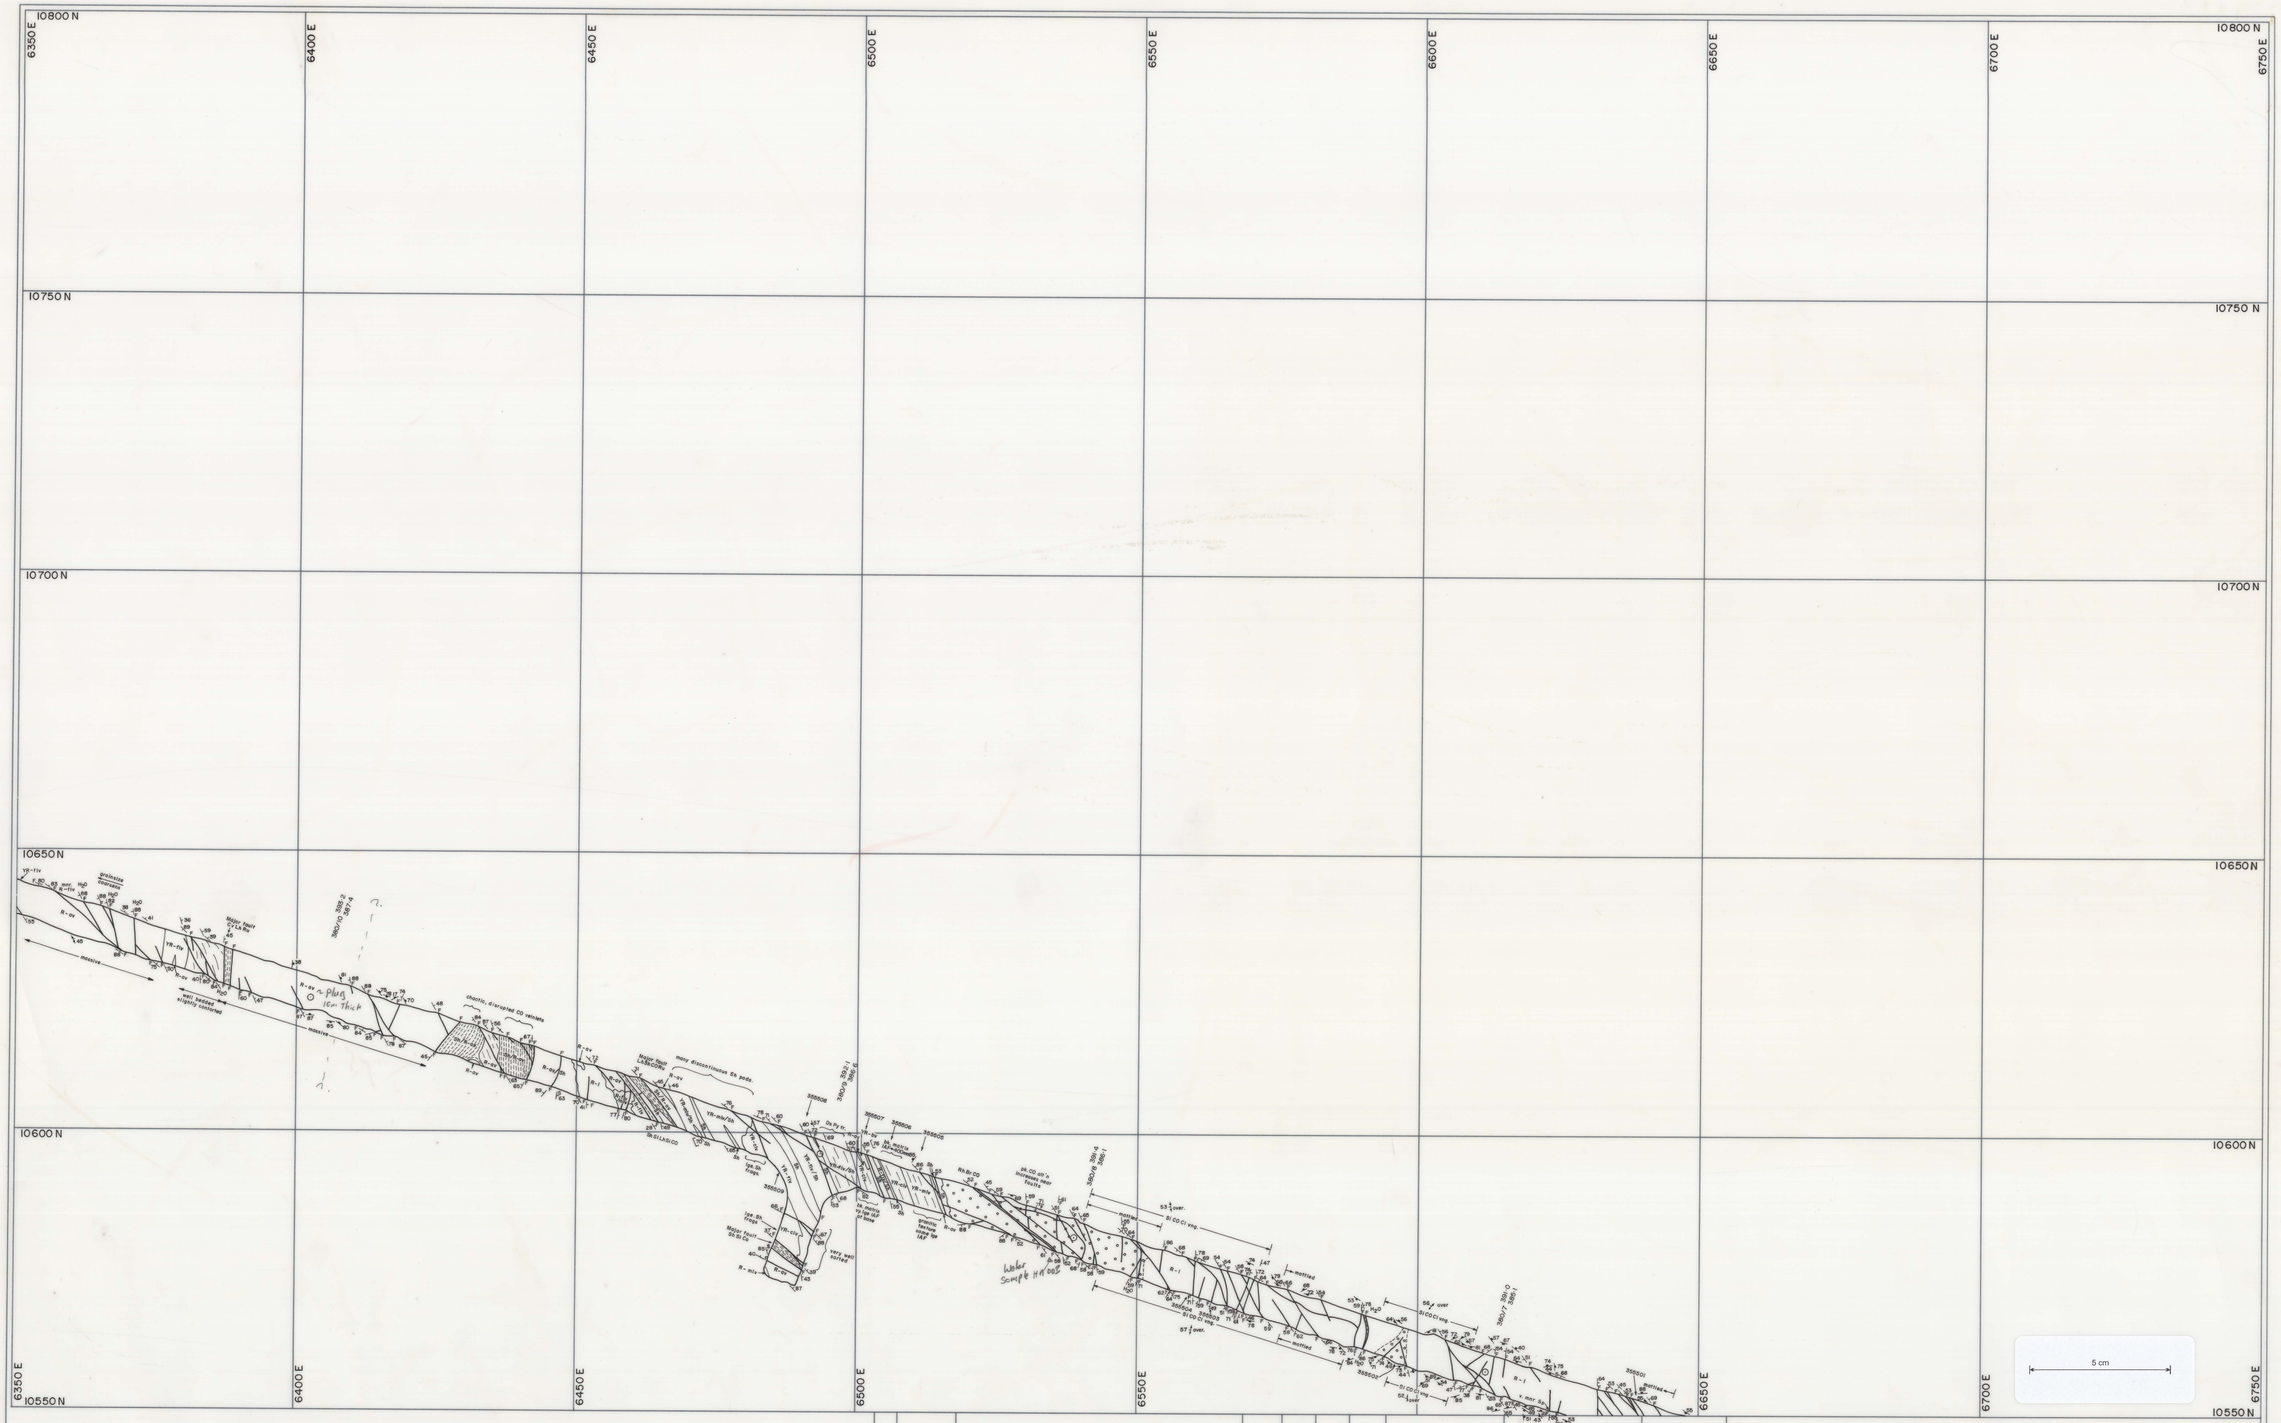

REV	DATE	REVISION	DRAWN	CKD	APP	APP

NORTH

SCALE 1: 500

Sheet No. 1080-675

DRAWN	TN	30·7·86
CHECKED		
DESIGNED	GJ McA	
DESIGN CKD		
DESIGN APP		
PROJECT APP		

MACKINTOSH MINING PTY LTD

PROJECT : HELLYER PROJECT

380 LEVEL

DRAWING NO.

REVISION

L4276

0406-446

(4)