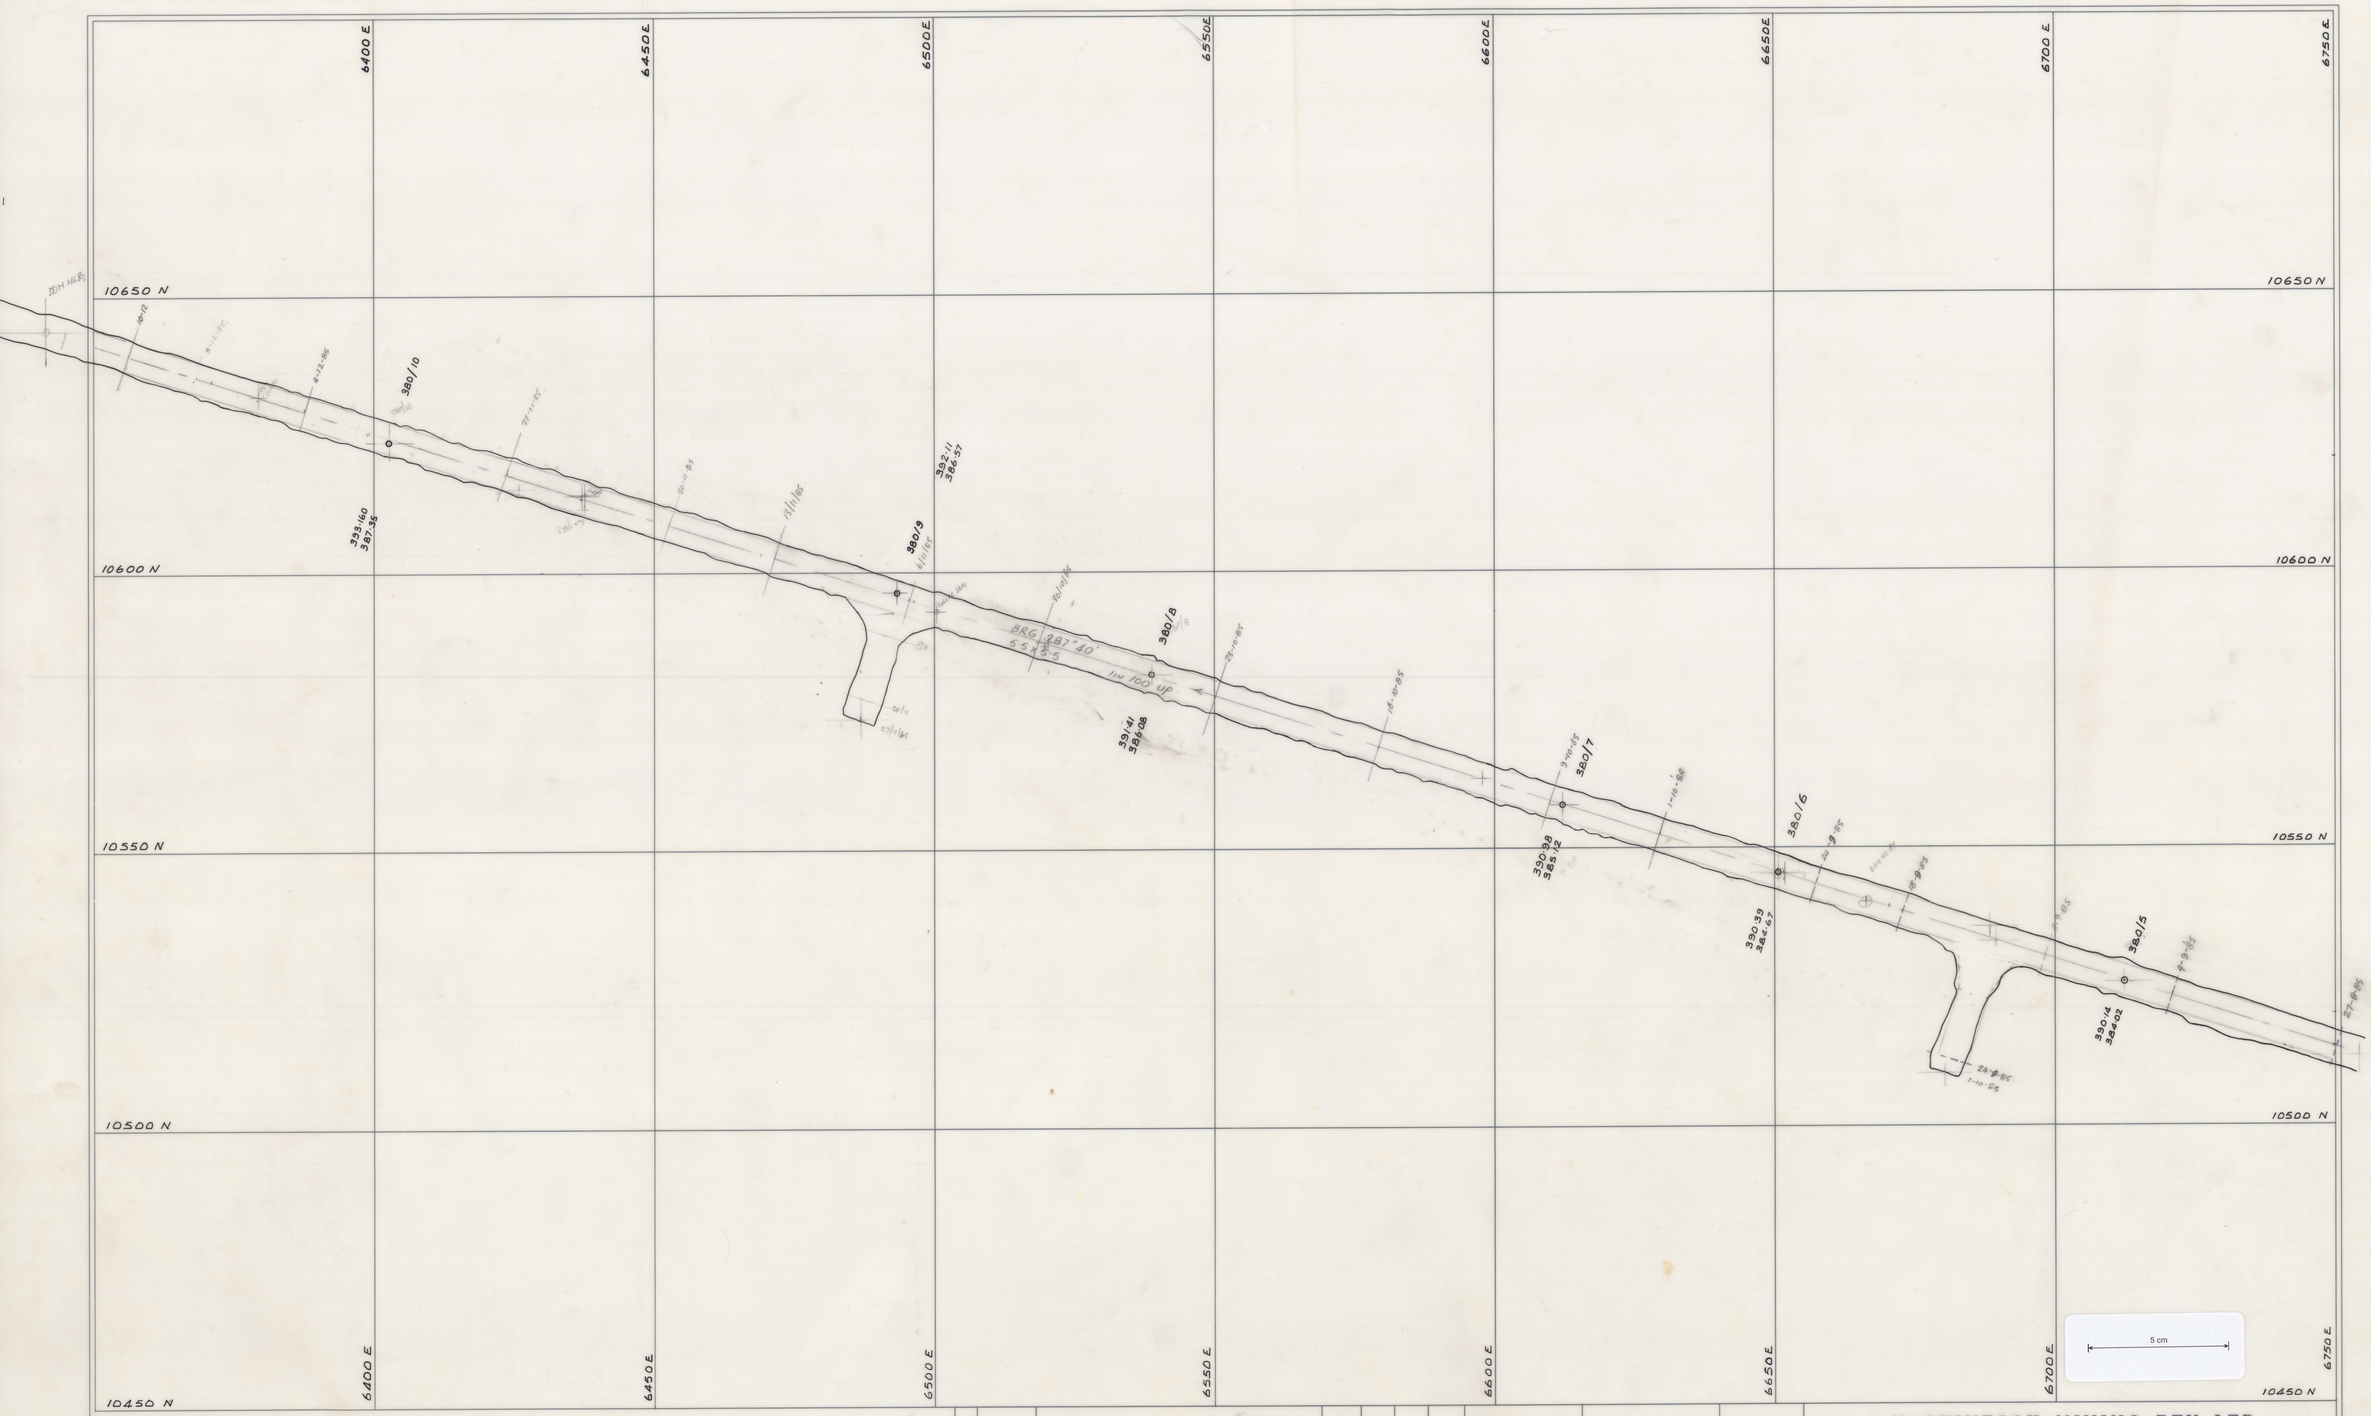

REV	DATE	REVISION	DRAWN	CKD	APP	APP

NORTH

SCALE 1:500

DRAWN	YB	6-9-85
CHECKED		
DESIGNED		
DESIGN CKD		
DESIGN APP		
PROJECT APP		

MACKINTOSH MINING PTY LTD

PROJECT : EXPLORATION ADIT

380 m LEVEL
ADIT SILL PLAN

SHEET 2

DRAWING NO. HEL-010-124

REVISION

0406-448