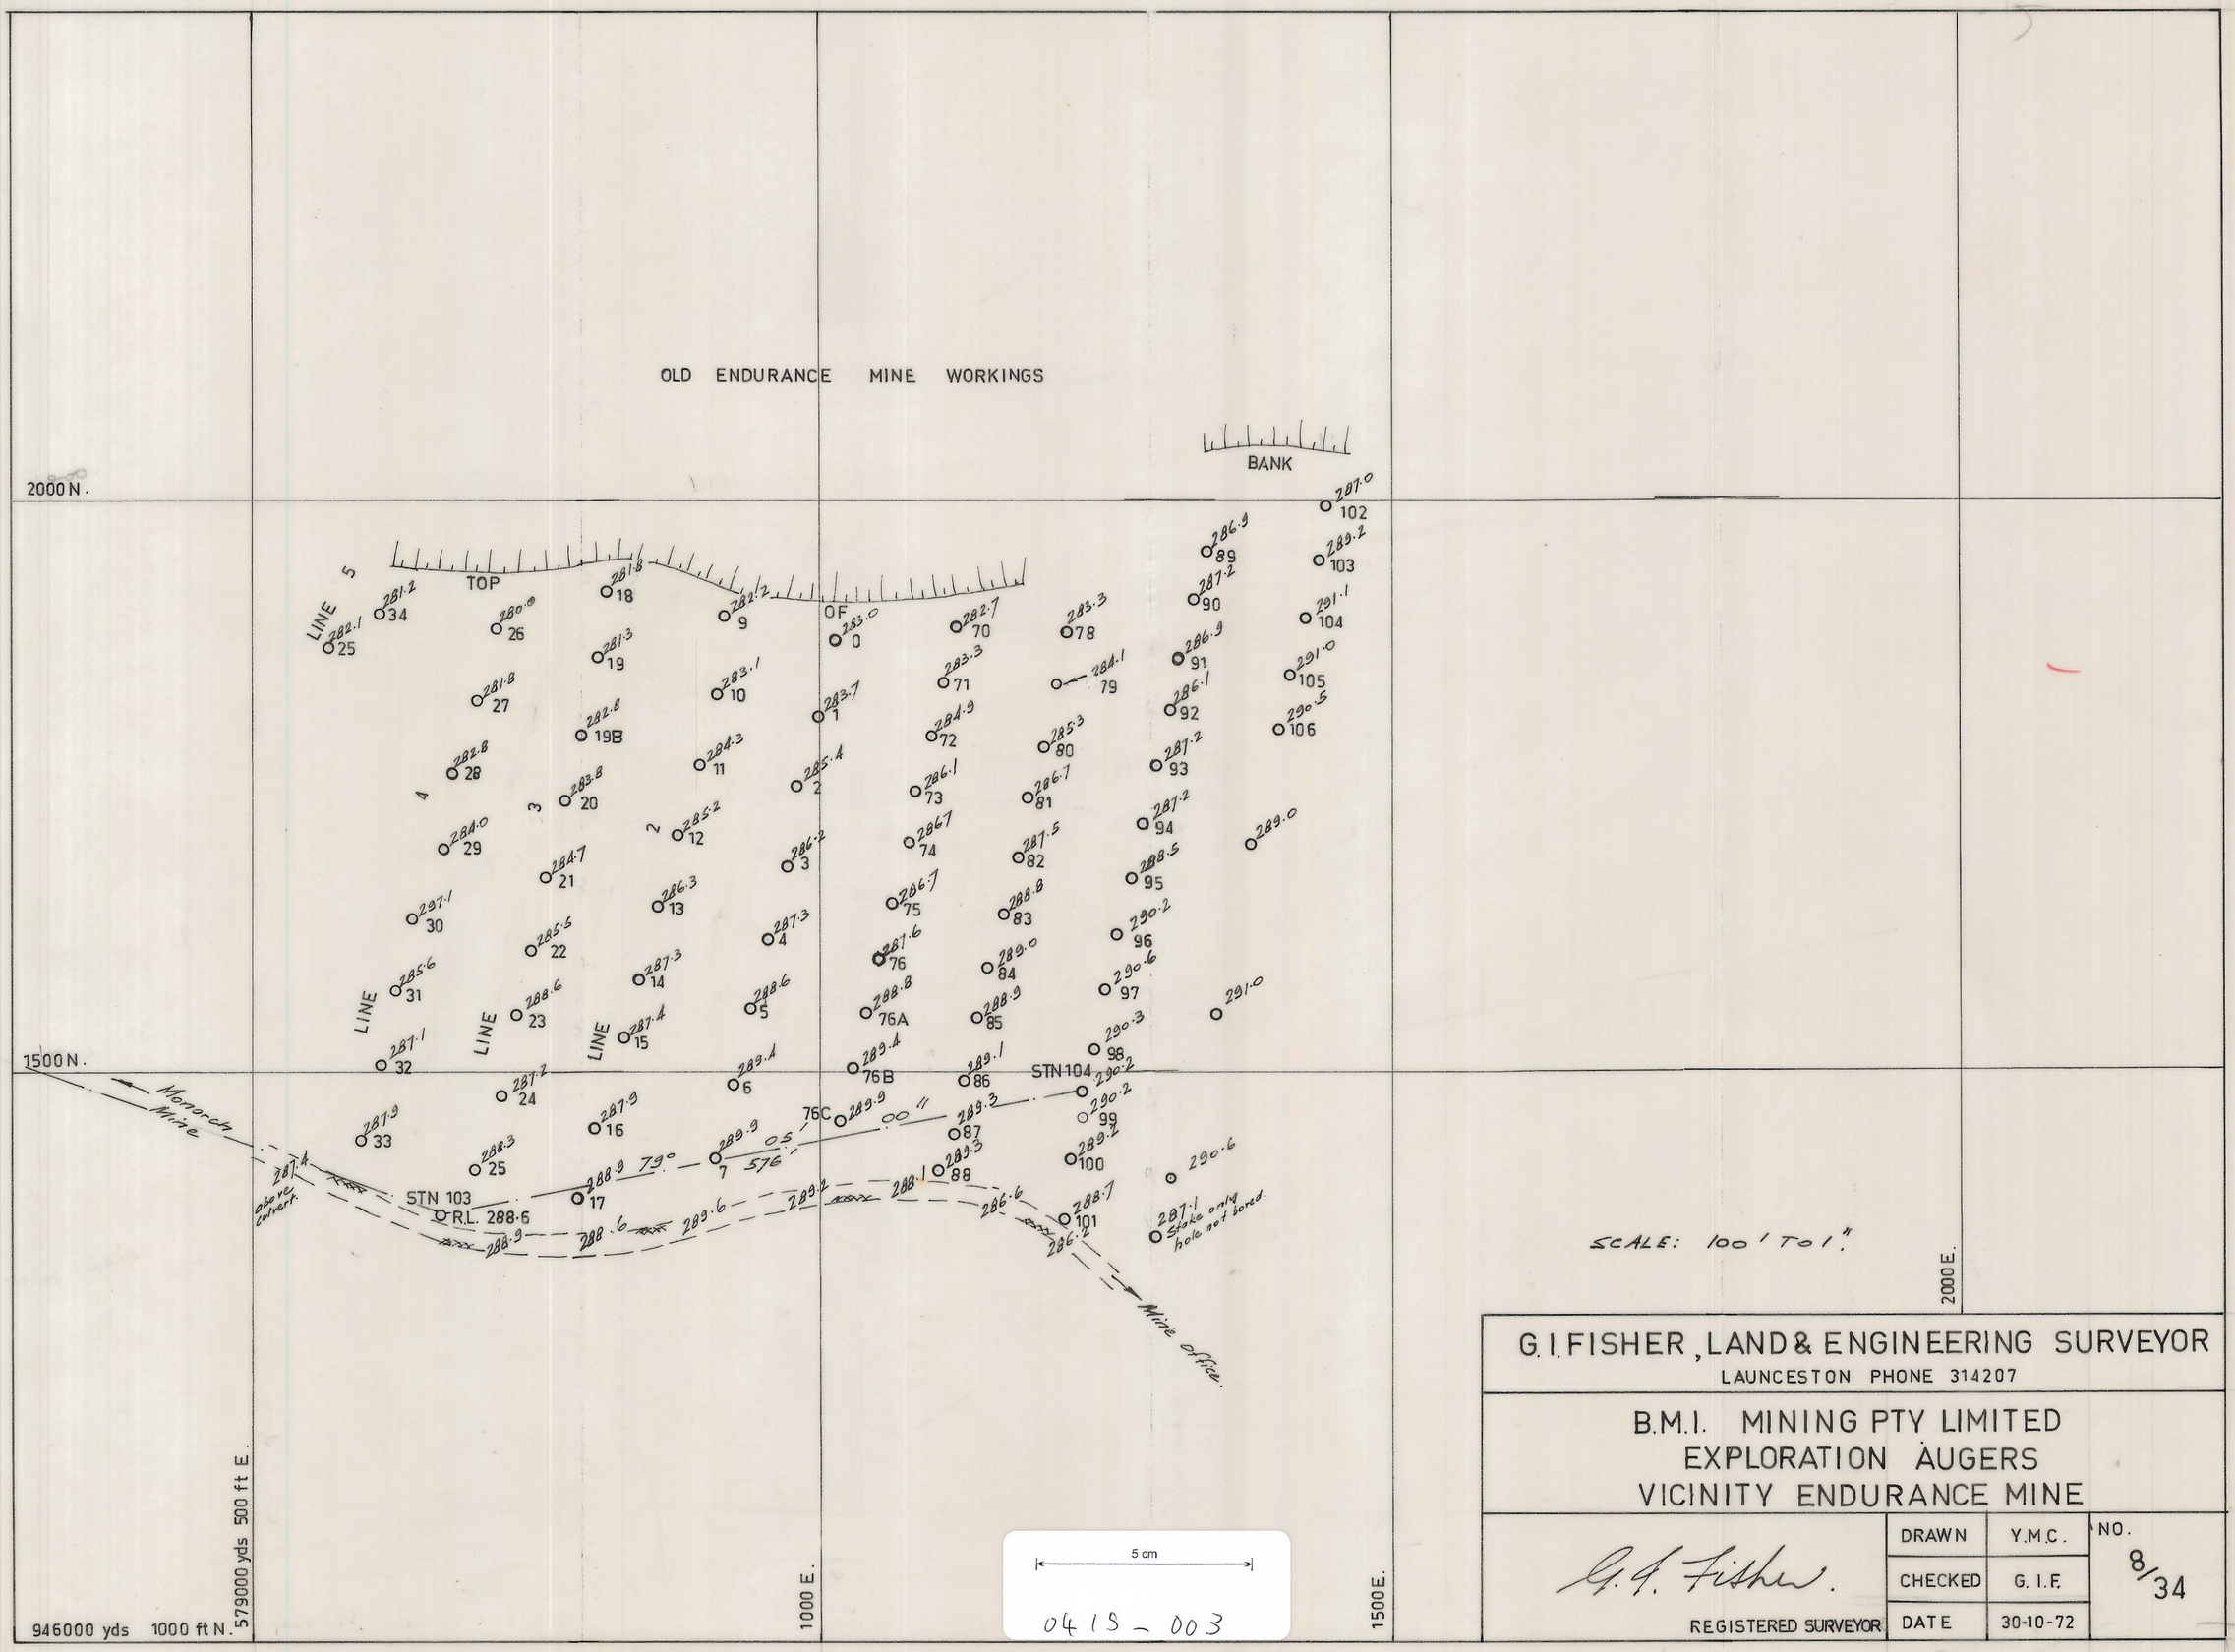

G. I. FISHER, LAND & ENGINEERING SURVEYOR
LAUNCESTON PHONE 314207

B.M.I. MINING PTY LIMITED
EXPLORATION AUGERS
VICINITY ENDURANCE MINE

G. I. Fisher.	DRAWN	Y.M.C.	NO. 8/34
	CHECKED	G. I. F.	
REGISTERED SURVEYOR	DATE	30-10-72	

0419 – 003