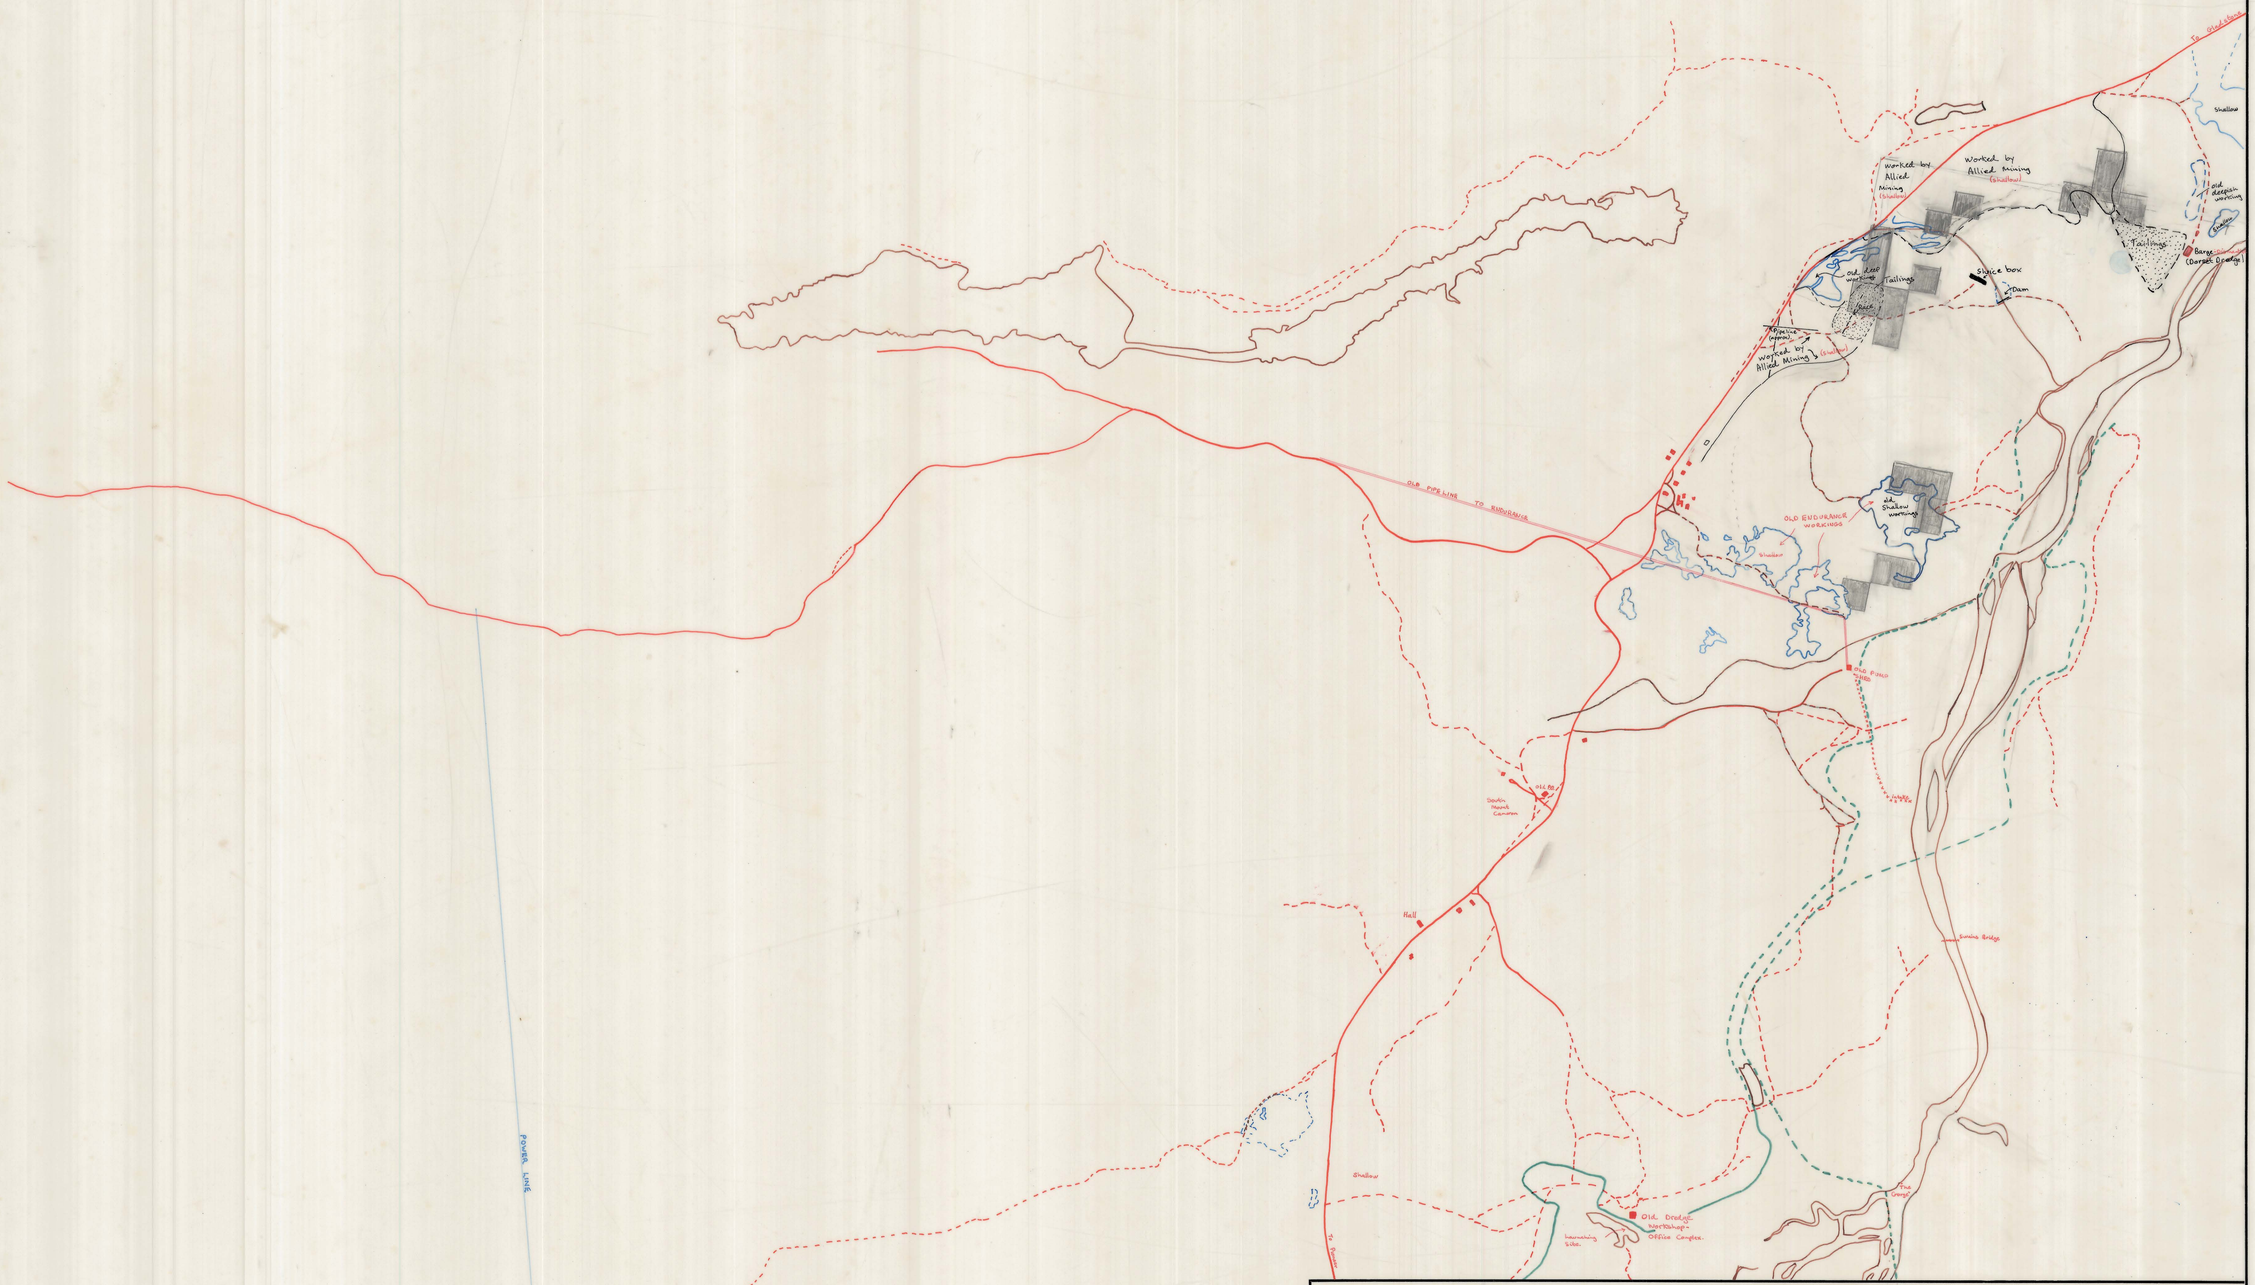

KIBUKA MINES PTY. LTD.

3.3km 33cm = 100,000

280 cm = 3.3 km

3.3

330,000 cm 1: 1178.37

225

1:1178.

1: 6700.10

15.5 = 22.5

25 = 37.5

15.5km

22.5 c

1K = 22.5/25

1449/1500

0415-008

0415-008

.6988

.6066