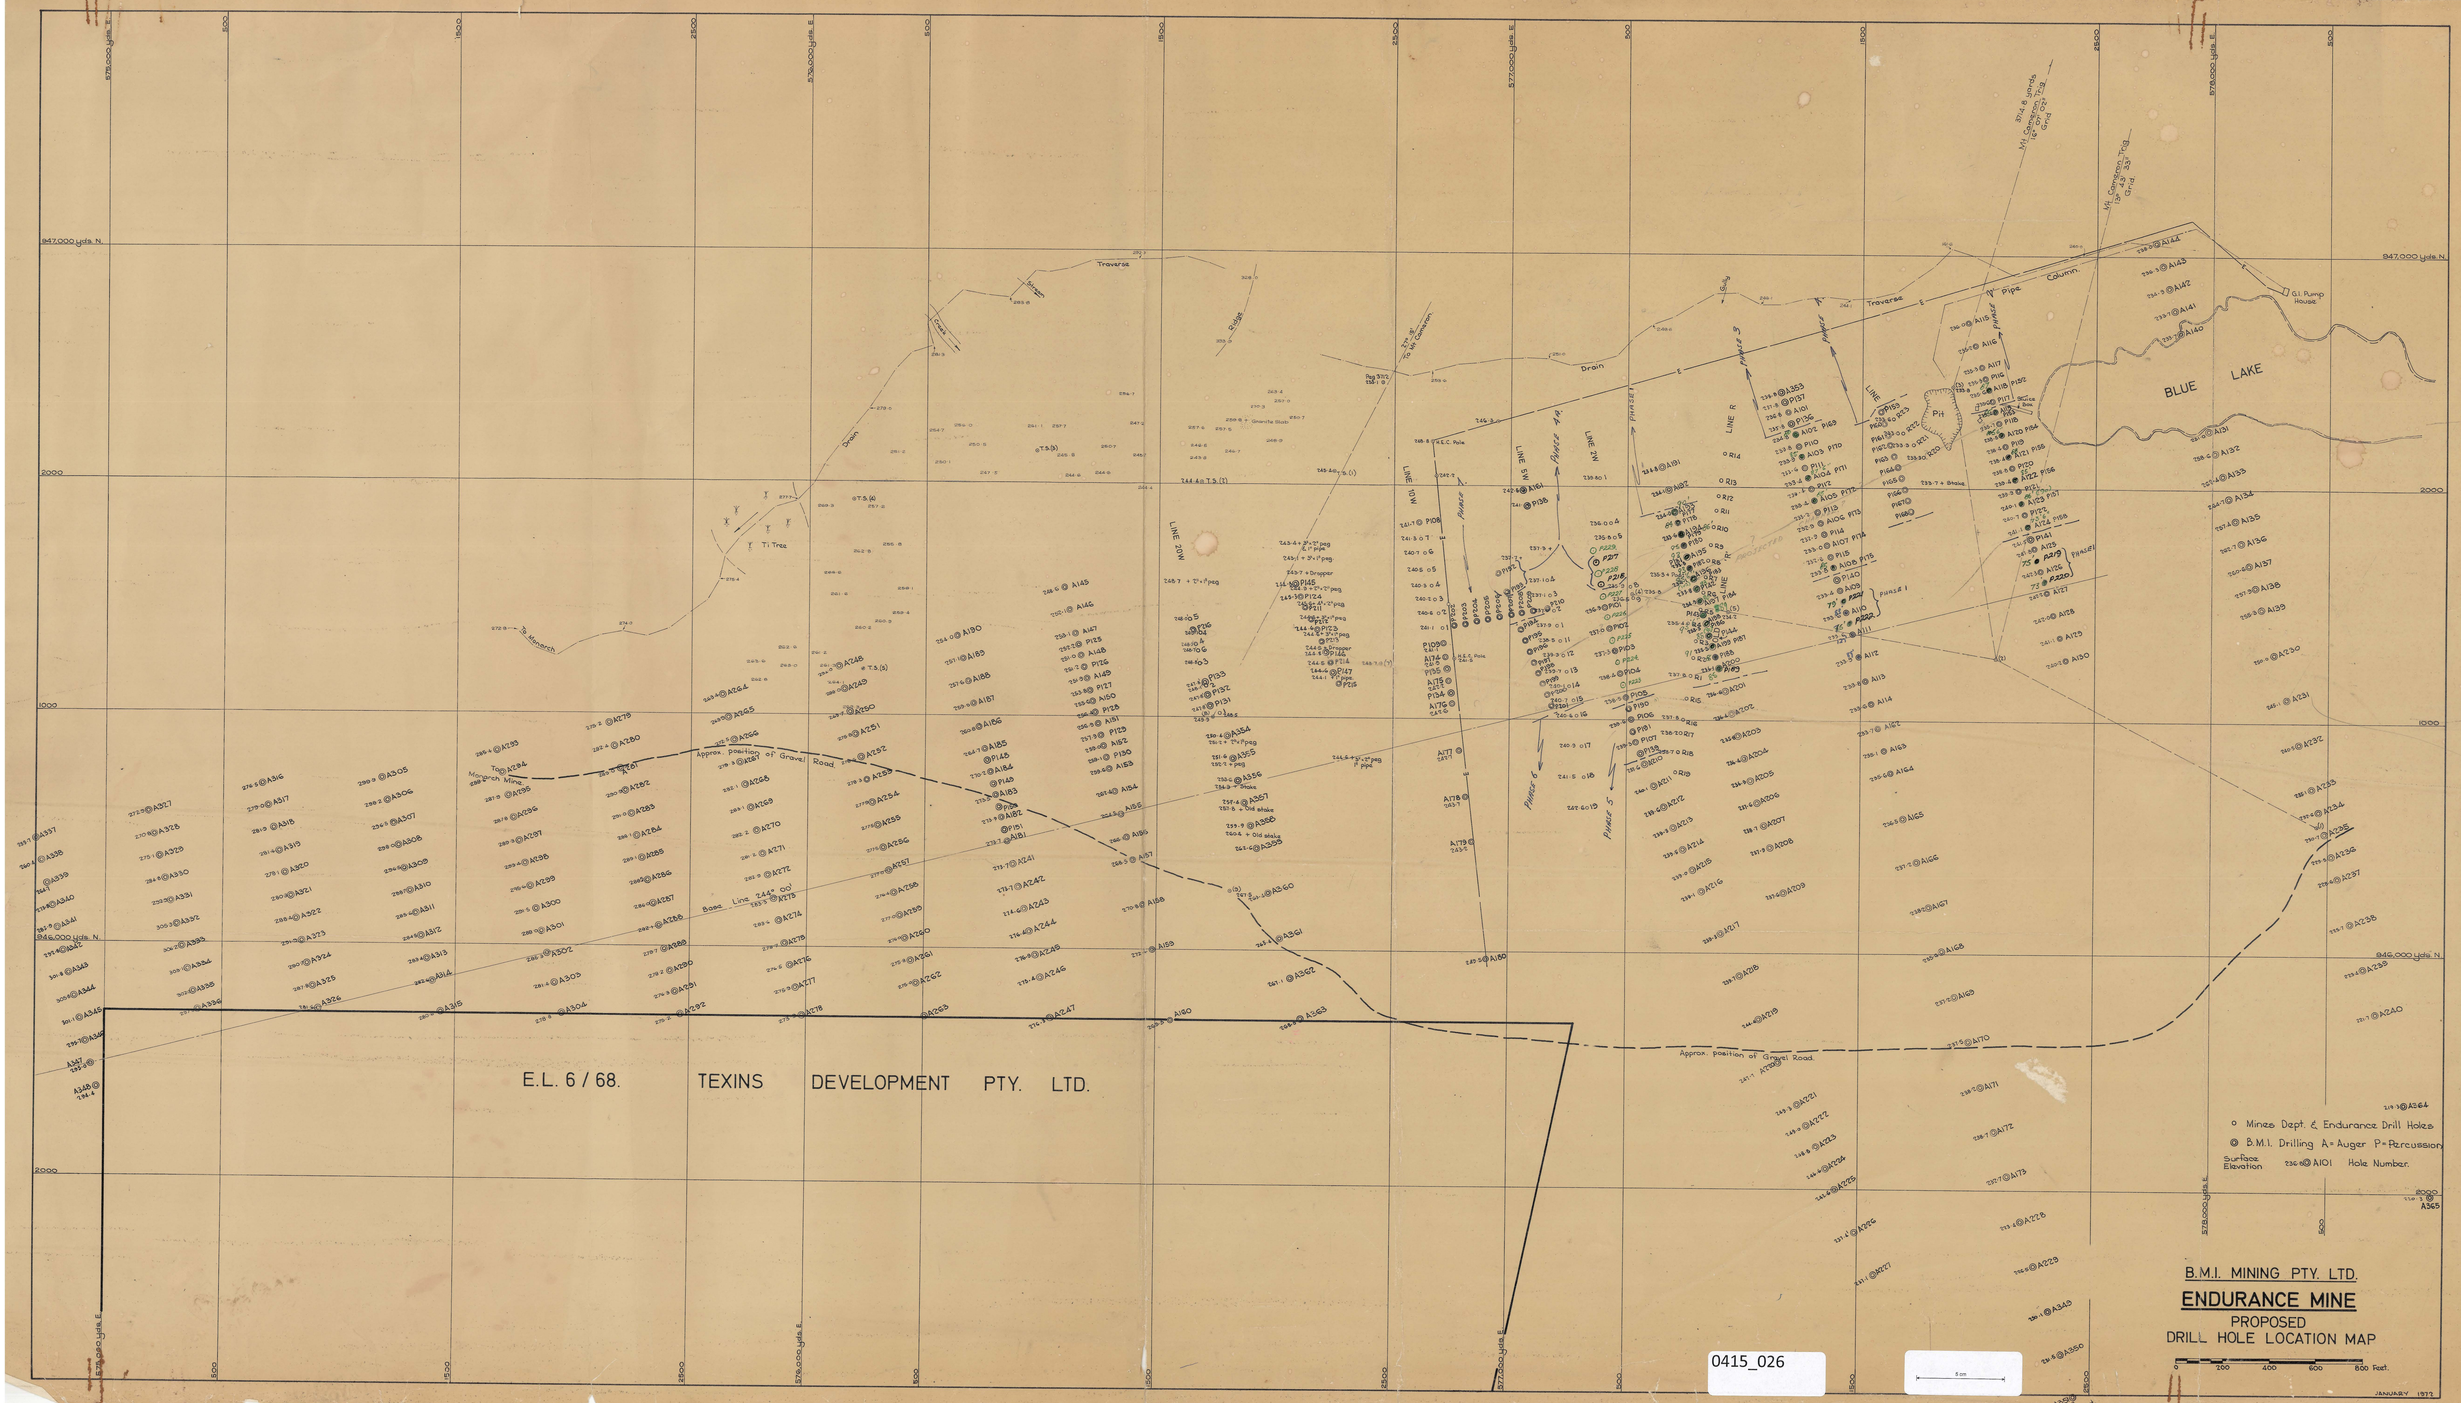

B.M.I. MINING PTY. LTD.

ENDURANCE MINE

PROPOSED
DRILL HOLE LOCATION MAP

0415_026

0415_026

Hole location 1/72