


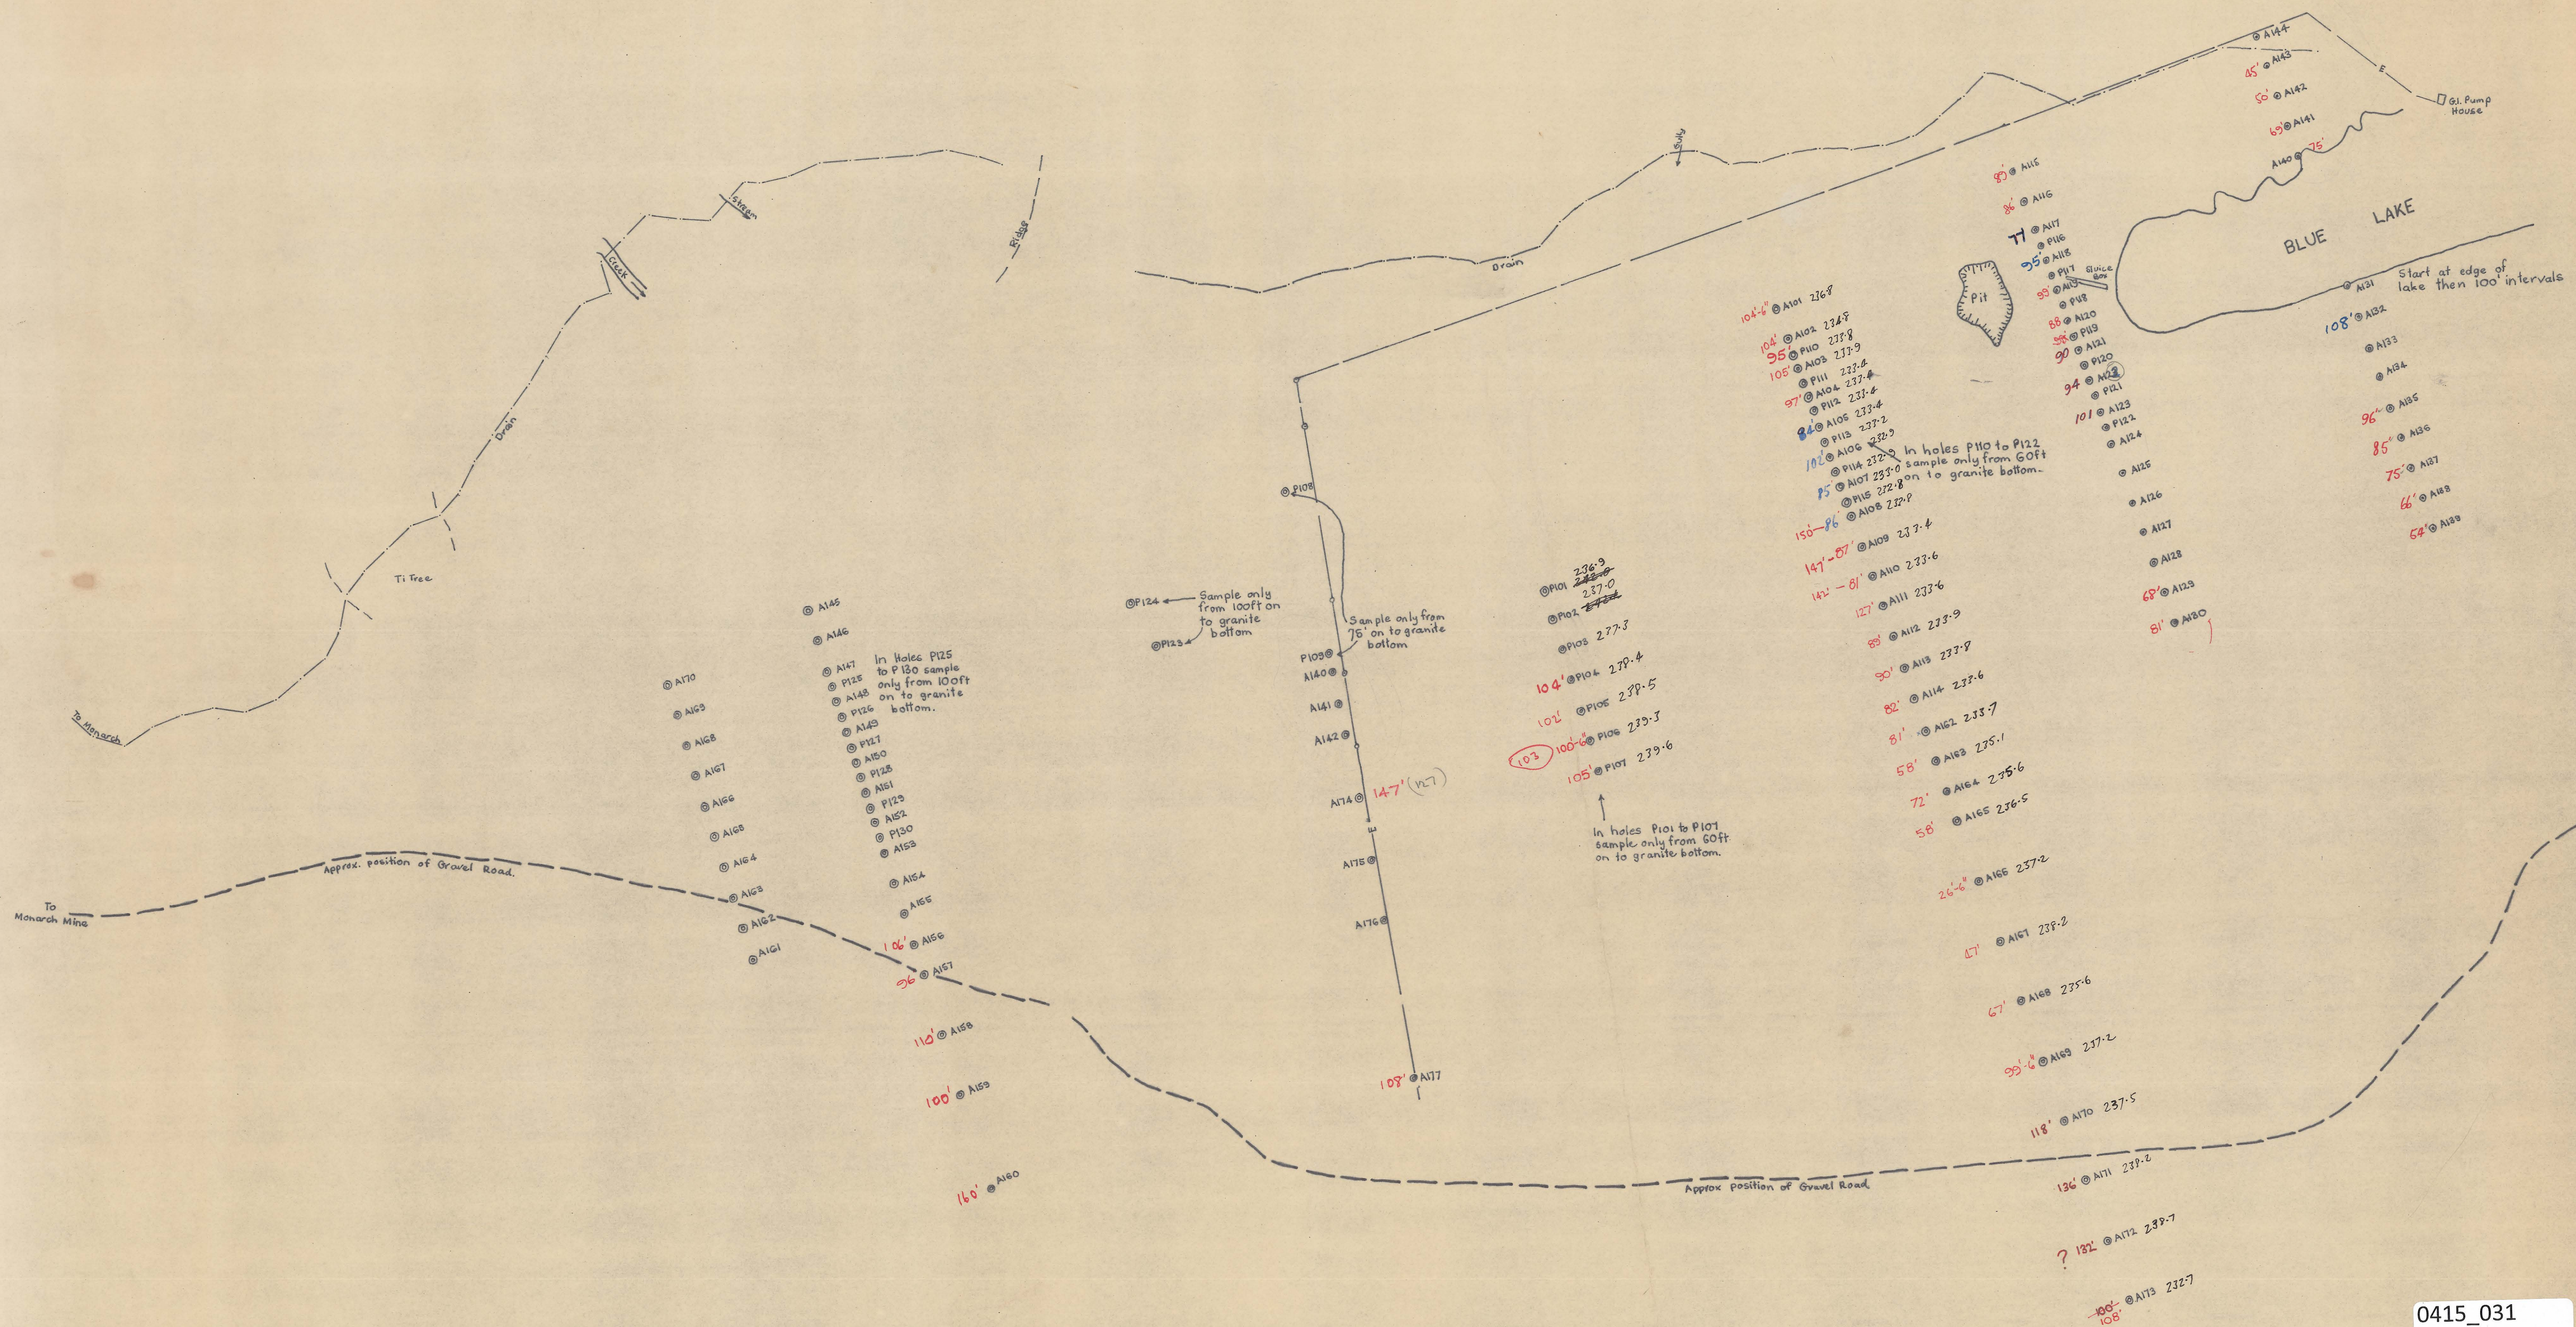

© BMI Drilling A=Auger P=Percussion.

B.M.I. MINING PTY. LTD.
ENDURANCE MINE
PROPOSED
DRILL HOLE LOCATION

0 200 400 600

OFFICE