

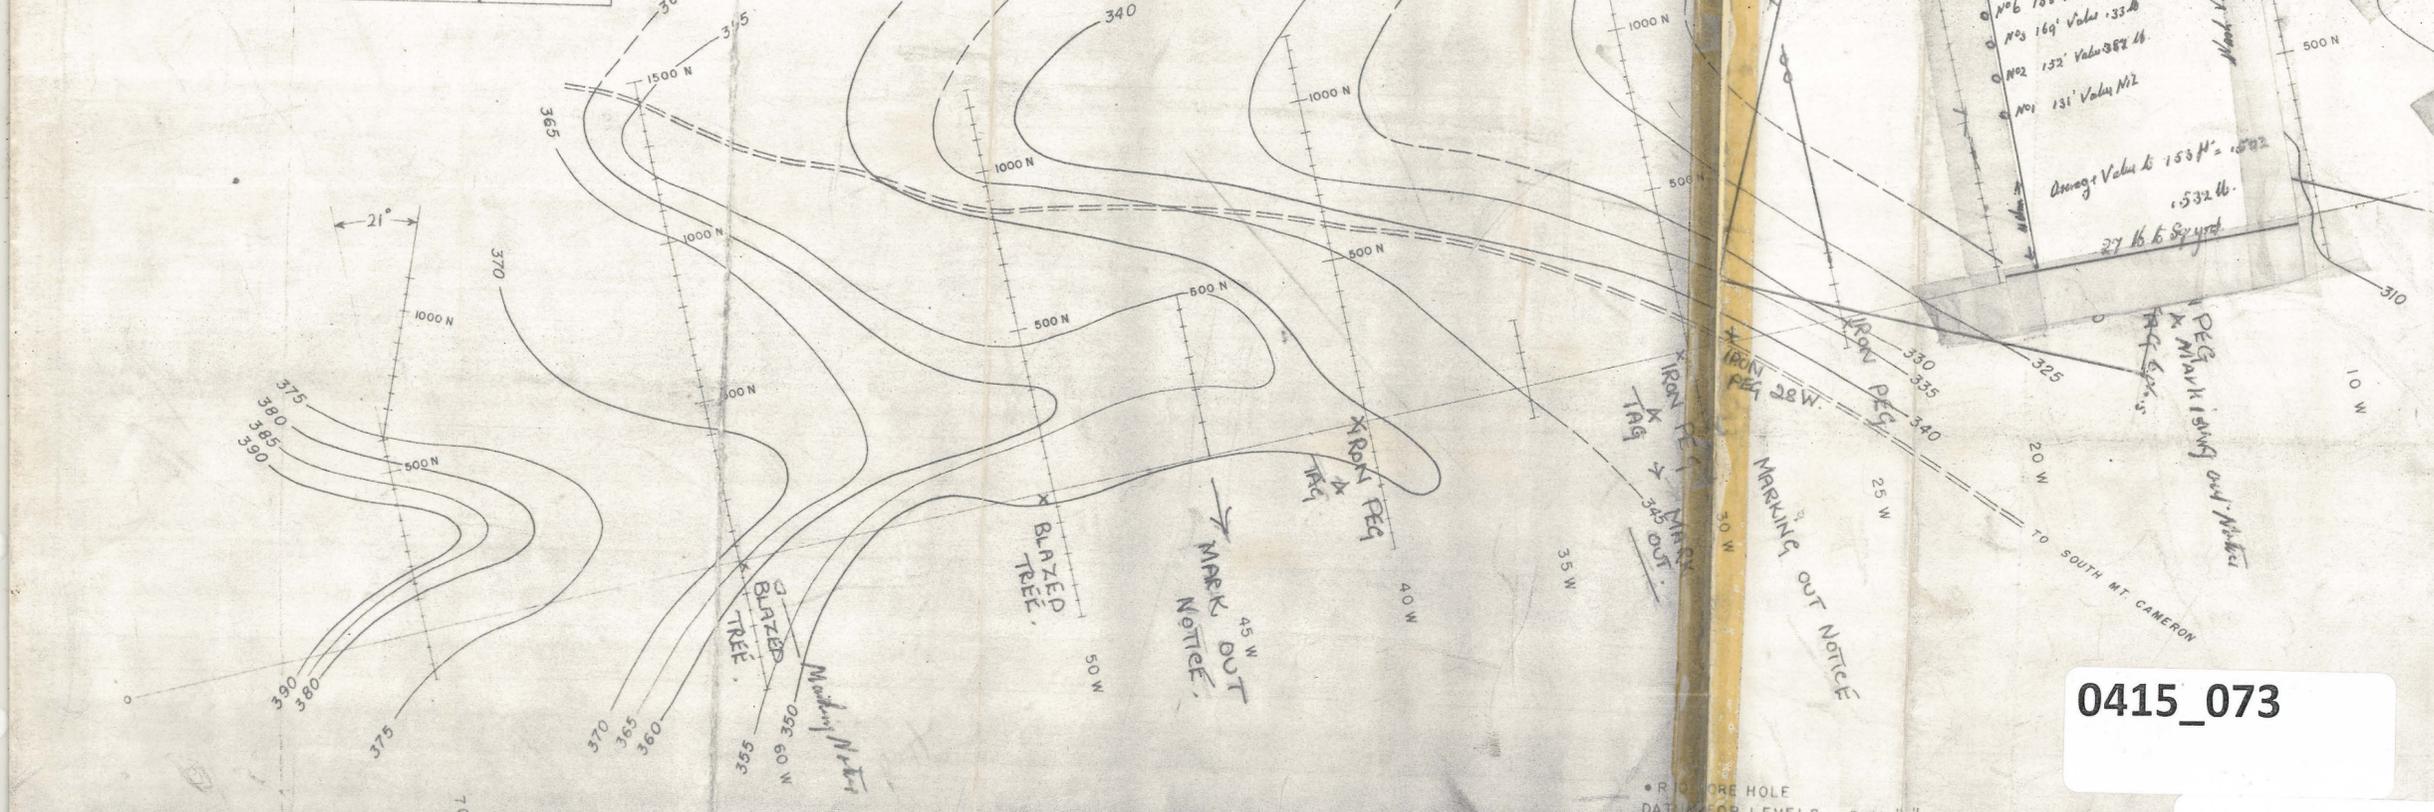


0415_073

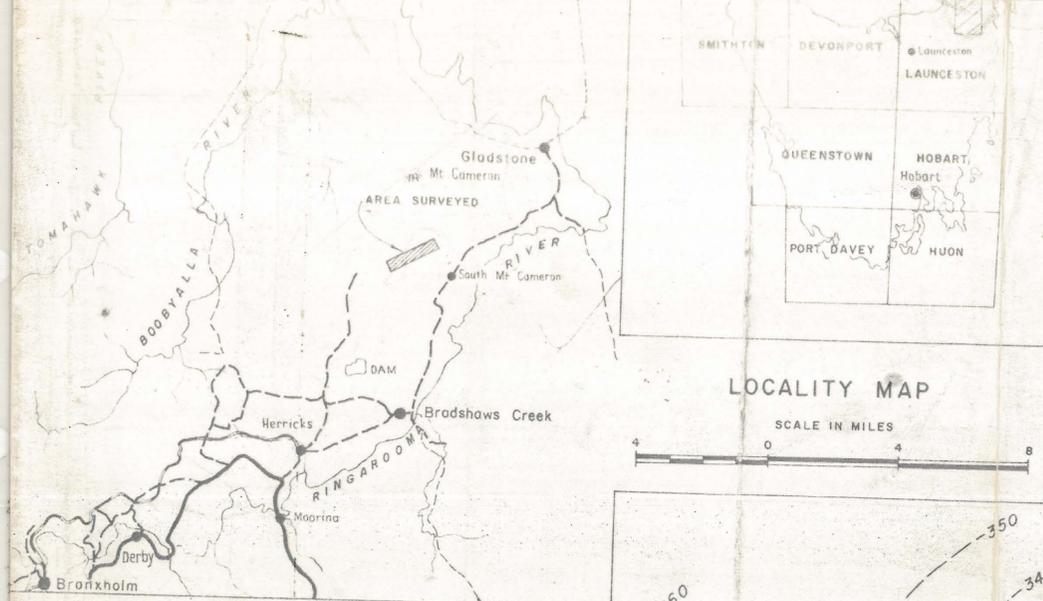

0415_073

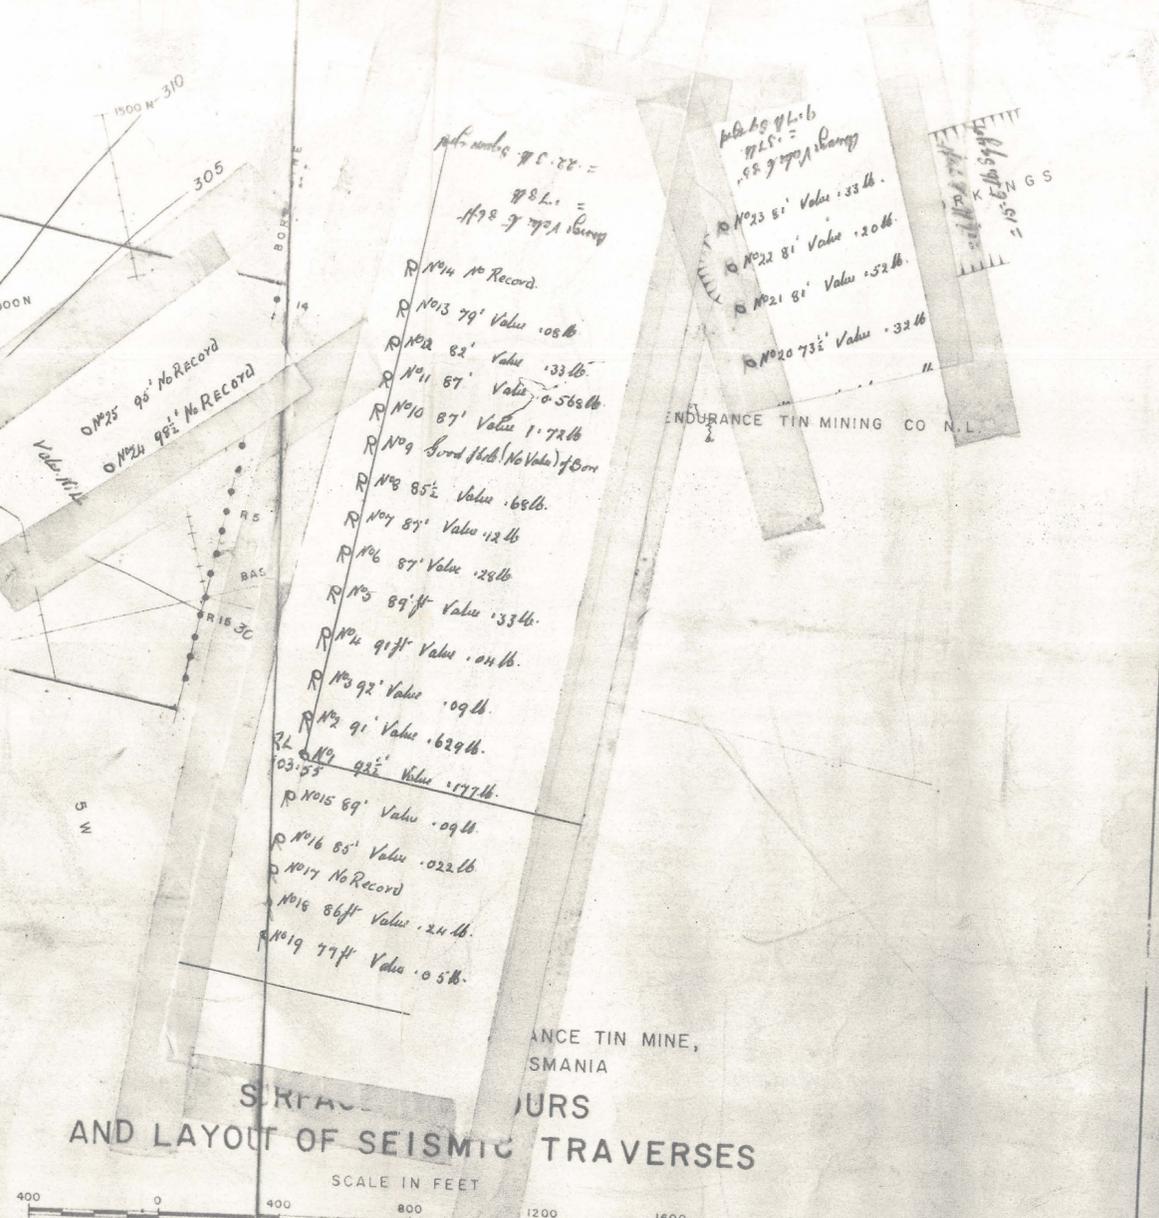

Kearney
GEOPHYSICIST

1500 N-310
 305
 1000 N
 1000 N
 500 N
 500 N
 310
 10 W
 5 W
 10 W
 20 W
 25 W
 30 W
 40 W
 50 W
 70 W

Government Ore Rent
 R No 5 120' Value .16 lb.
 R No 4 134' Value 1.2 .16 lb.
 R No 6 158' Value .216 lb.
 R No 3 169' Value .33 lb.
 R No 2 132' Value .82 lb.
 R No 1 131' Value .12
 Average Value to 153 ft. = .532 lb.
 27 lb. to Survey

0125 90' No Record
 0124 95' No Record

R No 14 No Record
 R No 13 79' Value .108 lb.
 R No 12 82' Value .33 lb.
 R No 11 87' Value .568 lb.
 R No 10 87' Value 1.72 lb.
 R No 9 Sound Hole (No Value) of 50 ft
 R No 8 85' Value .68 lb.
 R No 7 87' Value .42 lb.
 R No 6 87' Value .28 lb.
 R No 5 89 ft Value .33 lb.
 R No 4 91 ft Value .04 lb.
 R No 3 92' Value .09 lb.
 R No 2 91' Value .629 lb.
 R No 1 92' Value .177 lb.
 R No 15 89' Value .09 lb.
 R No 16 85' Value .022 lb.
 R No 17 No Record
 R No 18 86 ft Value .24 lb.
 R No 19 77 ft Value .05 lb.


ENDURANCE TIN MINING CO N.L.

ENDURANCE TIN MINE,
 SMANIA
 T.M.S.
 T.M.S. =
