


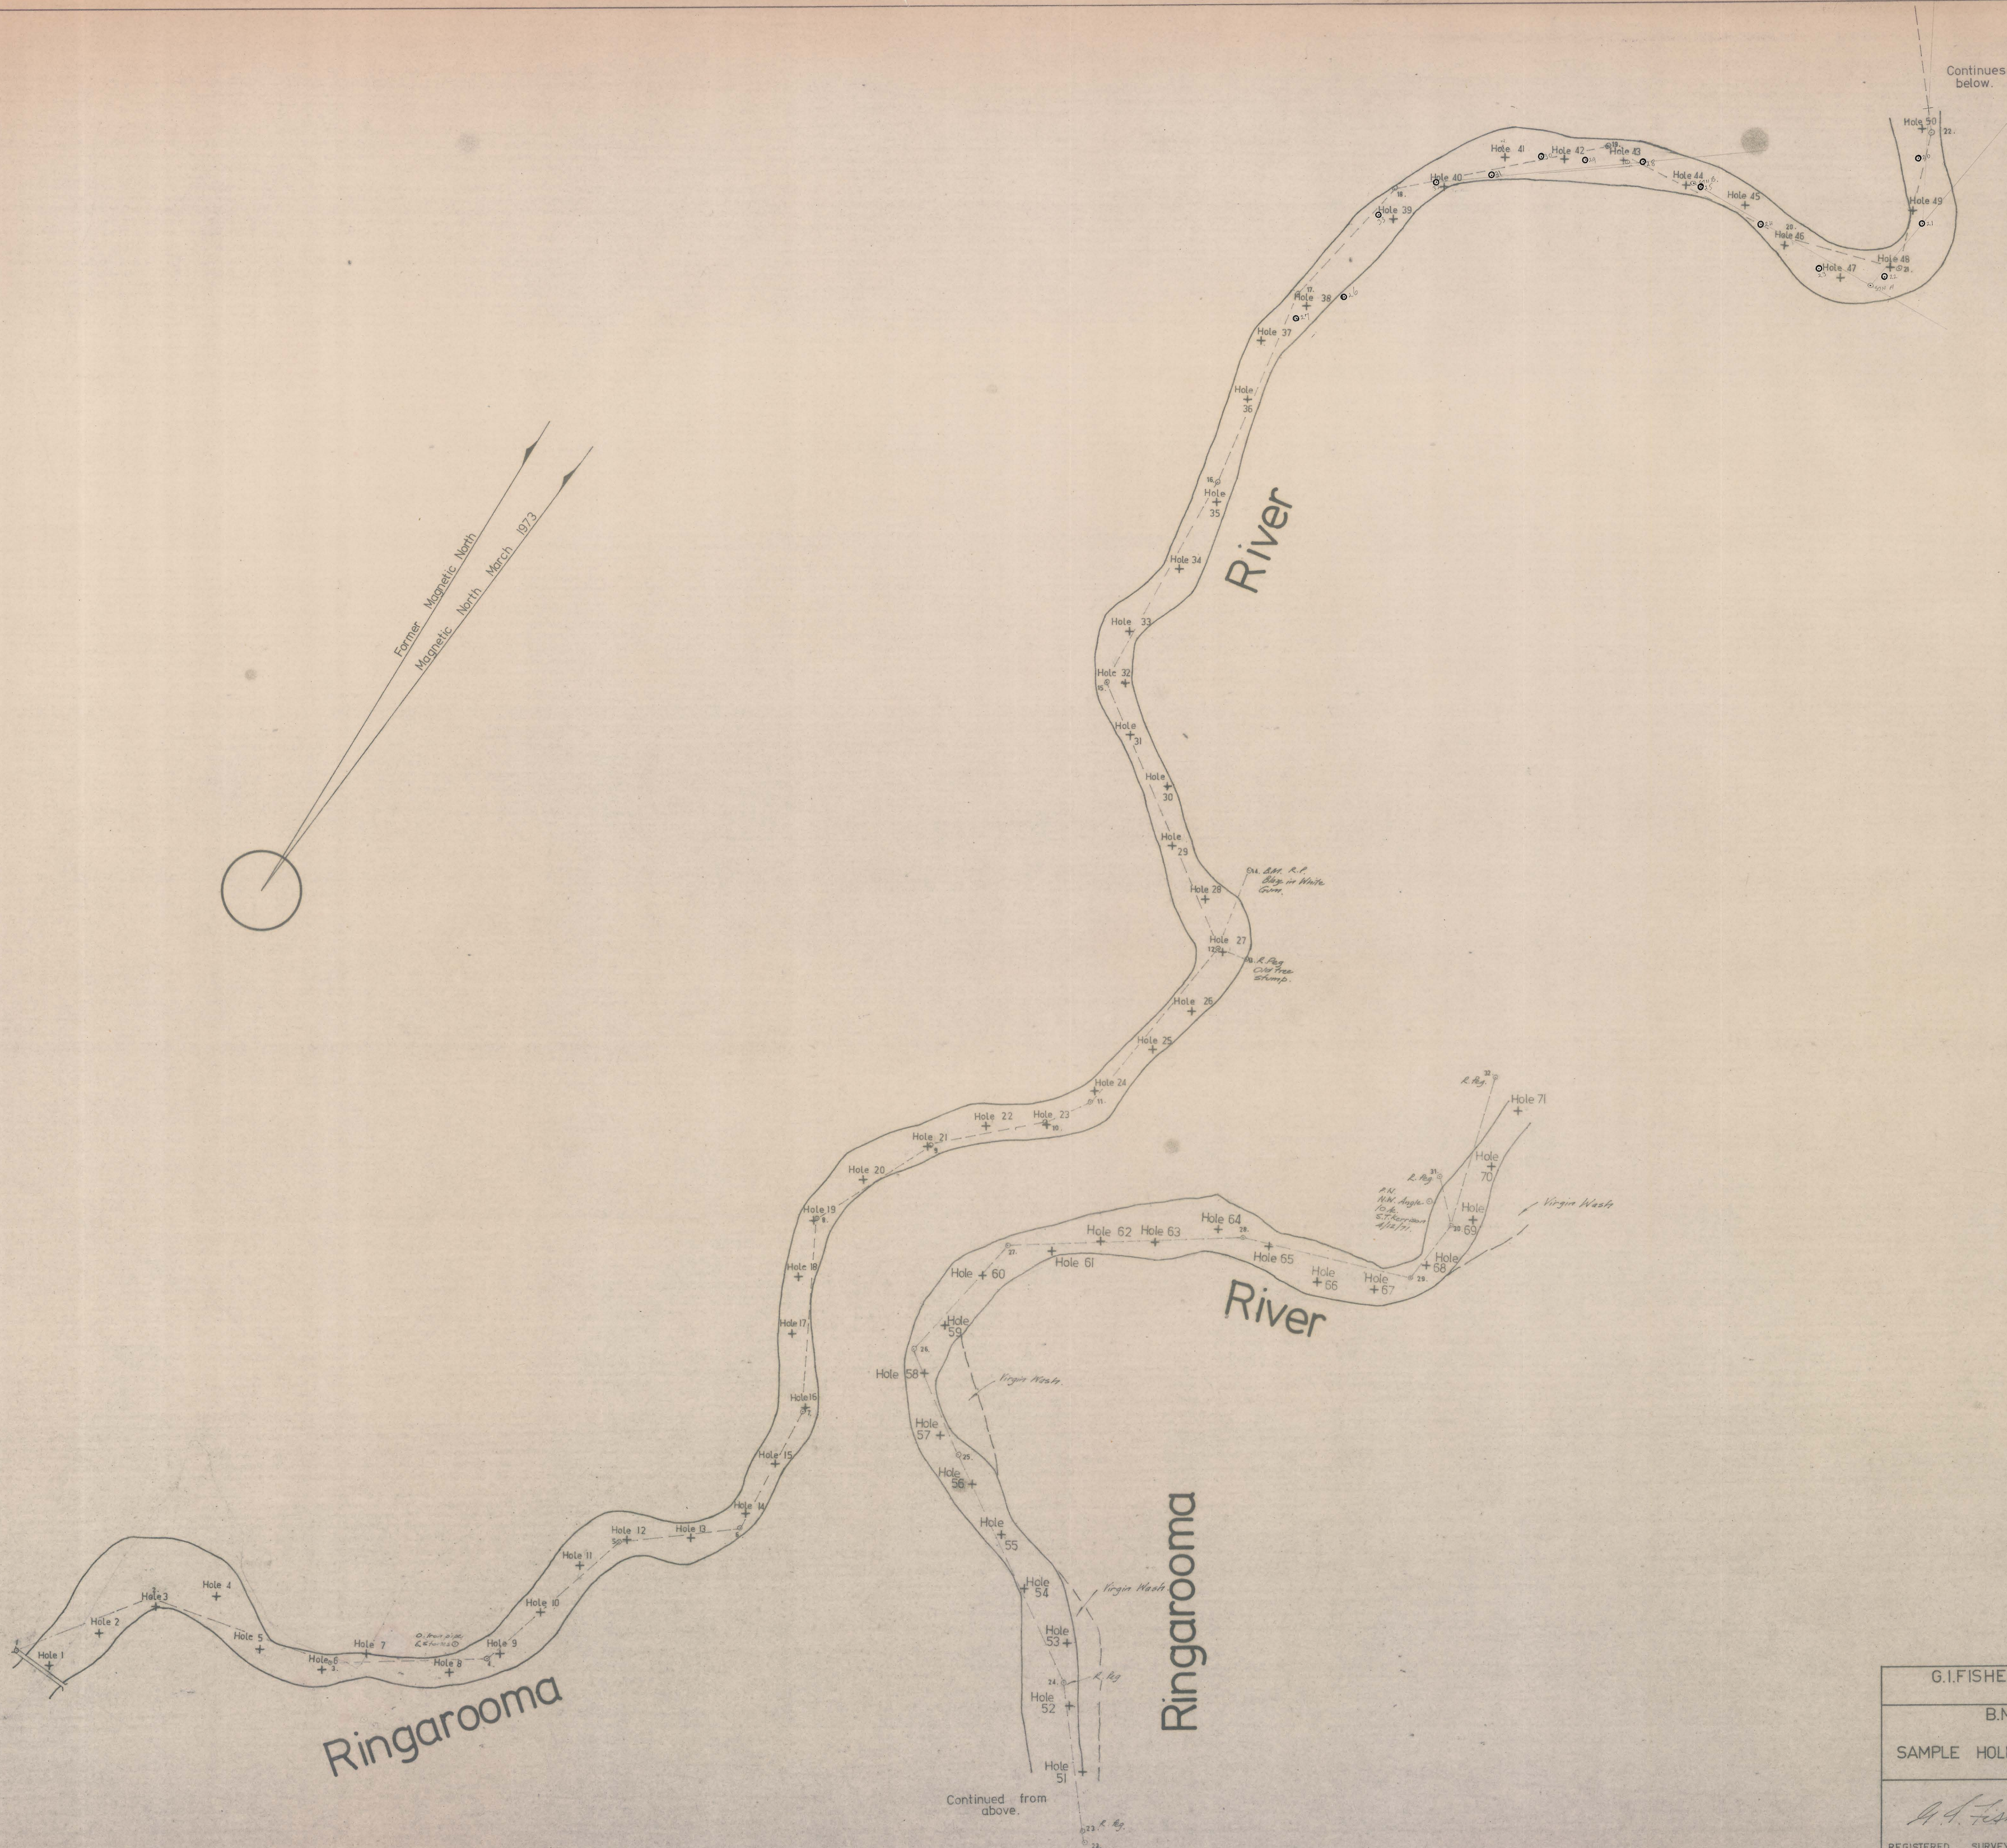

Ringarooma

Ringarooma

River

River

Continues below.

Continued from above.

5 cm
0424-010

G.I. FISHER LAND & ENGINEERING SURVEYOR			
LAUNCESTON PHONE 314207			
B.M.I. MINING PTY. LIMITED			
RINGAROOMA RIVER			
SAMPLE HOLE LOCATIONS & RIVER CROSS SECTION			
 REGISTERED SURVEYOR	SCALE	200 FT. TO AN INCH	NO. 8/38
	DRAWN	J. A. W.	
	DATE	15-3-73	

010-7270