

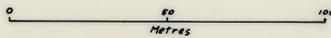


AMDEX - DELTA DRILLING

0426-003

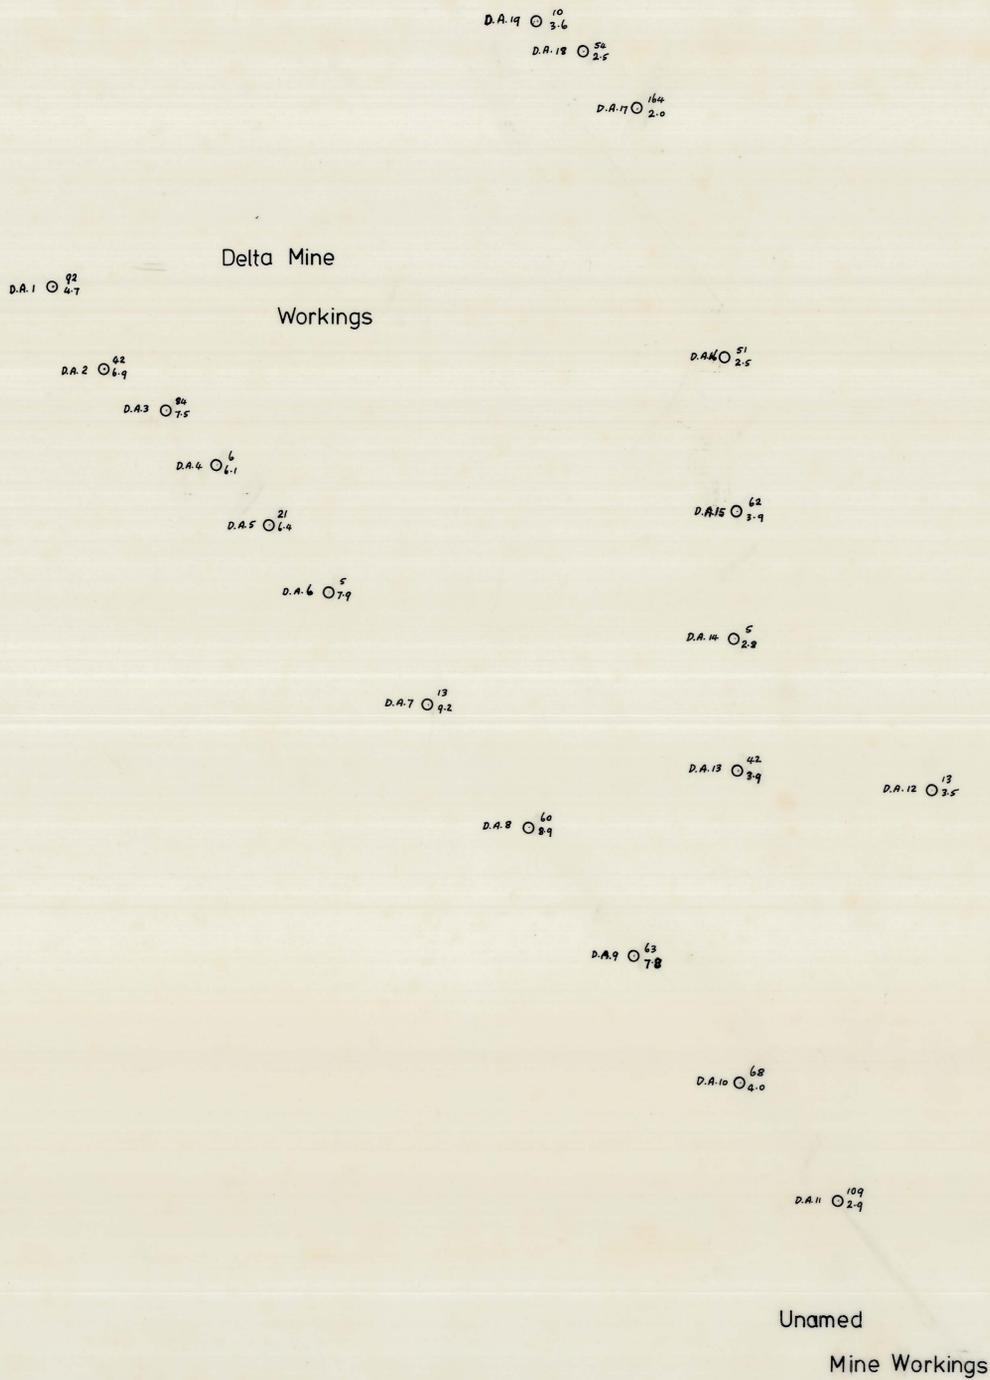

5 cm
0426-003

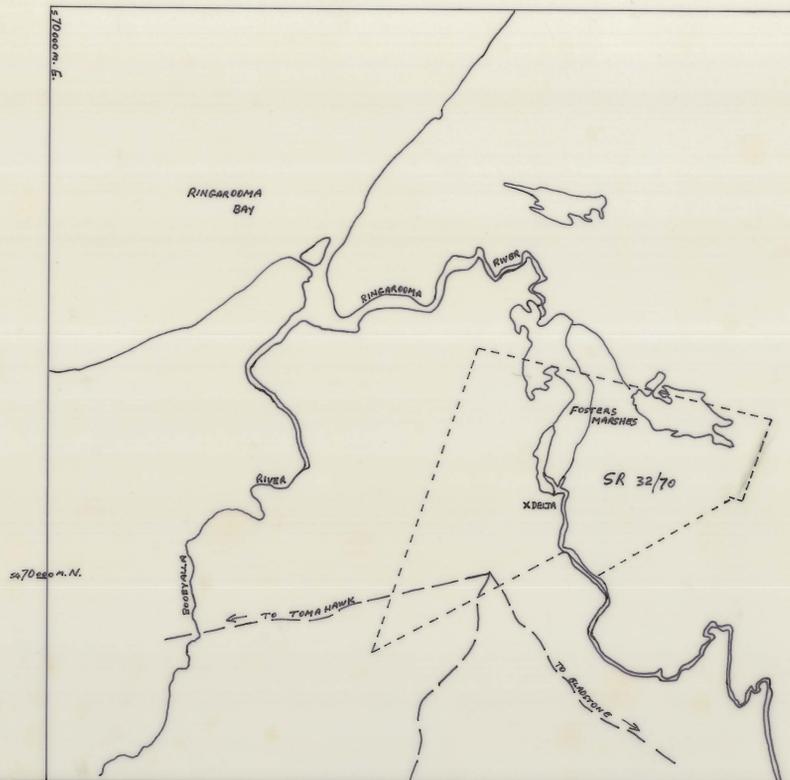

KIBUKA MINES PTY. LTD.

DELTA AUGER DRILLING 2-3/1981

SCALE 1:1000

M.N.



Hole Number—D.A.5 $\begin{matrix} 50 \\ 6 \end{matrix}$ Grade in grams SnO₂ (70% Sn) per metre³, top to bottom.
 Depth in metres to false bottom.

K. MORRISON 6/1981