DRILL HOLE LOCATIONS

FIG 39 E1

0427-009.

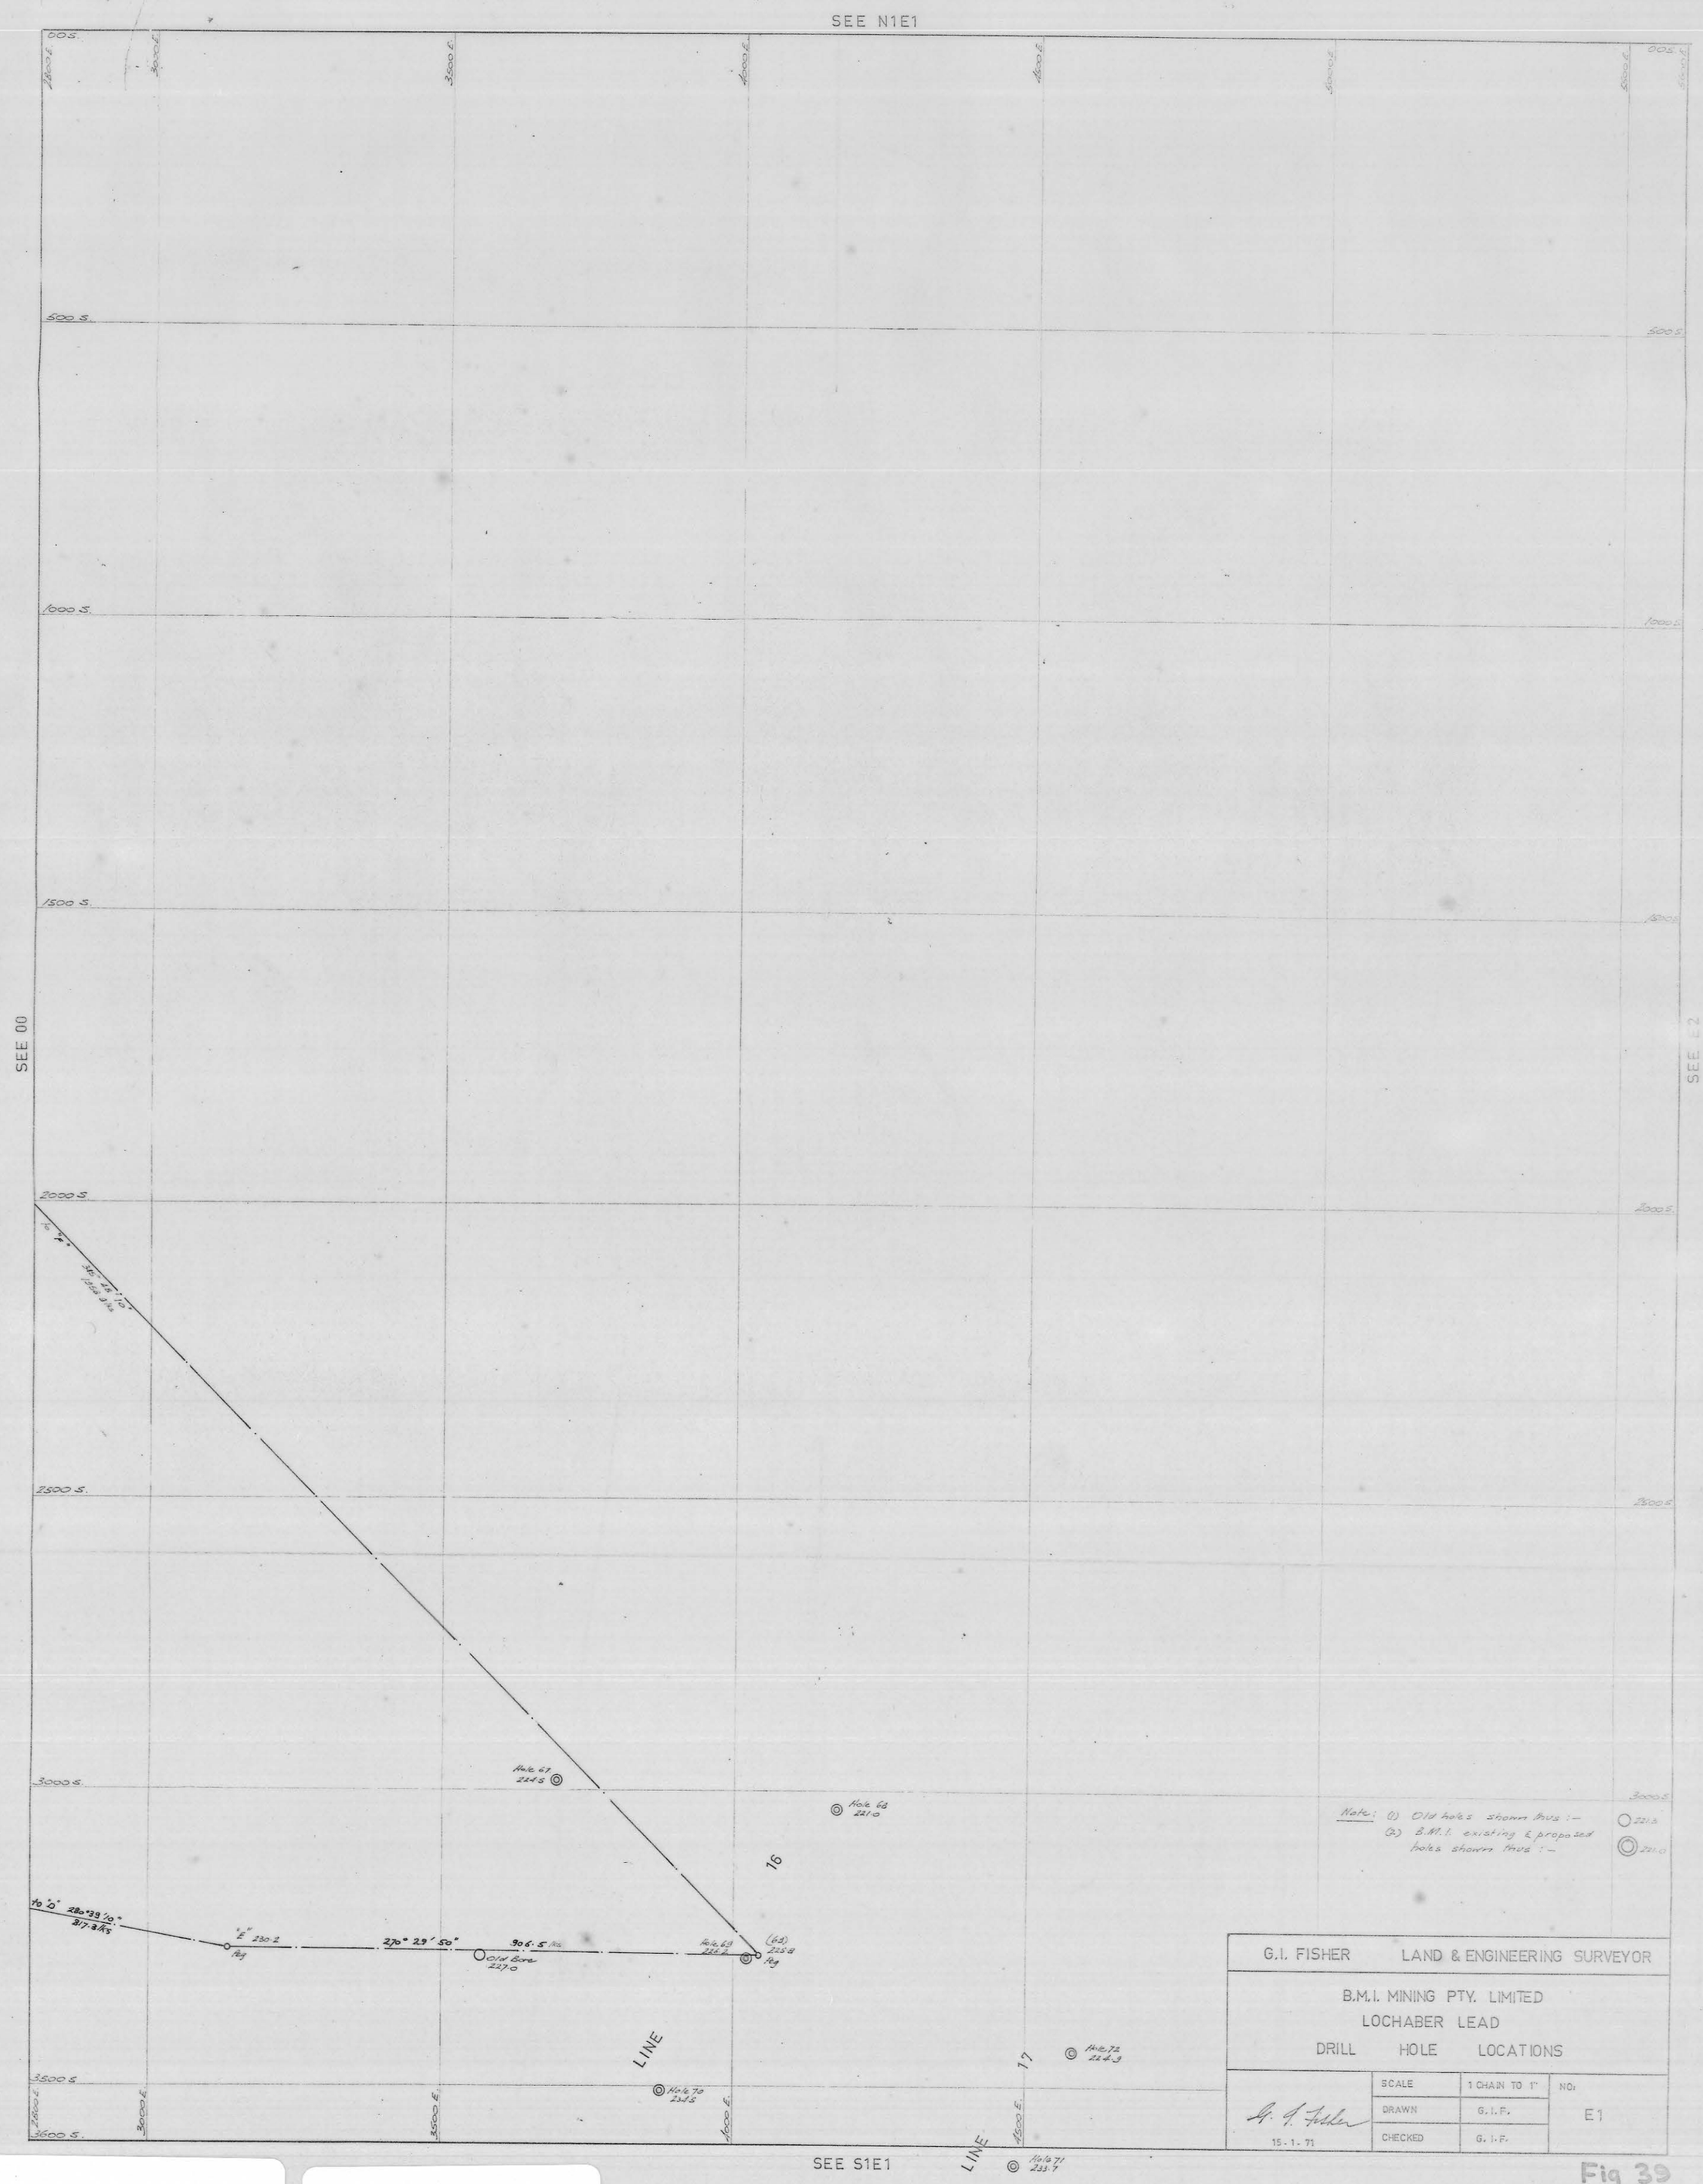

Fig 39

0427-009

5 cm