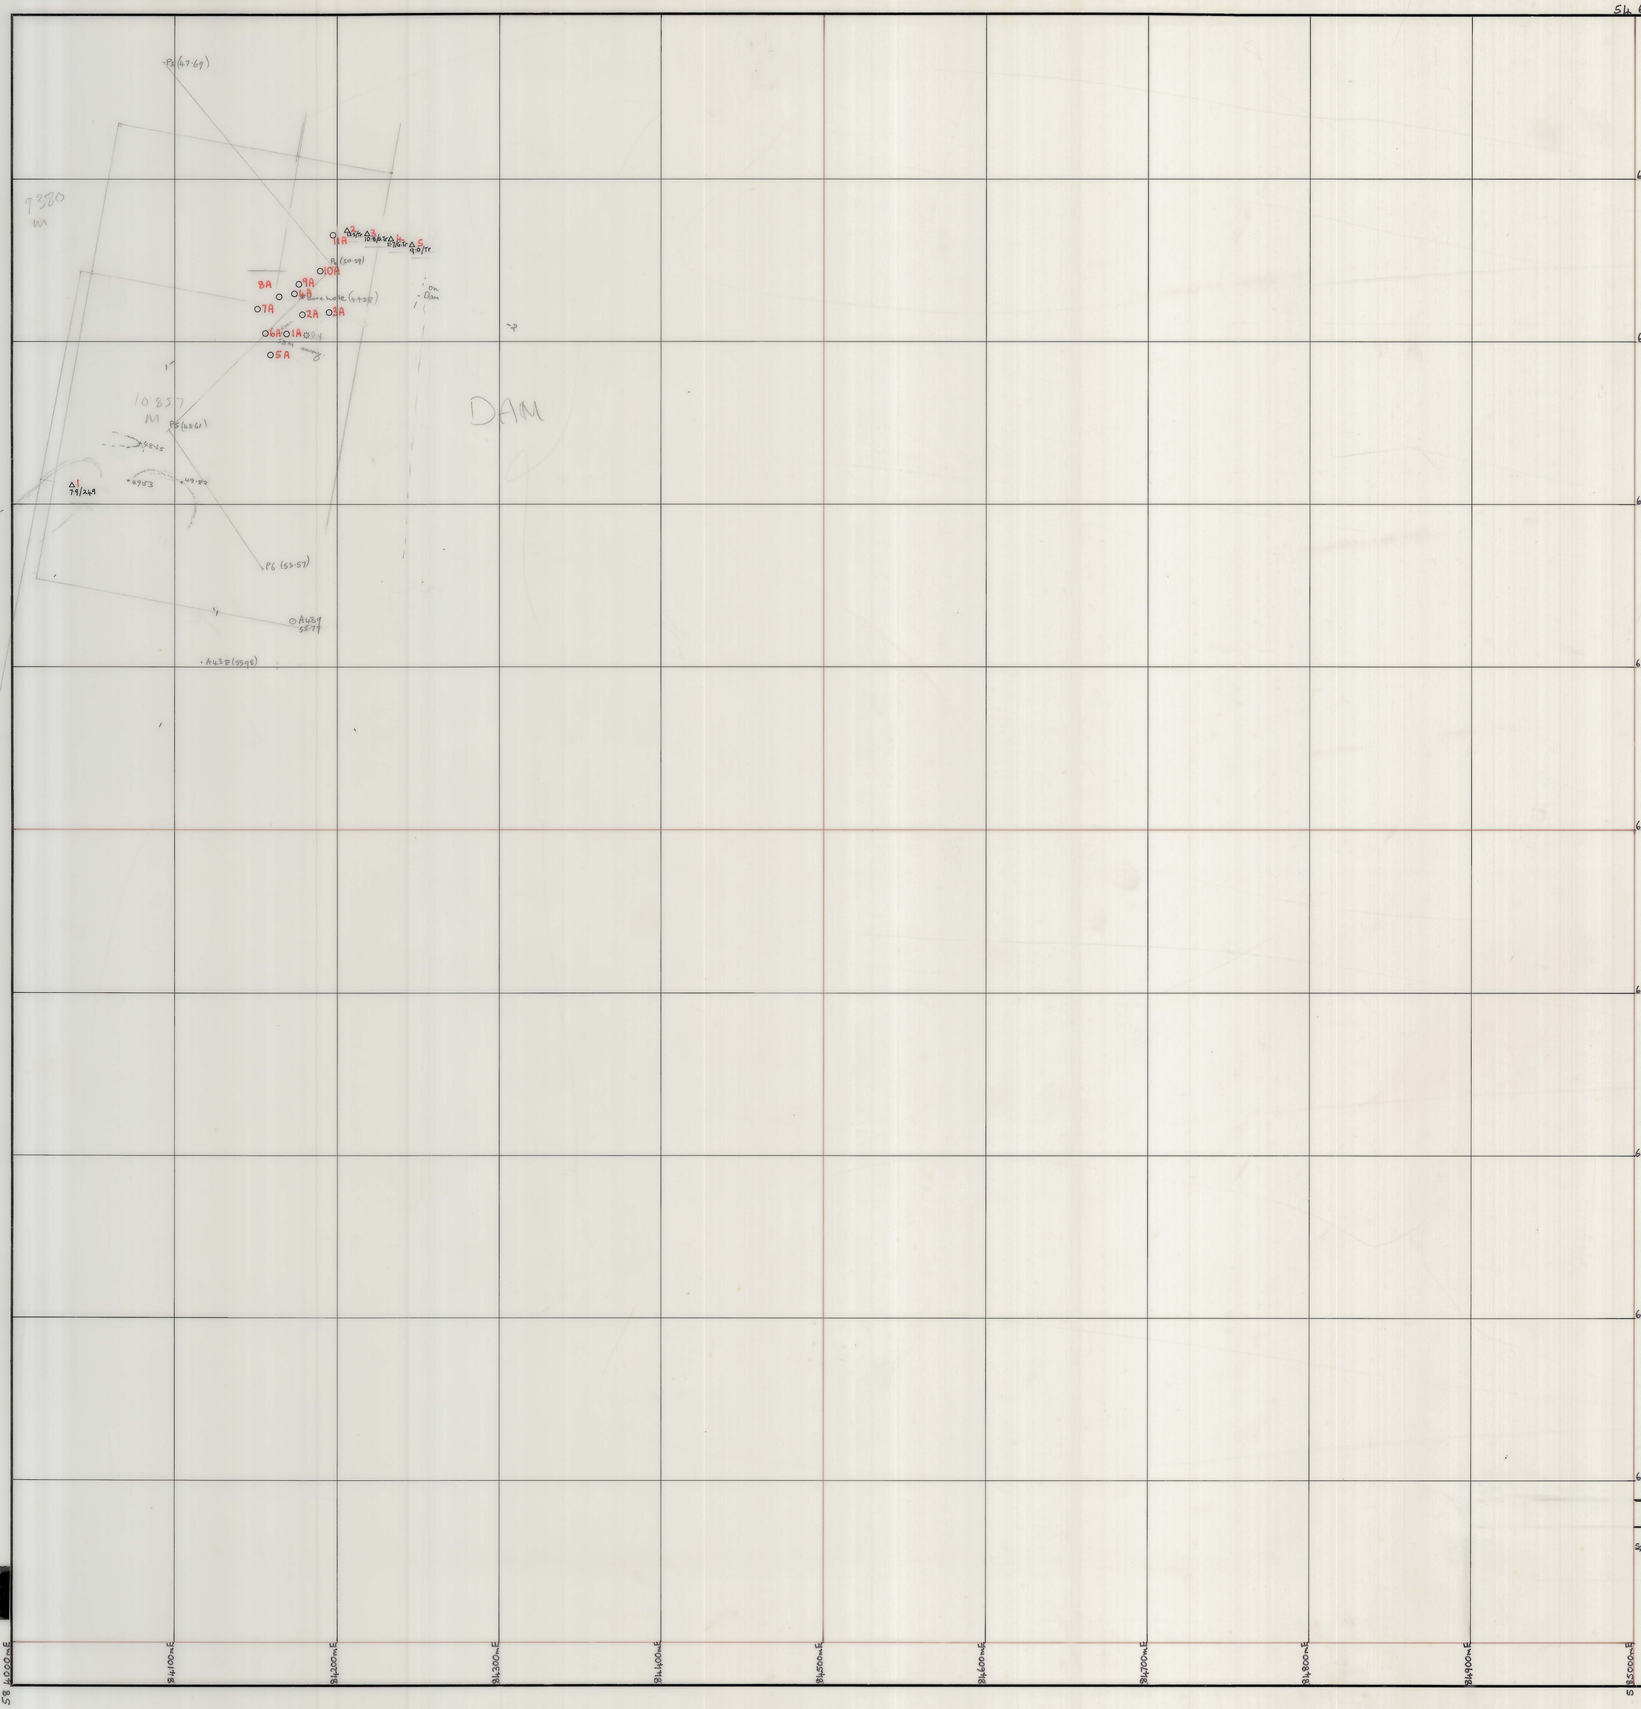

AMDEX MINING LTD. - SCOLOCH LEAD

SHEET - 6684

DRILL HOLE LEGEND

Symbol	Company	Date	Drilling Method
	Amdex Mining Ltd.	1978 onwards	Percussion, second Auger
	L. J. Graves (Mines Department)	1971	Percussion
	B. M. I. Mining Ltd.	1971-72, 1976	Percussion
	B. M. I. Mining Ltd.	1970-73	Auger - non sample
	Utah Development Co.	1965-66	Auger
	Stoney's Creek Tin Mining Co. N.L.	1964-65	Percussion
	Rio Tinto Aus Exploration Pty. Ltd.	1958	Percussion
	Mines Department.	1935-44	Crude Burrs, Handplant
	Mines Department - Roaches Bores	1916	Handplant
	Pioneer Tin Mining Co. - Rynns Bores	≈1916	Handplant
	Mines Department - Griffiths Bores	1902	Handplant.

LOCATION	NE TASMANIA
SCALE	1 : 1500
DATE	
DATA	R. MUNRO
DRAWN	
HEIGHT DATUM	A.H.D.
GRID	A.M.G.

6684

6684 ORIGINAL

SCOTIA

0428 – 006