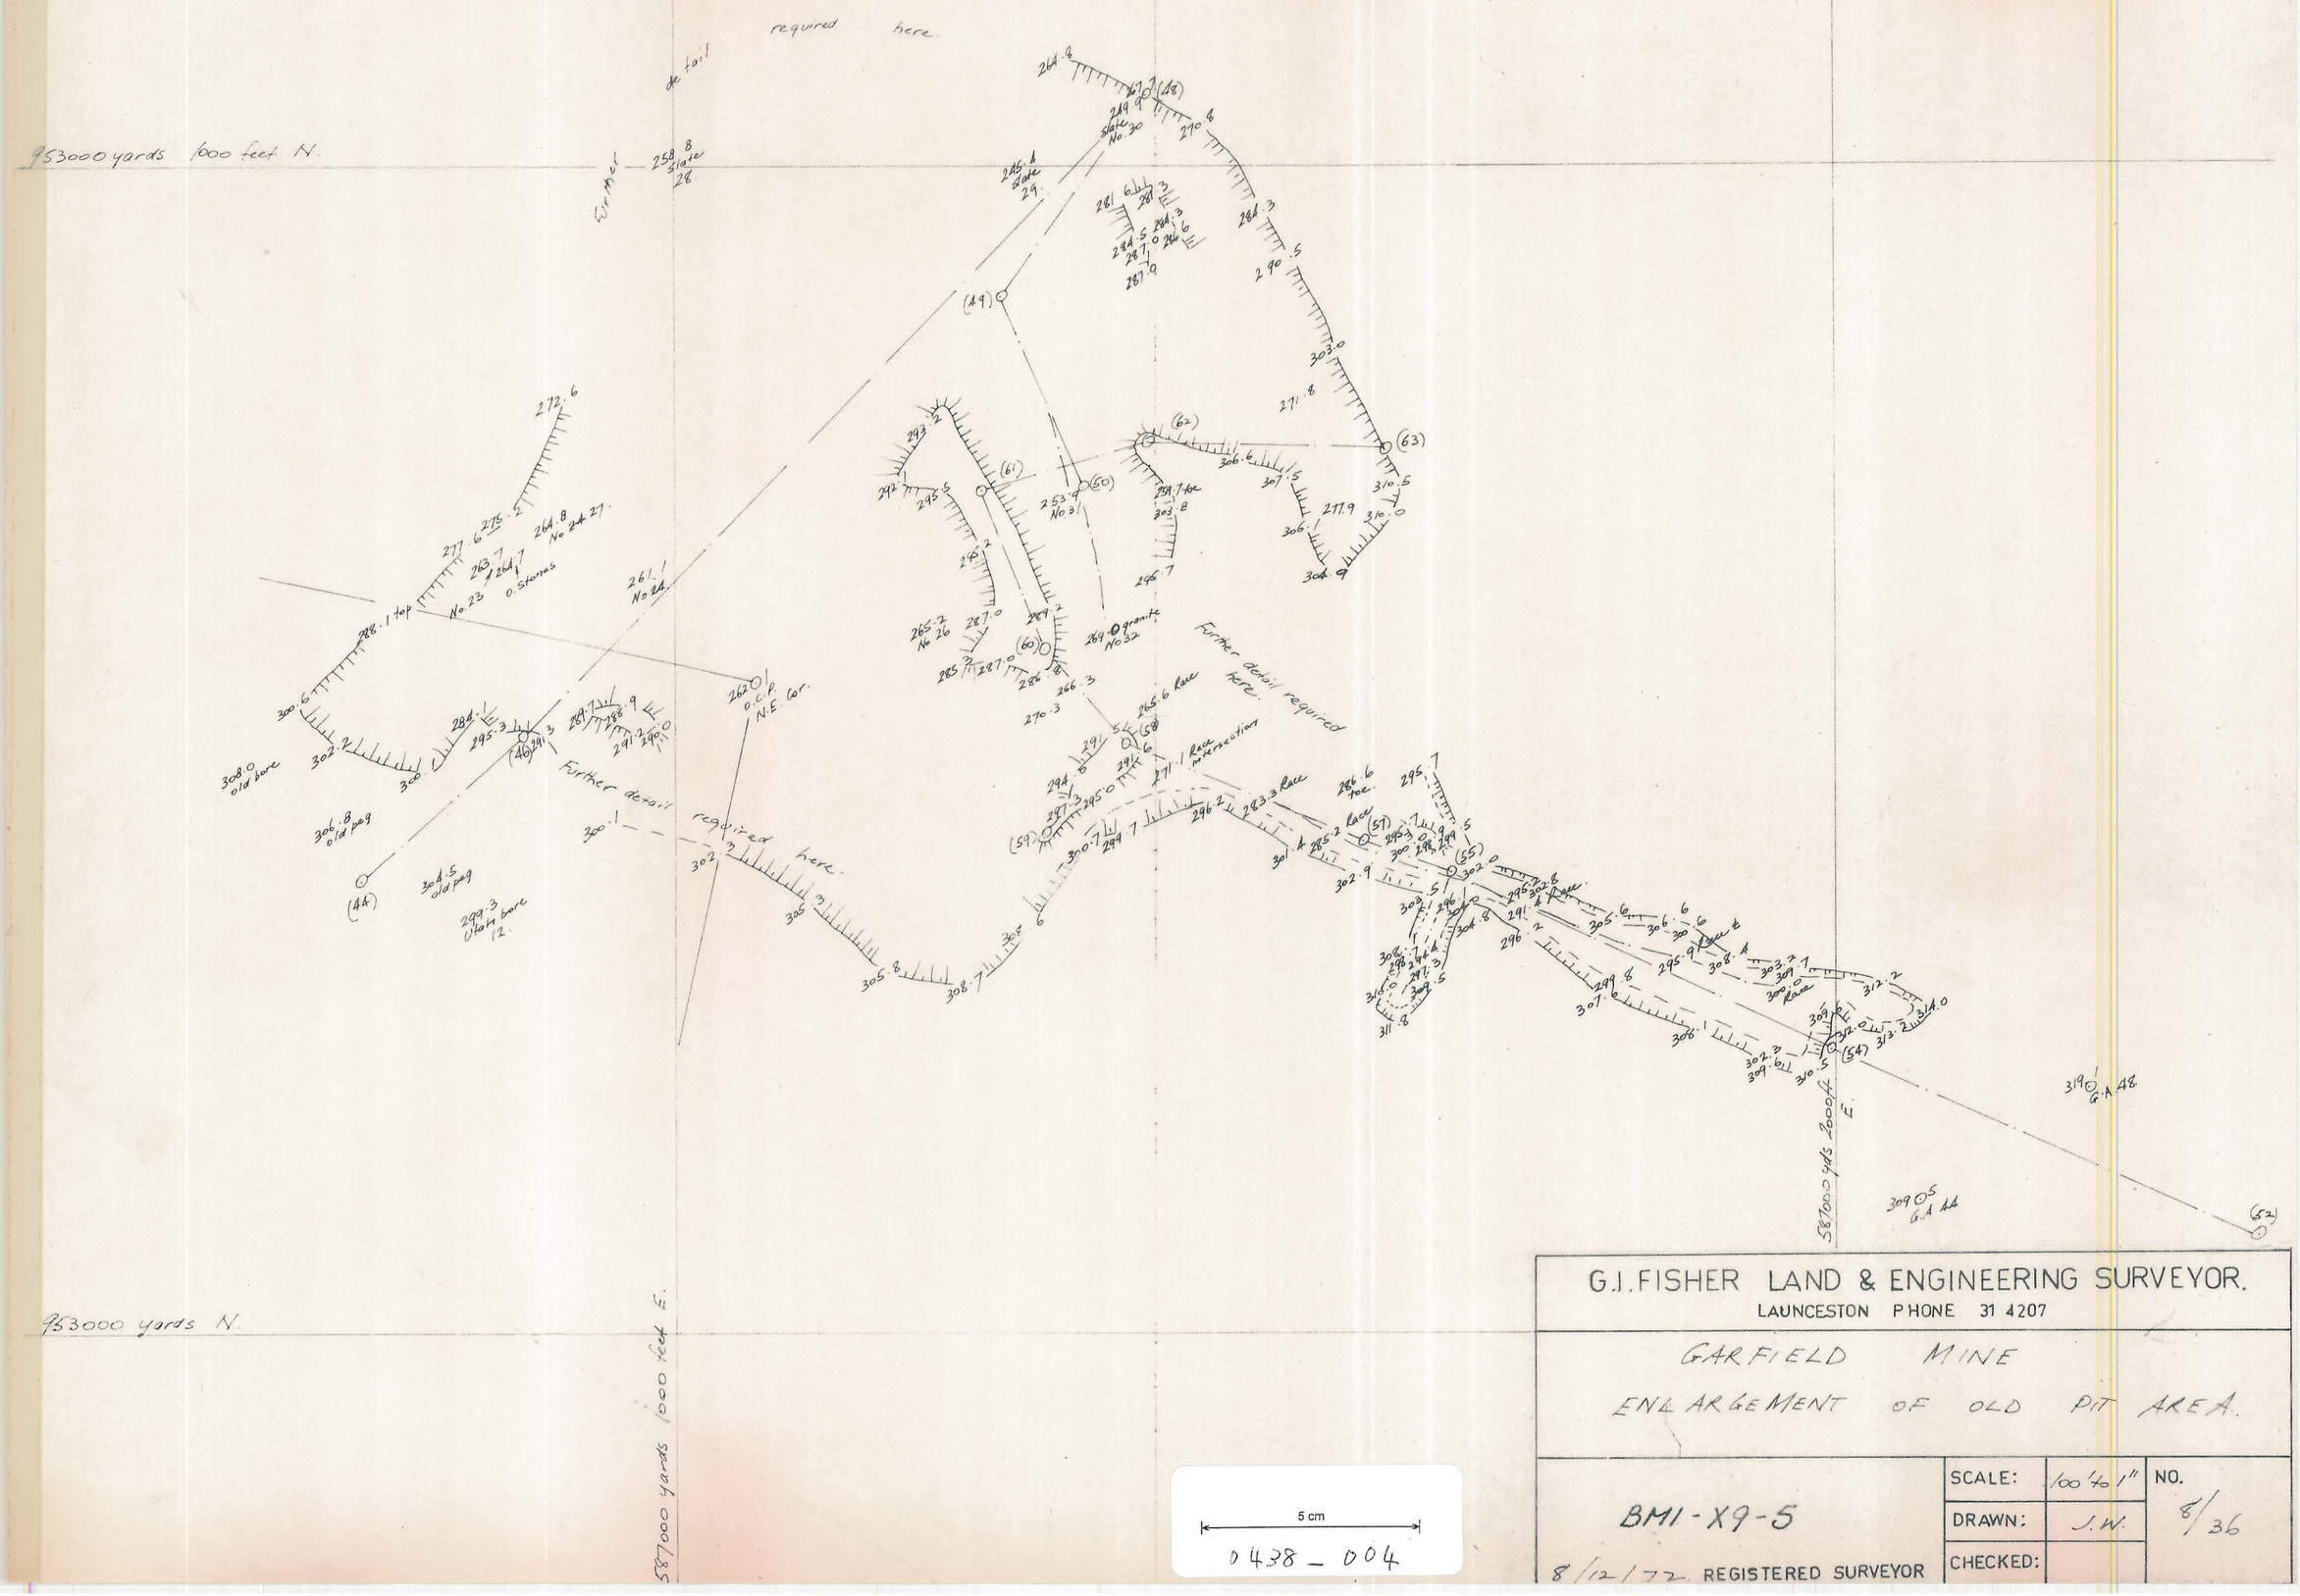
required here.
953000 yards 1000 feet N.
953000 yards N.
587000 yards 1000 feet E.
587000 yards 2000 ft E.
Further detail required here.
Further detail required here.
Further detail required here