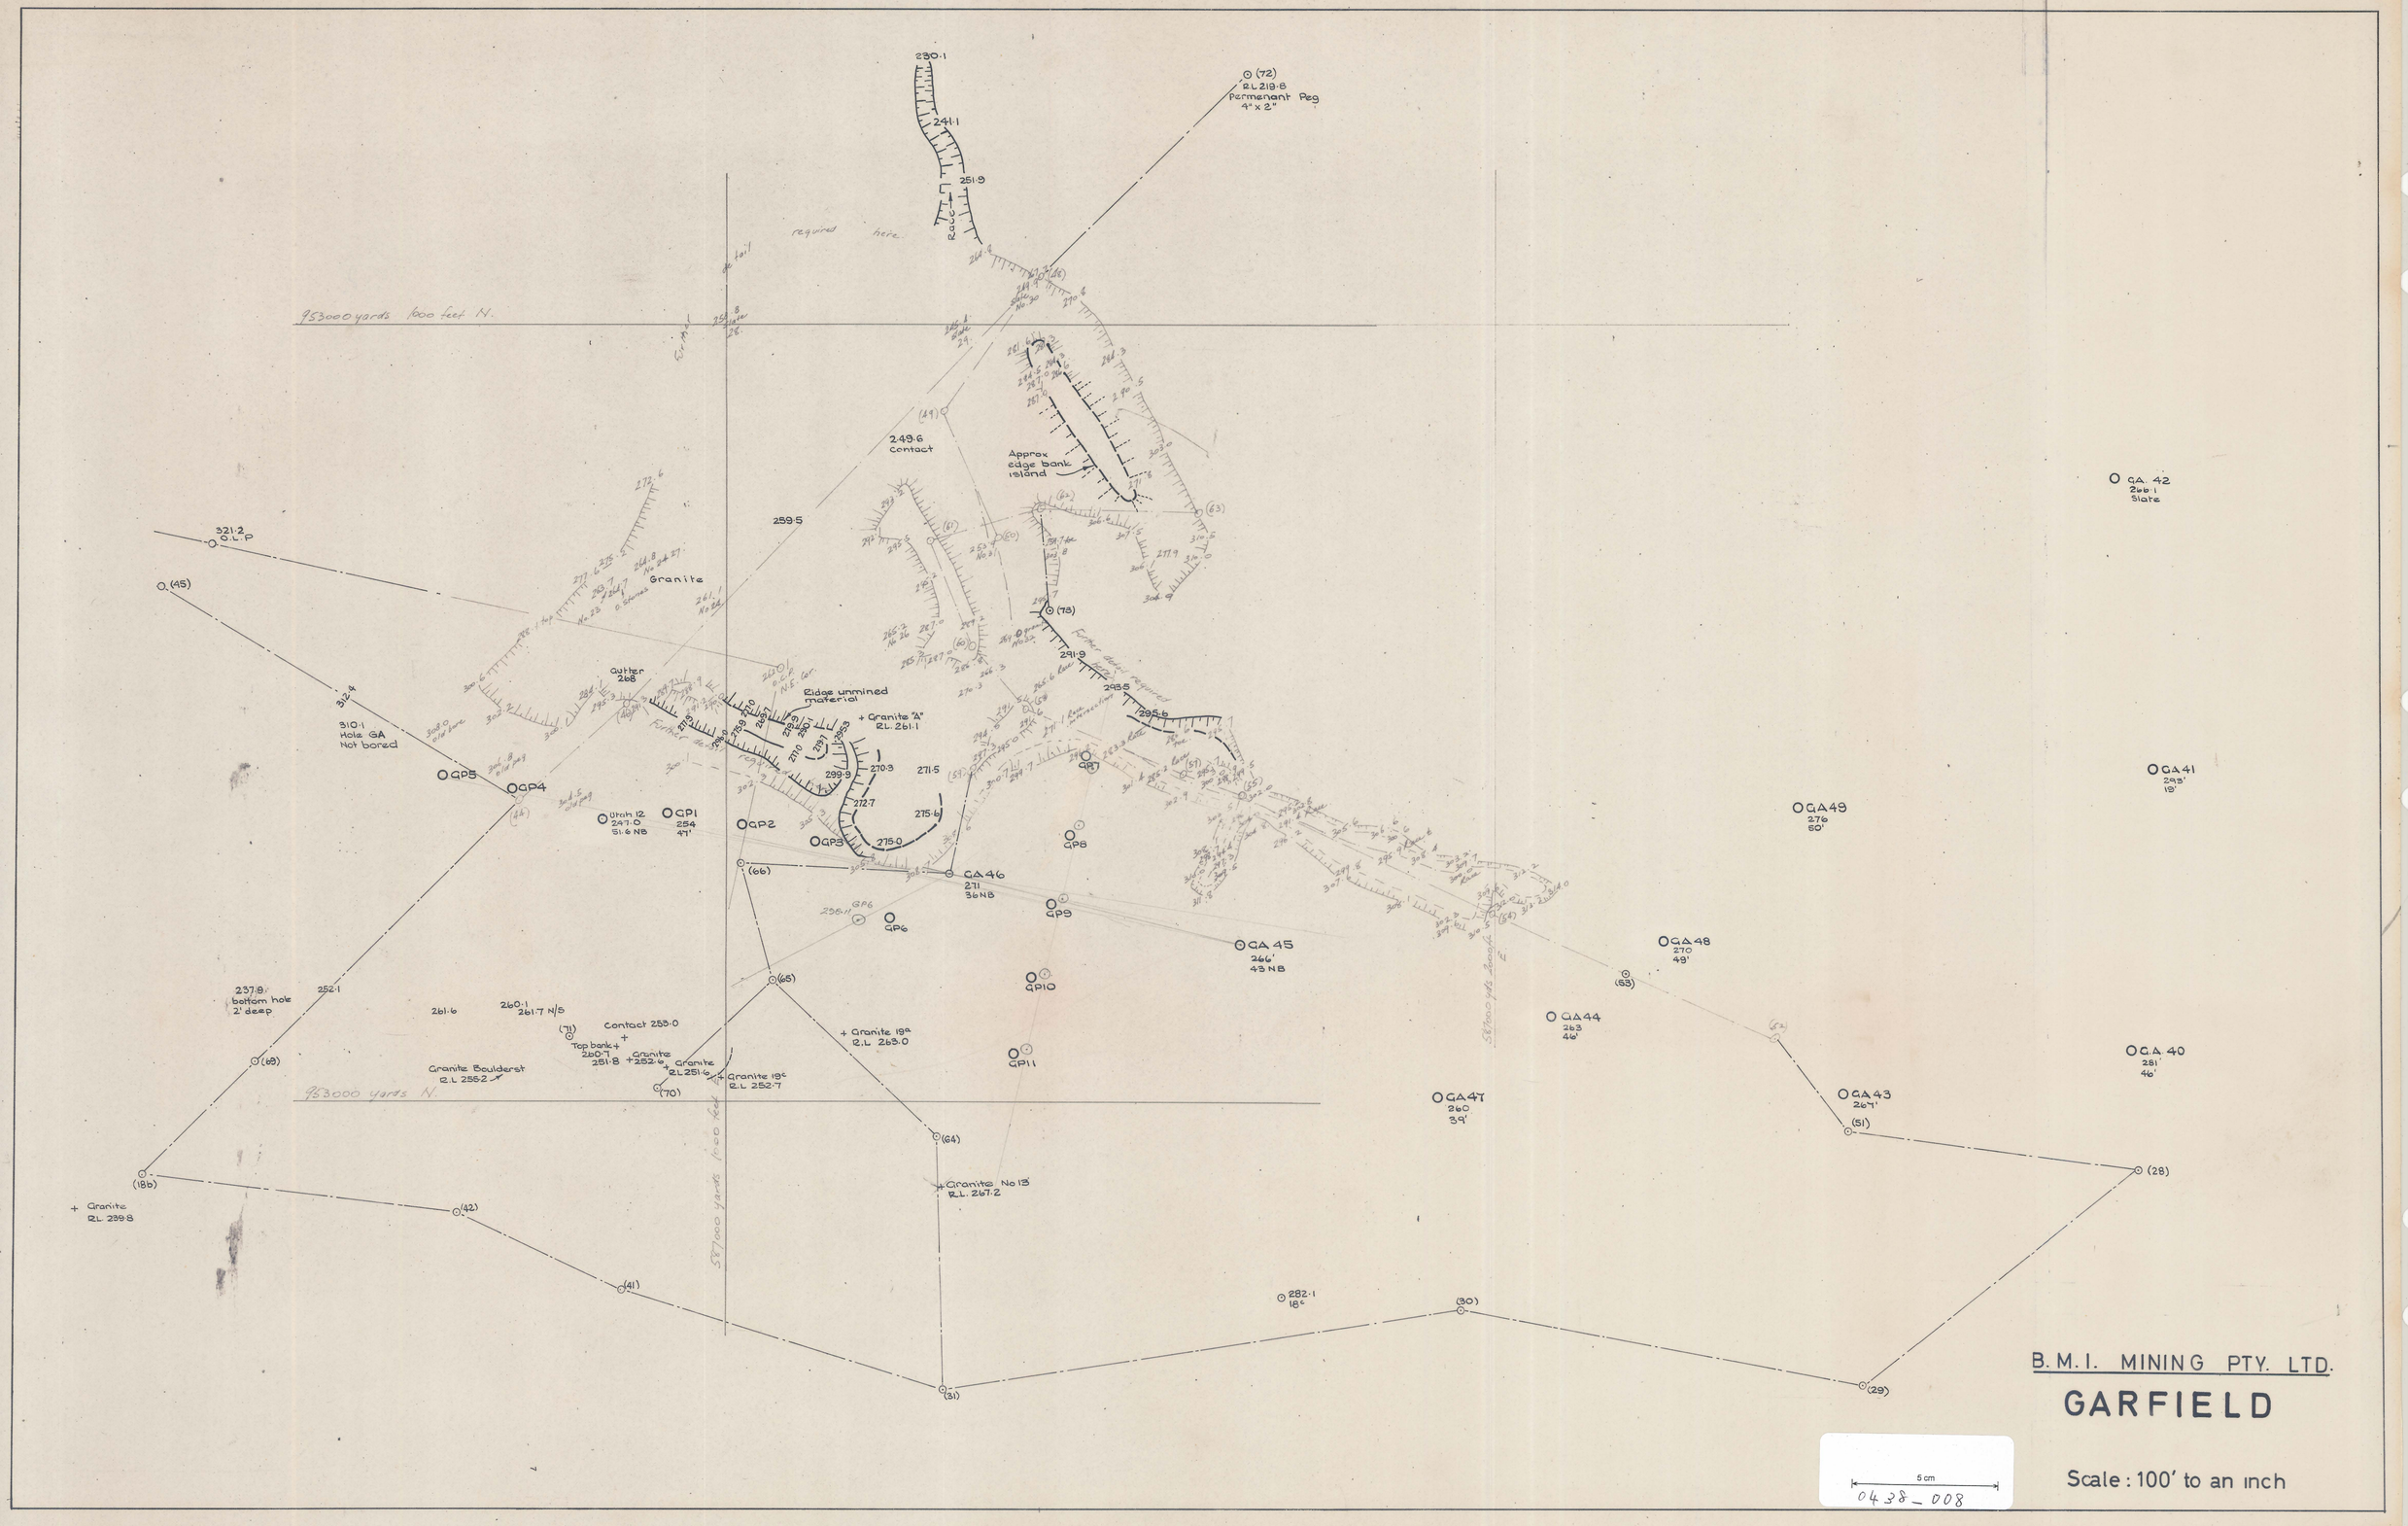
B.M.I. MINING PTY. LTD.
GARFIELD
Scale : 100' to an inch
5 cm
0438_008
(72)
RL 219.8
Permanent Peg
4" x 2"
230.1
241.1
251.9
required here
95300 yards 1000 feet N.
249.6
contact
Approx
edge bank
island
259.5
321.2
O.L.P
(45)
Granite
Gutter
268
Ridge unmined
material
+ Granite "A"
RL 261.1
310.1
Hole GA
not bored
GP5
GP4
GP1
GP2
GP3
GP8
GP9
GP6
GP10
GP11
GP7
GA 46
271
36 NB
GA 45
266'
43 NB
GA 47
260
39'
GA 44
263
46'
GA 43
267'
GA 48
270
49'
GA 49
276
60'
GA 41
295'
18'
GA 42
261
Slate
C.A. 40
281
46'
237.8
bottom hole
2' deep
252.1
261.6
260.1
261.7 N/S
Contact 253.0
Top bank
260.7
251.8
Granite
252.6
Granite
251.6
Granite 19c
RL 252.7
Granite Boulders
RL 255.2
95300 yards N.
+ Granite 19a
RL 263.0
+ Granite
RL 239.8
Granite No 13
RL 267.2
282.1
18c
(186)
(42)
(41)
(31)
(30)
(29)
(28)
(51)
(64)
(65)
(66)
(68)
(70)
(71)
(73)
(63)
(62)
(61)
(60)
(59)
(58)
(57)
(55)
(53)
(52)
(44)
(49)
(46)
(48)
(50)
(54)
(56)
0438_008