
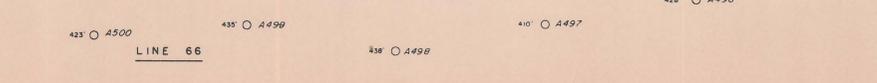
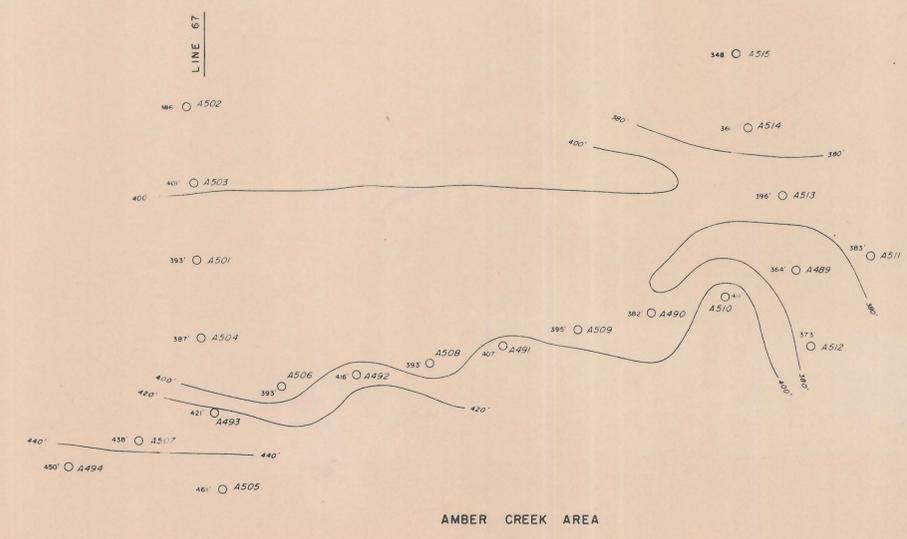
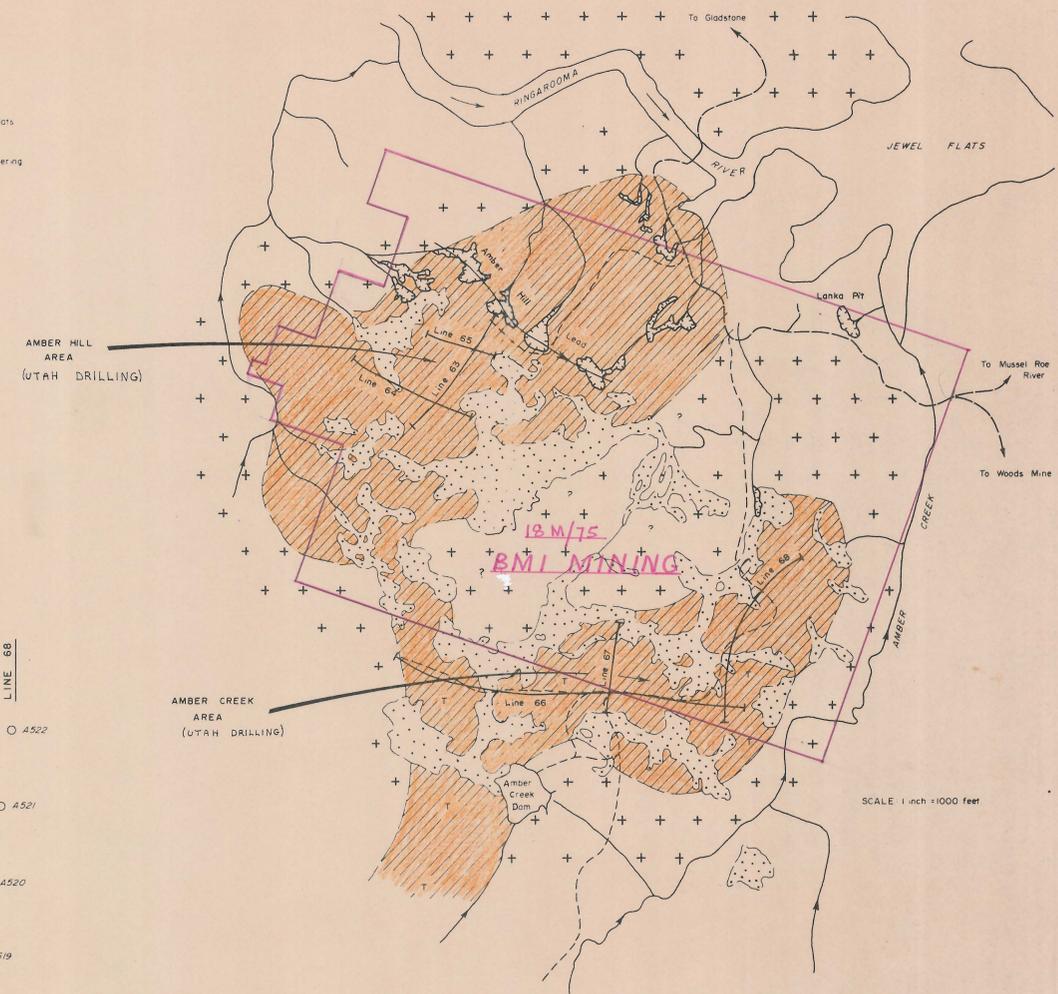


See sheets 446, 445, 423, 427, 428, 426

LEGEND

- RECENT  
Alluviated areas - button grass flats
- TERTIARY  
Sandy rises - derived from weathering of Tertiary drift and wash
- DEVONIAN  
Granitic rocks

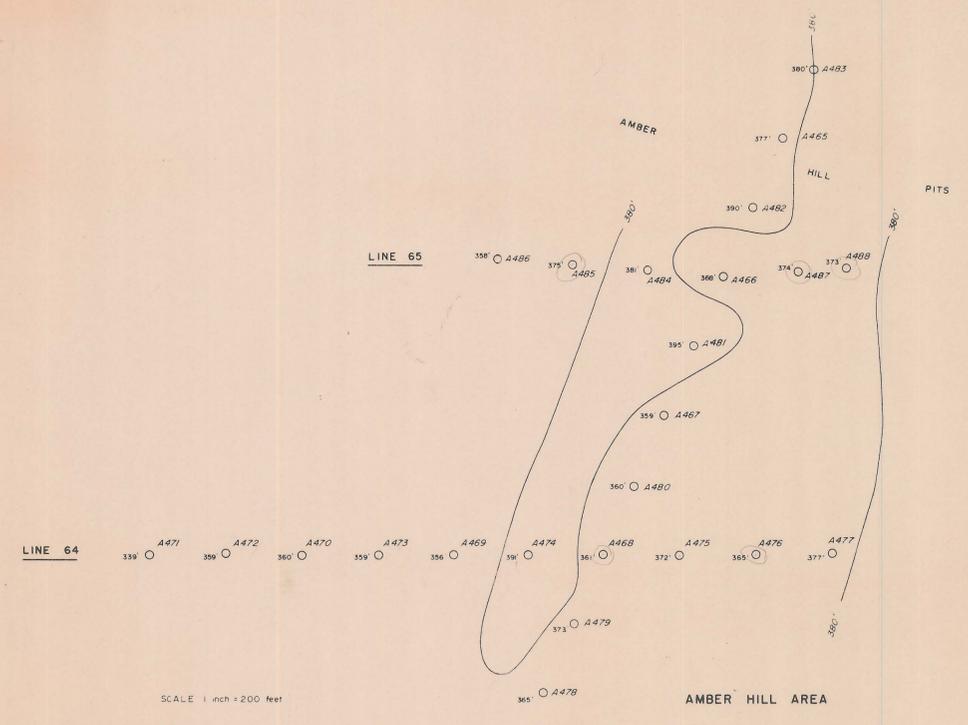

UTAH DEVELOPMENT COMPANY  
**PHOTO-GEOLOGICAL MAP  
AND SUBSURFACE BASEMENT CONTOUR PLAN  
AMBER HILL AND AMBER CREEK AREA.**

PLATE 12

5 cm  
0439-005

0439-005