
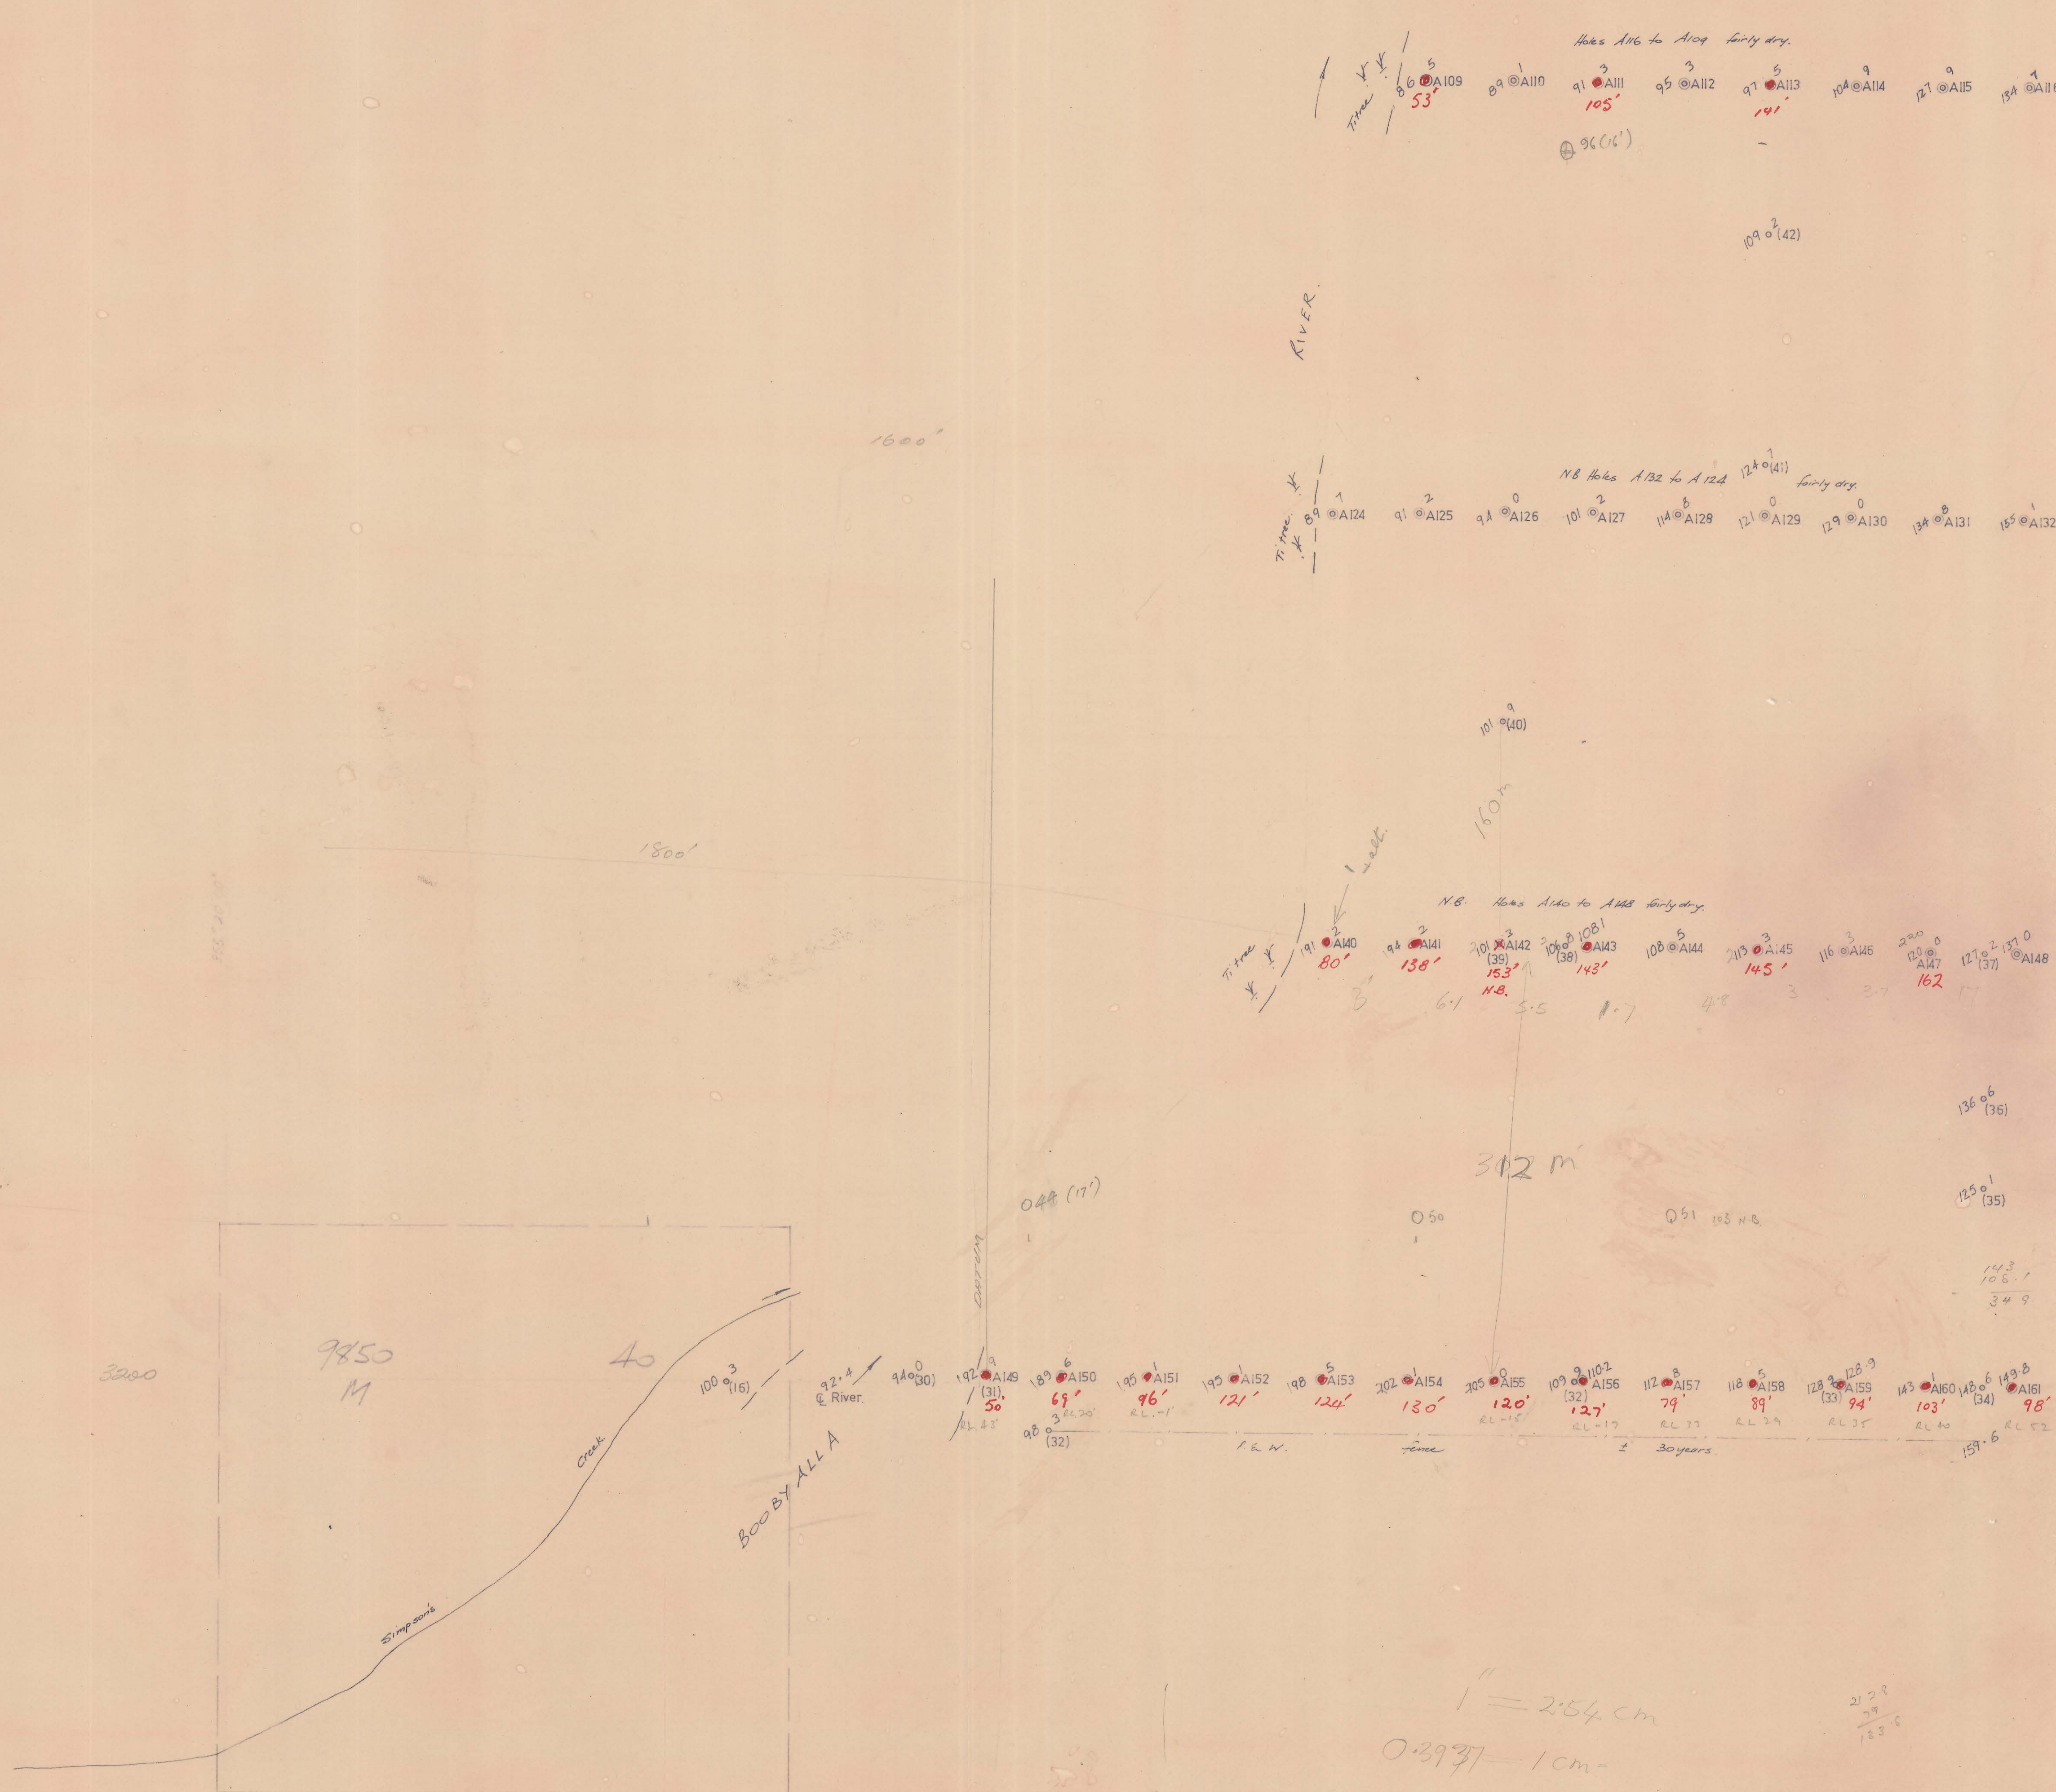


0440-004

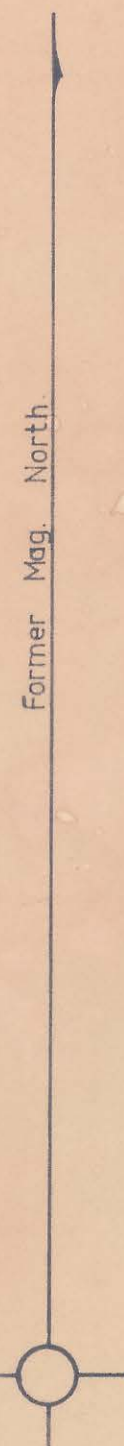

5 cm
0440-004

G.I. FISHER LAND & ENGINEERING SURVEYOR. LAUNCESTON PHONE 31 4207.		
B.M.I. MINING PTY. LTD. BANCA DISTRICT.		
<i>G.I. Fisher</i> REGISTERED SURVEYOR.	SCALE: 200' to 1" DRAWN: R. J. P. CHECKED: G. I. F.	NO. 8/25