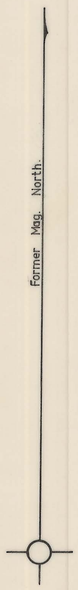

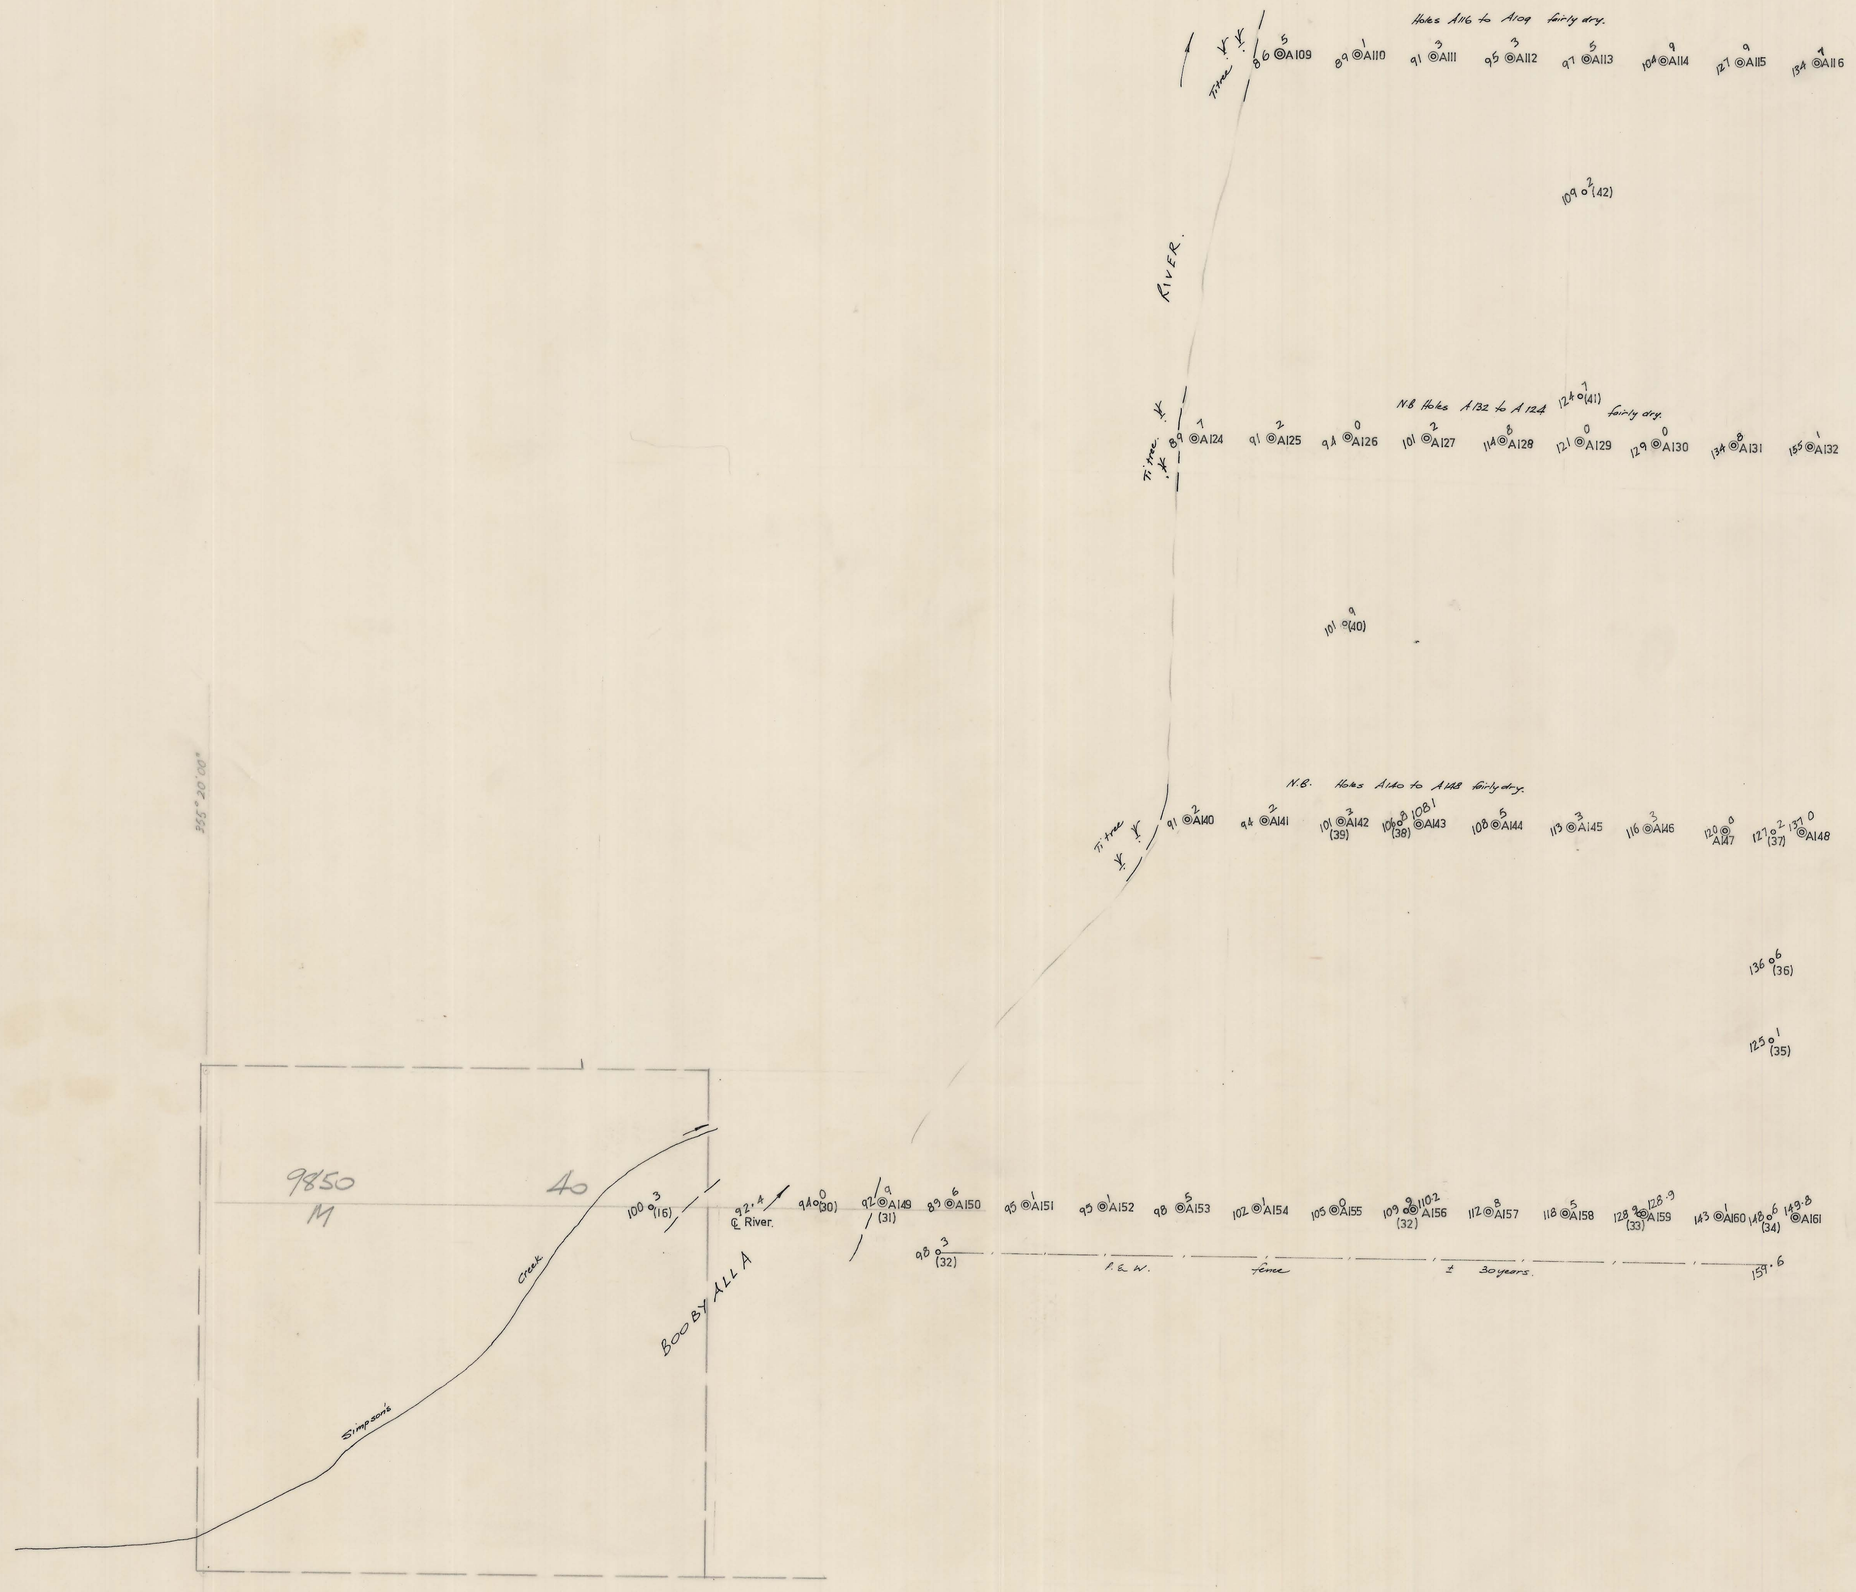

SB15
SB17 P14, -19

G.I. FISHER LAND & ENGINEERING SURVEYOR.
LAUNCESTON PHONE 31 4207.

B.M.I. MINING PTY. LTD.
BANCA DISTRICT.

G.I. Fisher	SCALE:	200' to 1".	NO. 8/25
	DRAWN:	R. J. P.	
REGISTERED SURVEYOR.	CHECKED:	G. I. F.	

5 cm
0440-005

0440 - 005