


MINERAL CHART WINNALEAH 2 NORTH


AUSTRALIA 1:15,840

SHEET No. 8415-1-NE-N

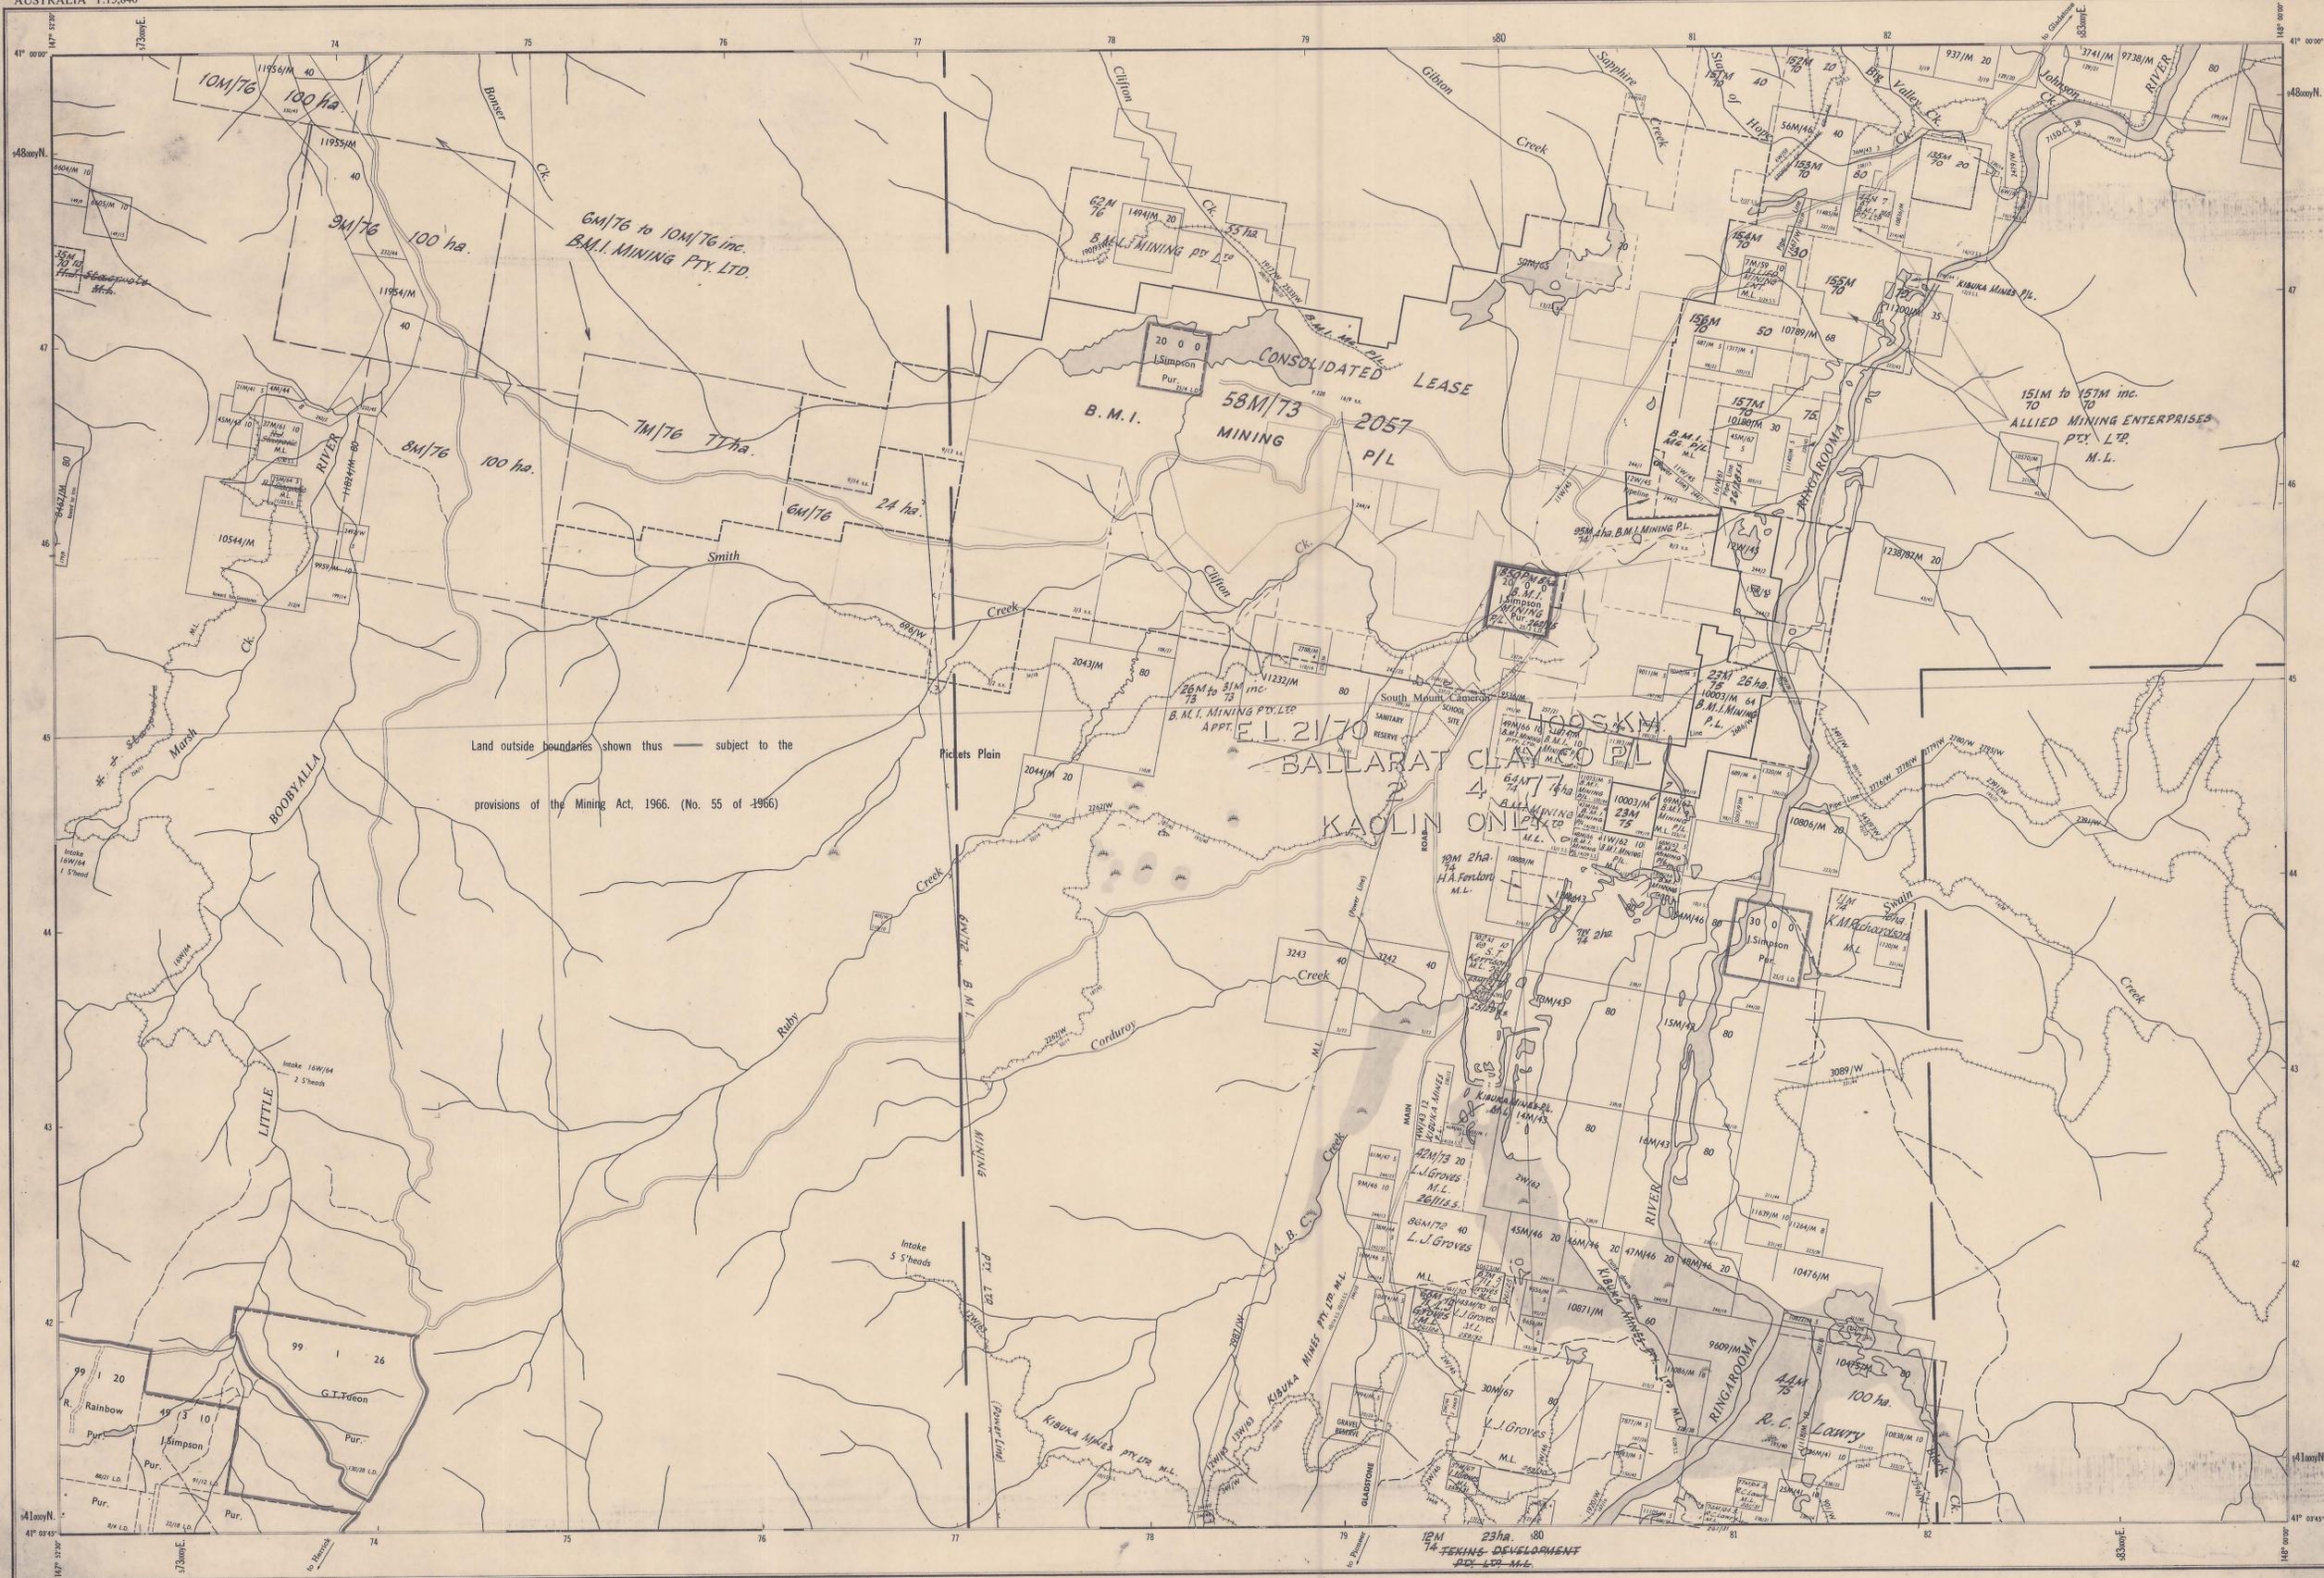

Land outside boundaries shown thus — subject to the provisions of the Mining Act, 1966. (No. 55 of 1966)


0442-007

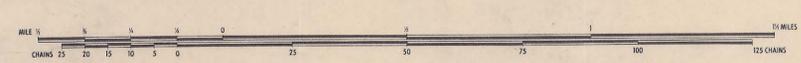

SCALE 20 CHAINS TO 1 INCH



Magnetic Variation from True North for the centre of this sheet is approximately 2°42' E. 1965.

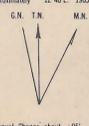

DETAILS—
Nomenclature—
Projection—
Level Datum—
Control—
CRD CONVERGENCE—
CO-ORDINATES—

Aerial Photography 1965.
Approved by the Nomenclature Board of Tasmania.
Transverse Mercator
Mean Sea Level at Hobart.
2nd and 3rd order Triangulation based on
Lucanthes Astronomical Station.
Lat 41° 38' 23.98" S. Long 147° 17' 49.72" E.
Based on Long 146° 00' E.
Origin is 400,000 yards West and 1,800,000 yards
South of the True Origin of Zone 7.

Mineral Lease Application No. 10619/M
Area in Acres 79
Subject to Survey Line
Survey Areas, Acres, Roads, Perches 50 2 34
Survey Diagram Reference 86/12
Min Name GRAND PRIZE
Land District Name DORSET
Water Race

The representation of a boundary or other cadastral information on this map does not constitute evidence of its existence or location.
The representation of a road or track on this map is no evidence of the existence of a right of way.

Produced by the LANDS AND SURVEYS DEPARTMENT, Hobart, Tasmania.

INDEX TO ADJOINING SHEETS

TOMARAWAK	GLADSTONE
IS 28	IN
WINNALEAH	FRASER
IN 28	IN
WINNALEAH	FRASER
IS 28	IS

SHEET SUBDIVISION OF THE NATIONAL INDEX

N	NW	NE
IV	NW	NE
S	SW	SE
III	SW	SE



Crown Copyright Reserved

11 FEB 1977

0442-007

22/2/77