


# MINERAL CHART WINNALEAH 2 NORTH

AUSTRALIA 1:15,840

SHEET No. 8415-1-NE-N

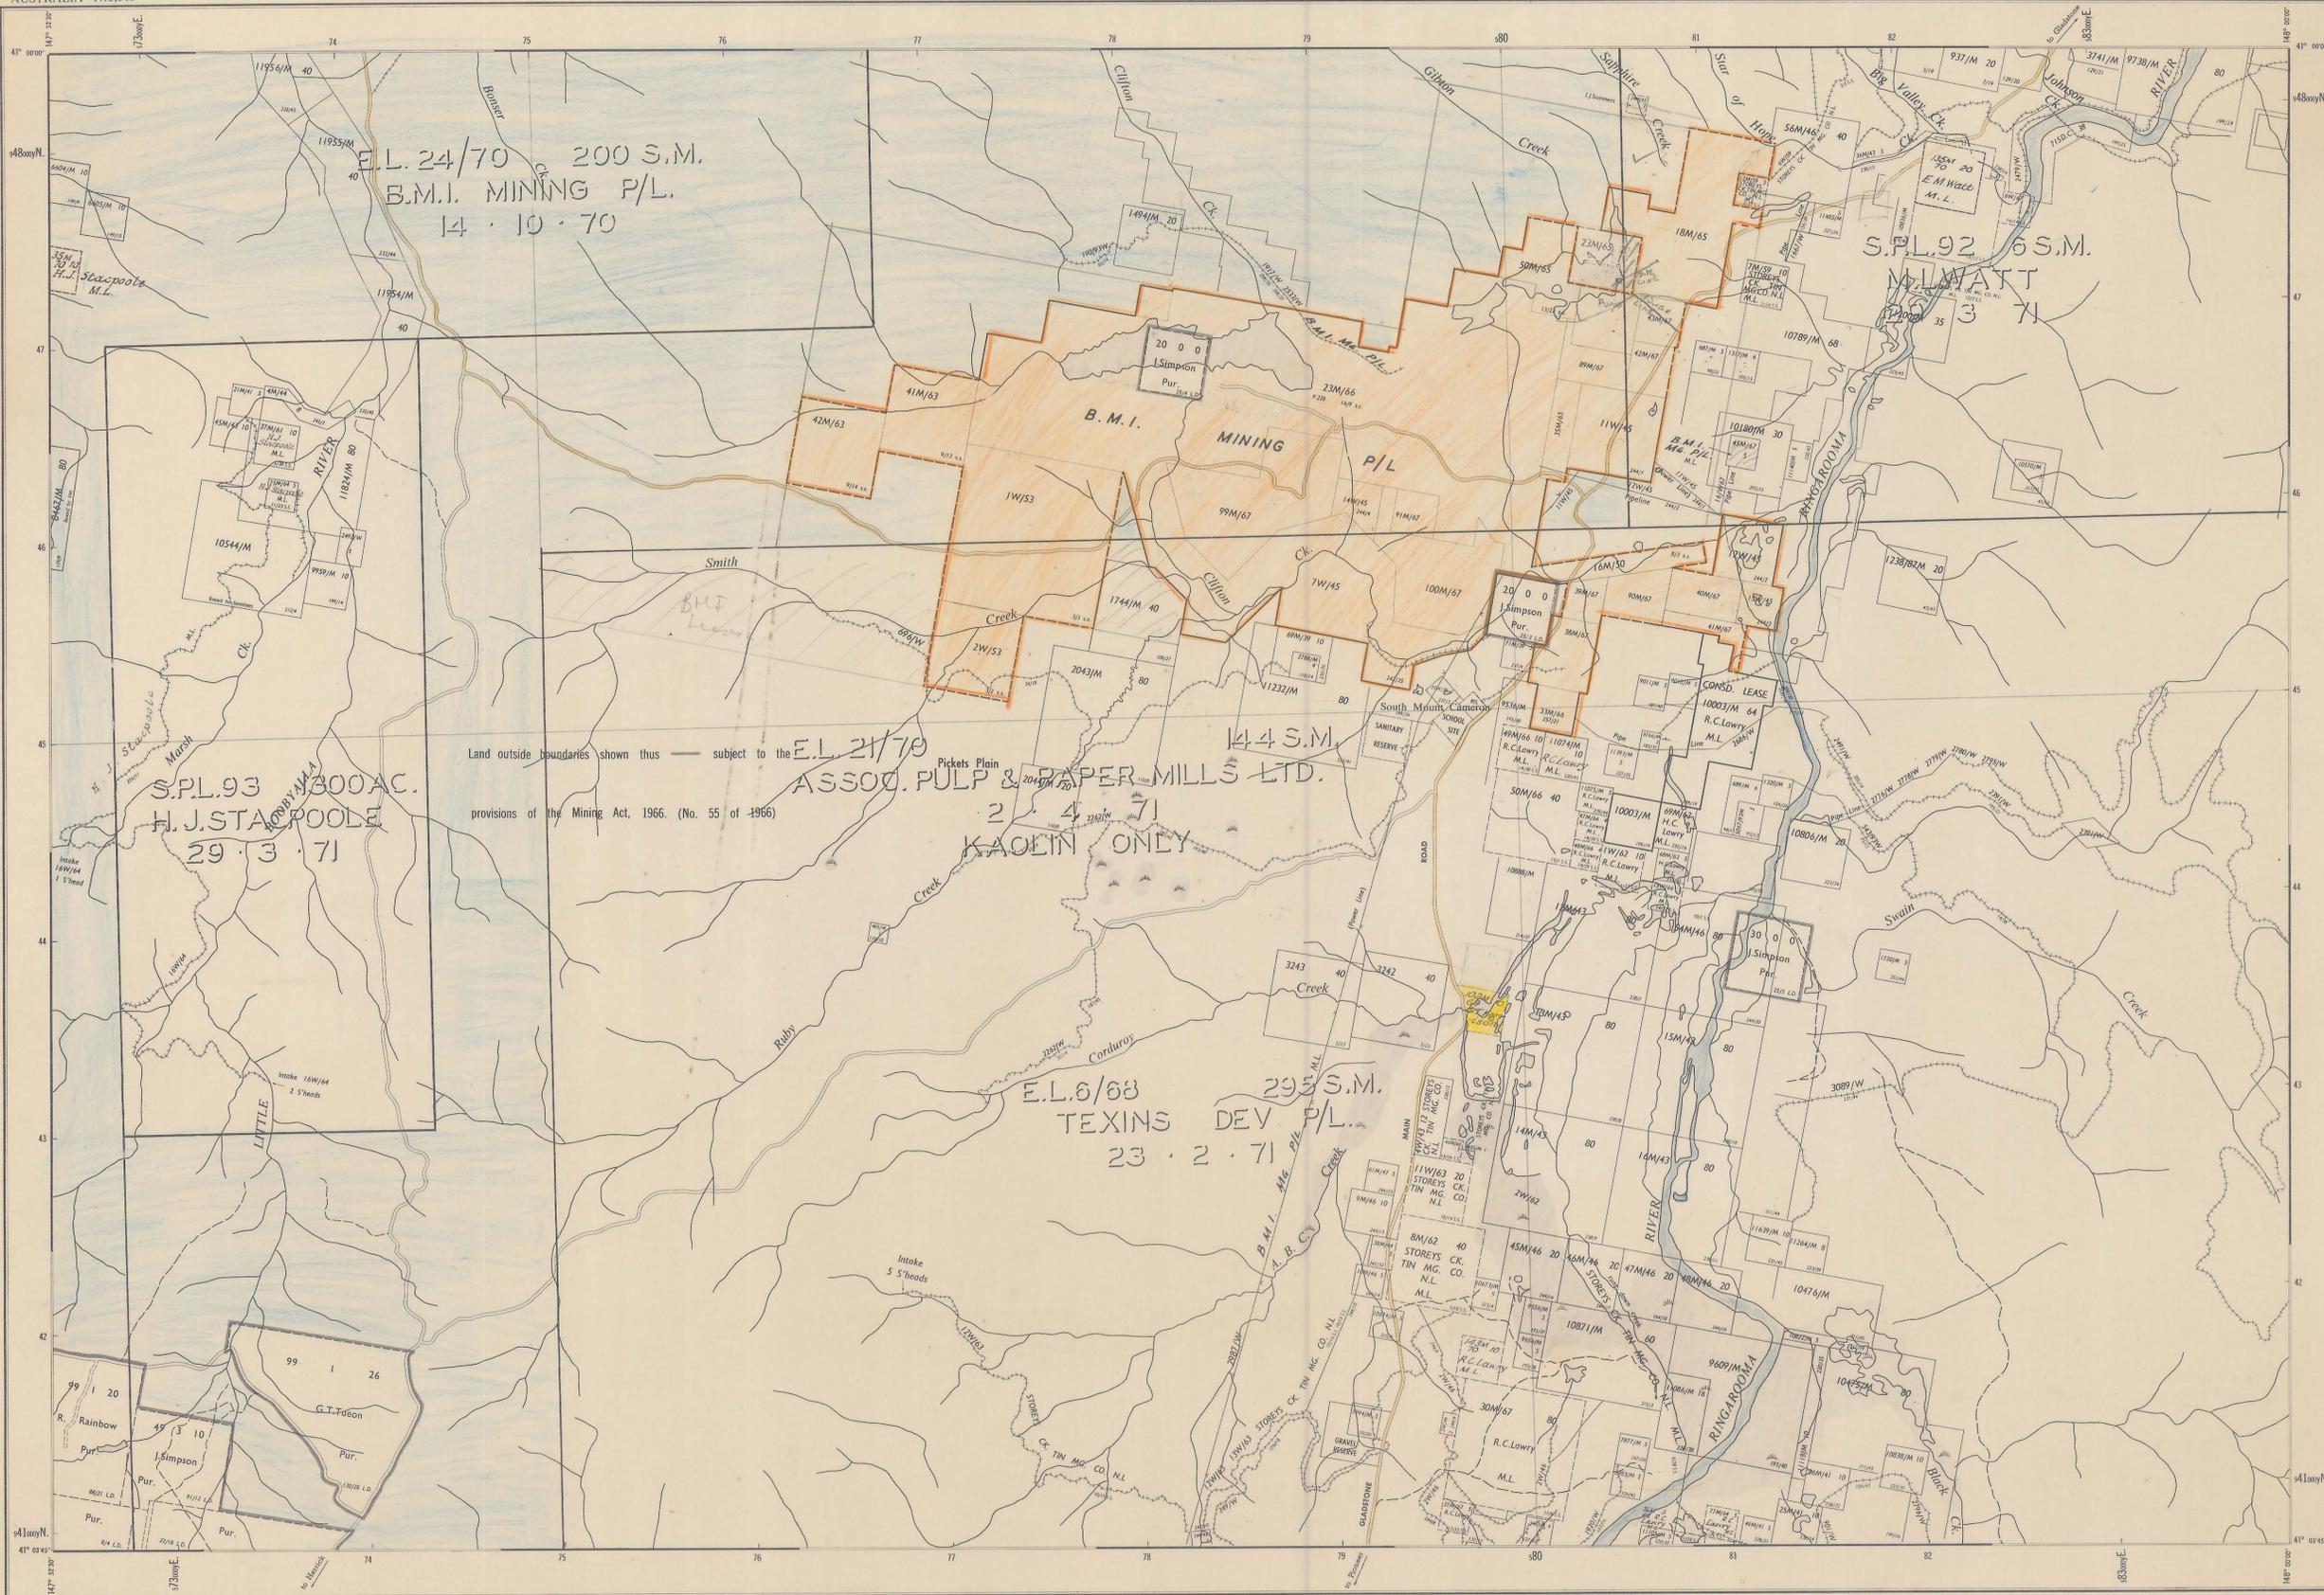

0442-009



DETAIL—  
 PHOTOGRAPHY—1965  
 PROJECTION—Transverse Mercator  
 LEVEL DATUM—Mean Sea Level at Highport  
 CONTROL—2nd and 3rd order triangulation based on Luchman Astronomical Station  
 CO-ORDINATES—Based on Long 142° 00' E. UTM  
 ORIGIN—Origin is 400,000 yards West and 1,800,000 yards South of the True Origin of Zone 1.


- Road Surface.....
- Vehicular Track.....
- Foot or Pack Track.....
- Railway Single Track.....
- Light Railway or Tram.....
- Waterfall, Rapid.....
- Swamp or Marsh.....
- Town Boundary.....

Mineral Lease Application No. .... 10619/M  
 Area in Acres ..... 79  
 Subject to Survey Line.....  
 Survey Line.....  
 Survey Areas, Acres, Roads, Patches..... 50 2 34  
 Survey Diagram Reference..... 85/13  
 Mine Name..... GRAND PRIZE  
 Land District Name..... DORSET  
 Water Race.....


The representation of a boundary or other cadastral information on this map does not constitute evidence of its existence or location.  
 The representation of a road or track on this map is no evidence of the existence of a right of way.

INDEX TO ADJOINING SHEETS

TOMAHAWK	GLADSTONE
IS 28	IN
WINNALEAH	FRANKER
IN	IN
WINNALEAH	FRANKER
IS 28	IS

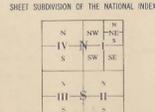

Magnetic Variation from True North for the centre of this sheet is approximately 12°48'E. 1965.

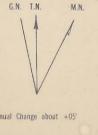

Crown Copyright Reserved