


SCALE 20 CHAINS TO 1 INCH



0451-001

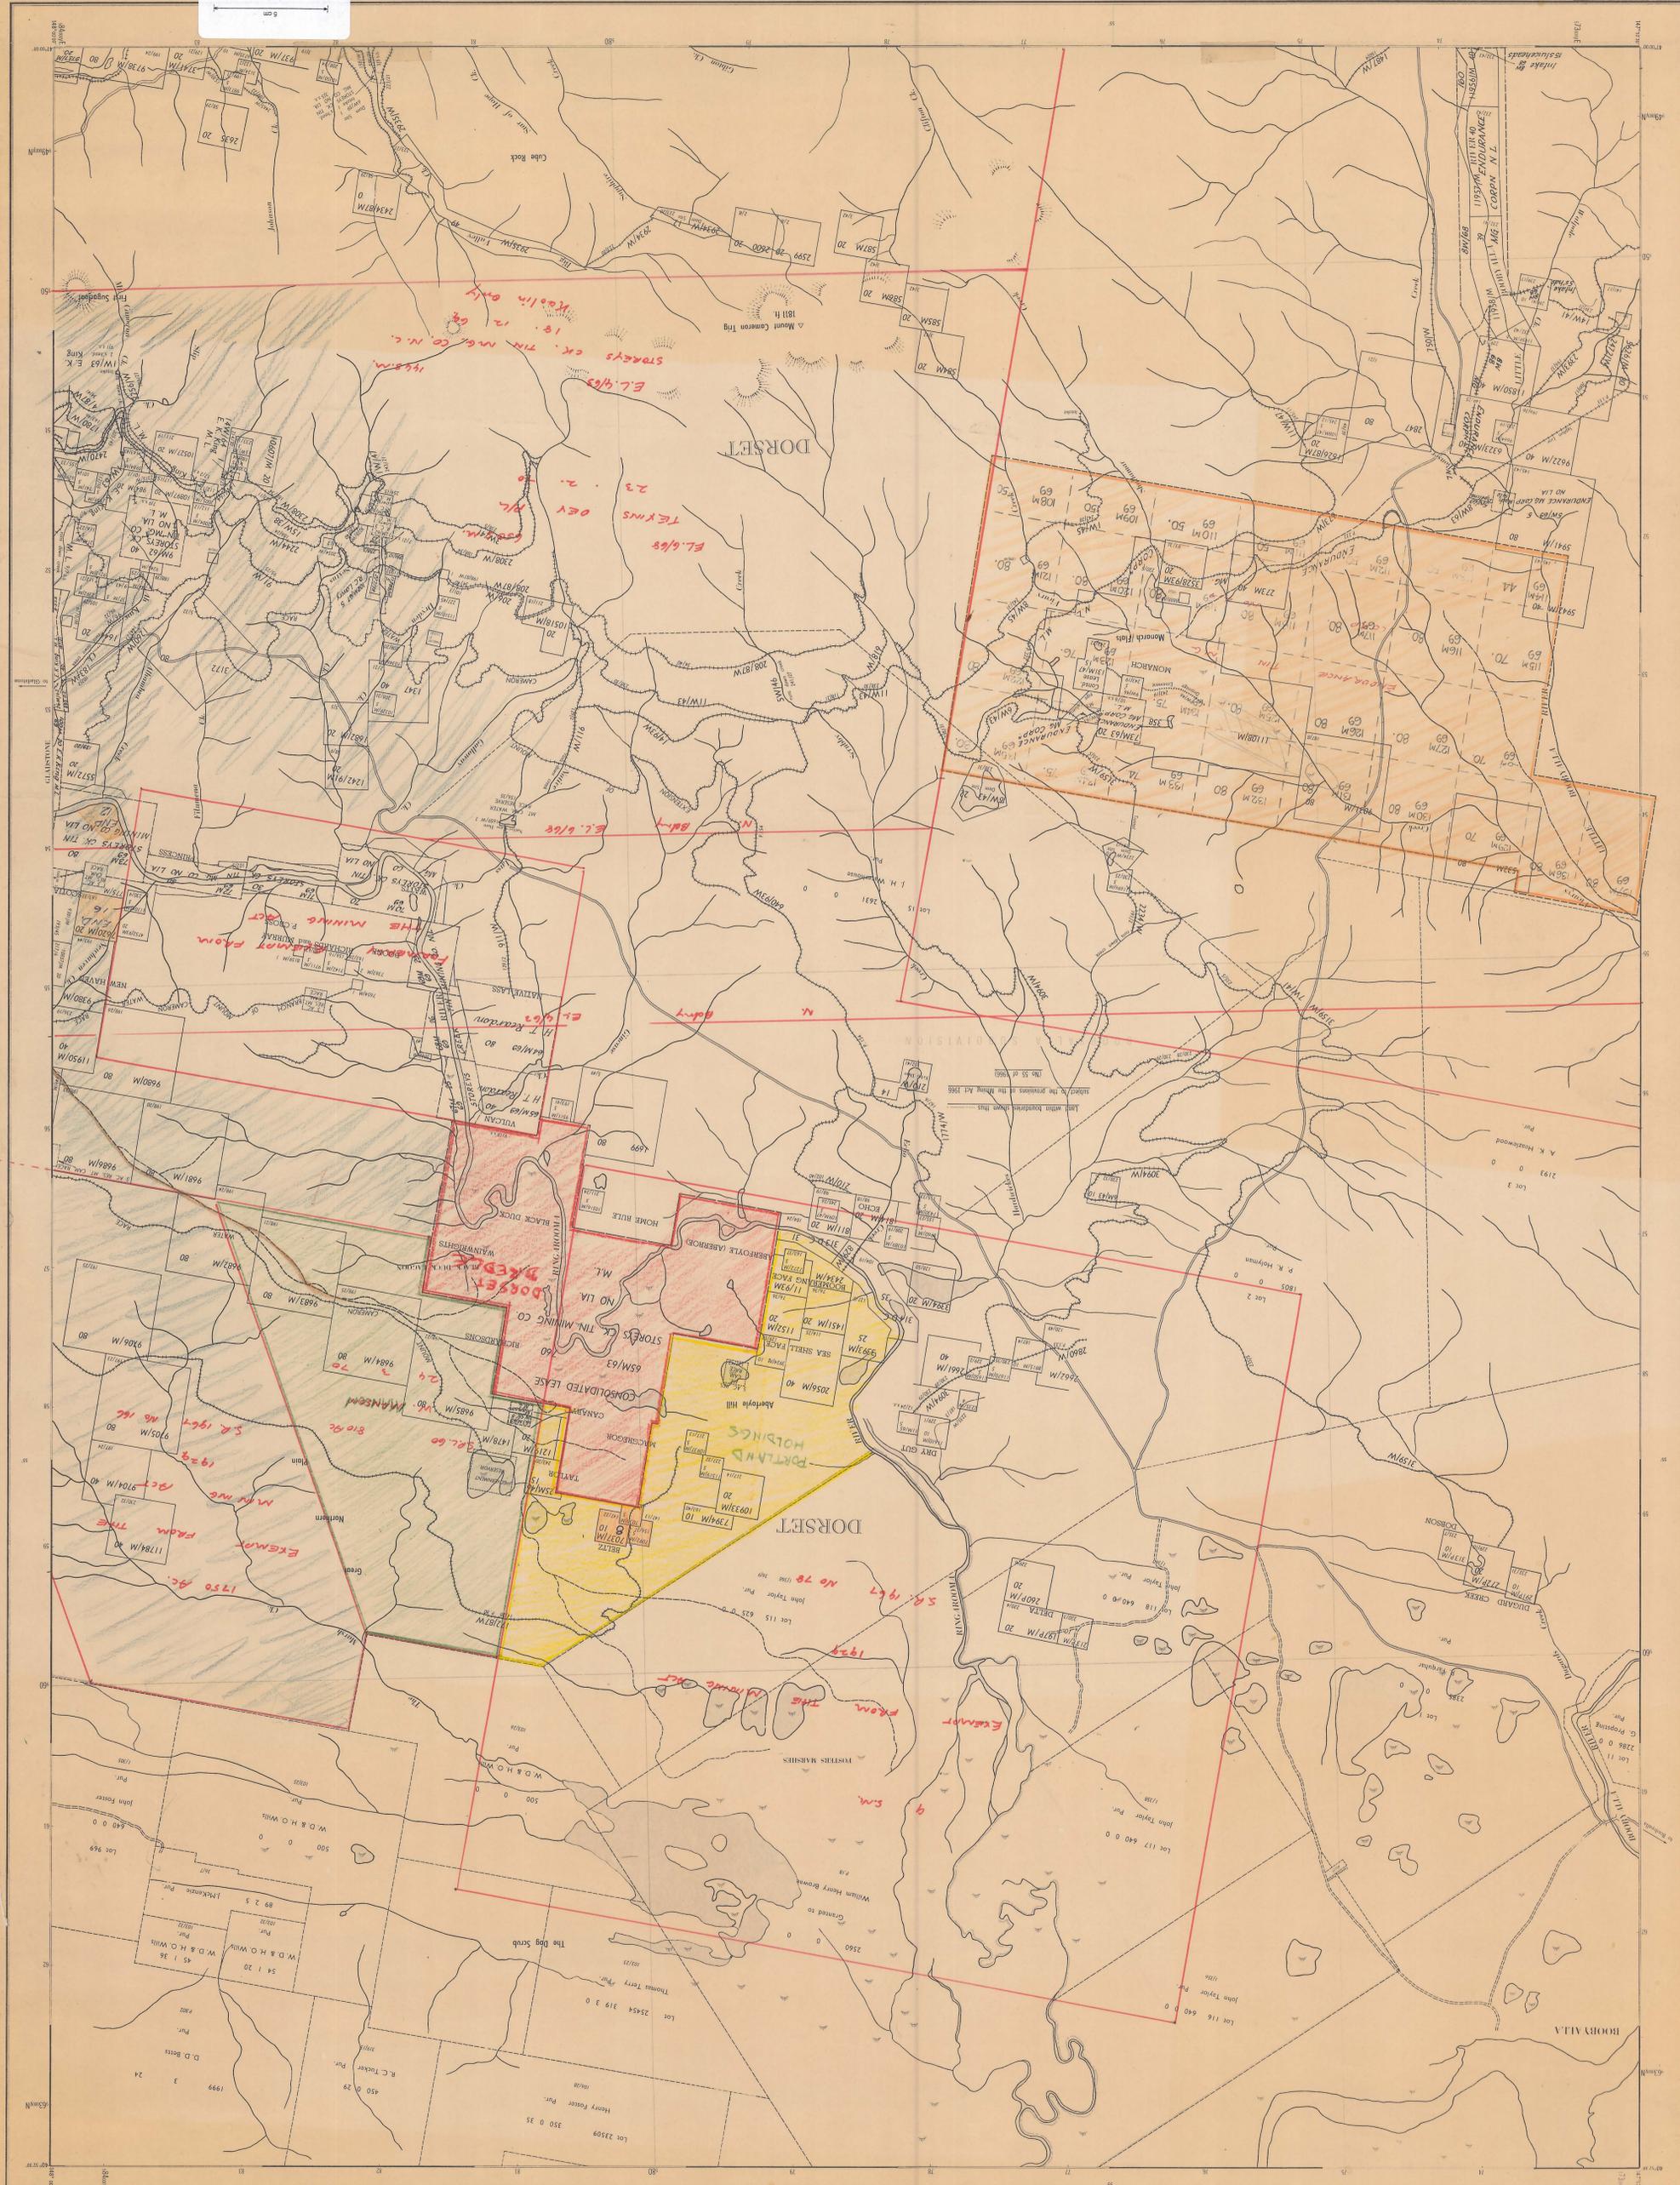

17/12/70

0451-001