


MINERAL CHART TOMAHAWK 2 SOUTH

SHEET No. 8416-H-SE-5

0451-002

13/1/1978

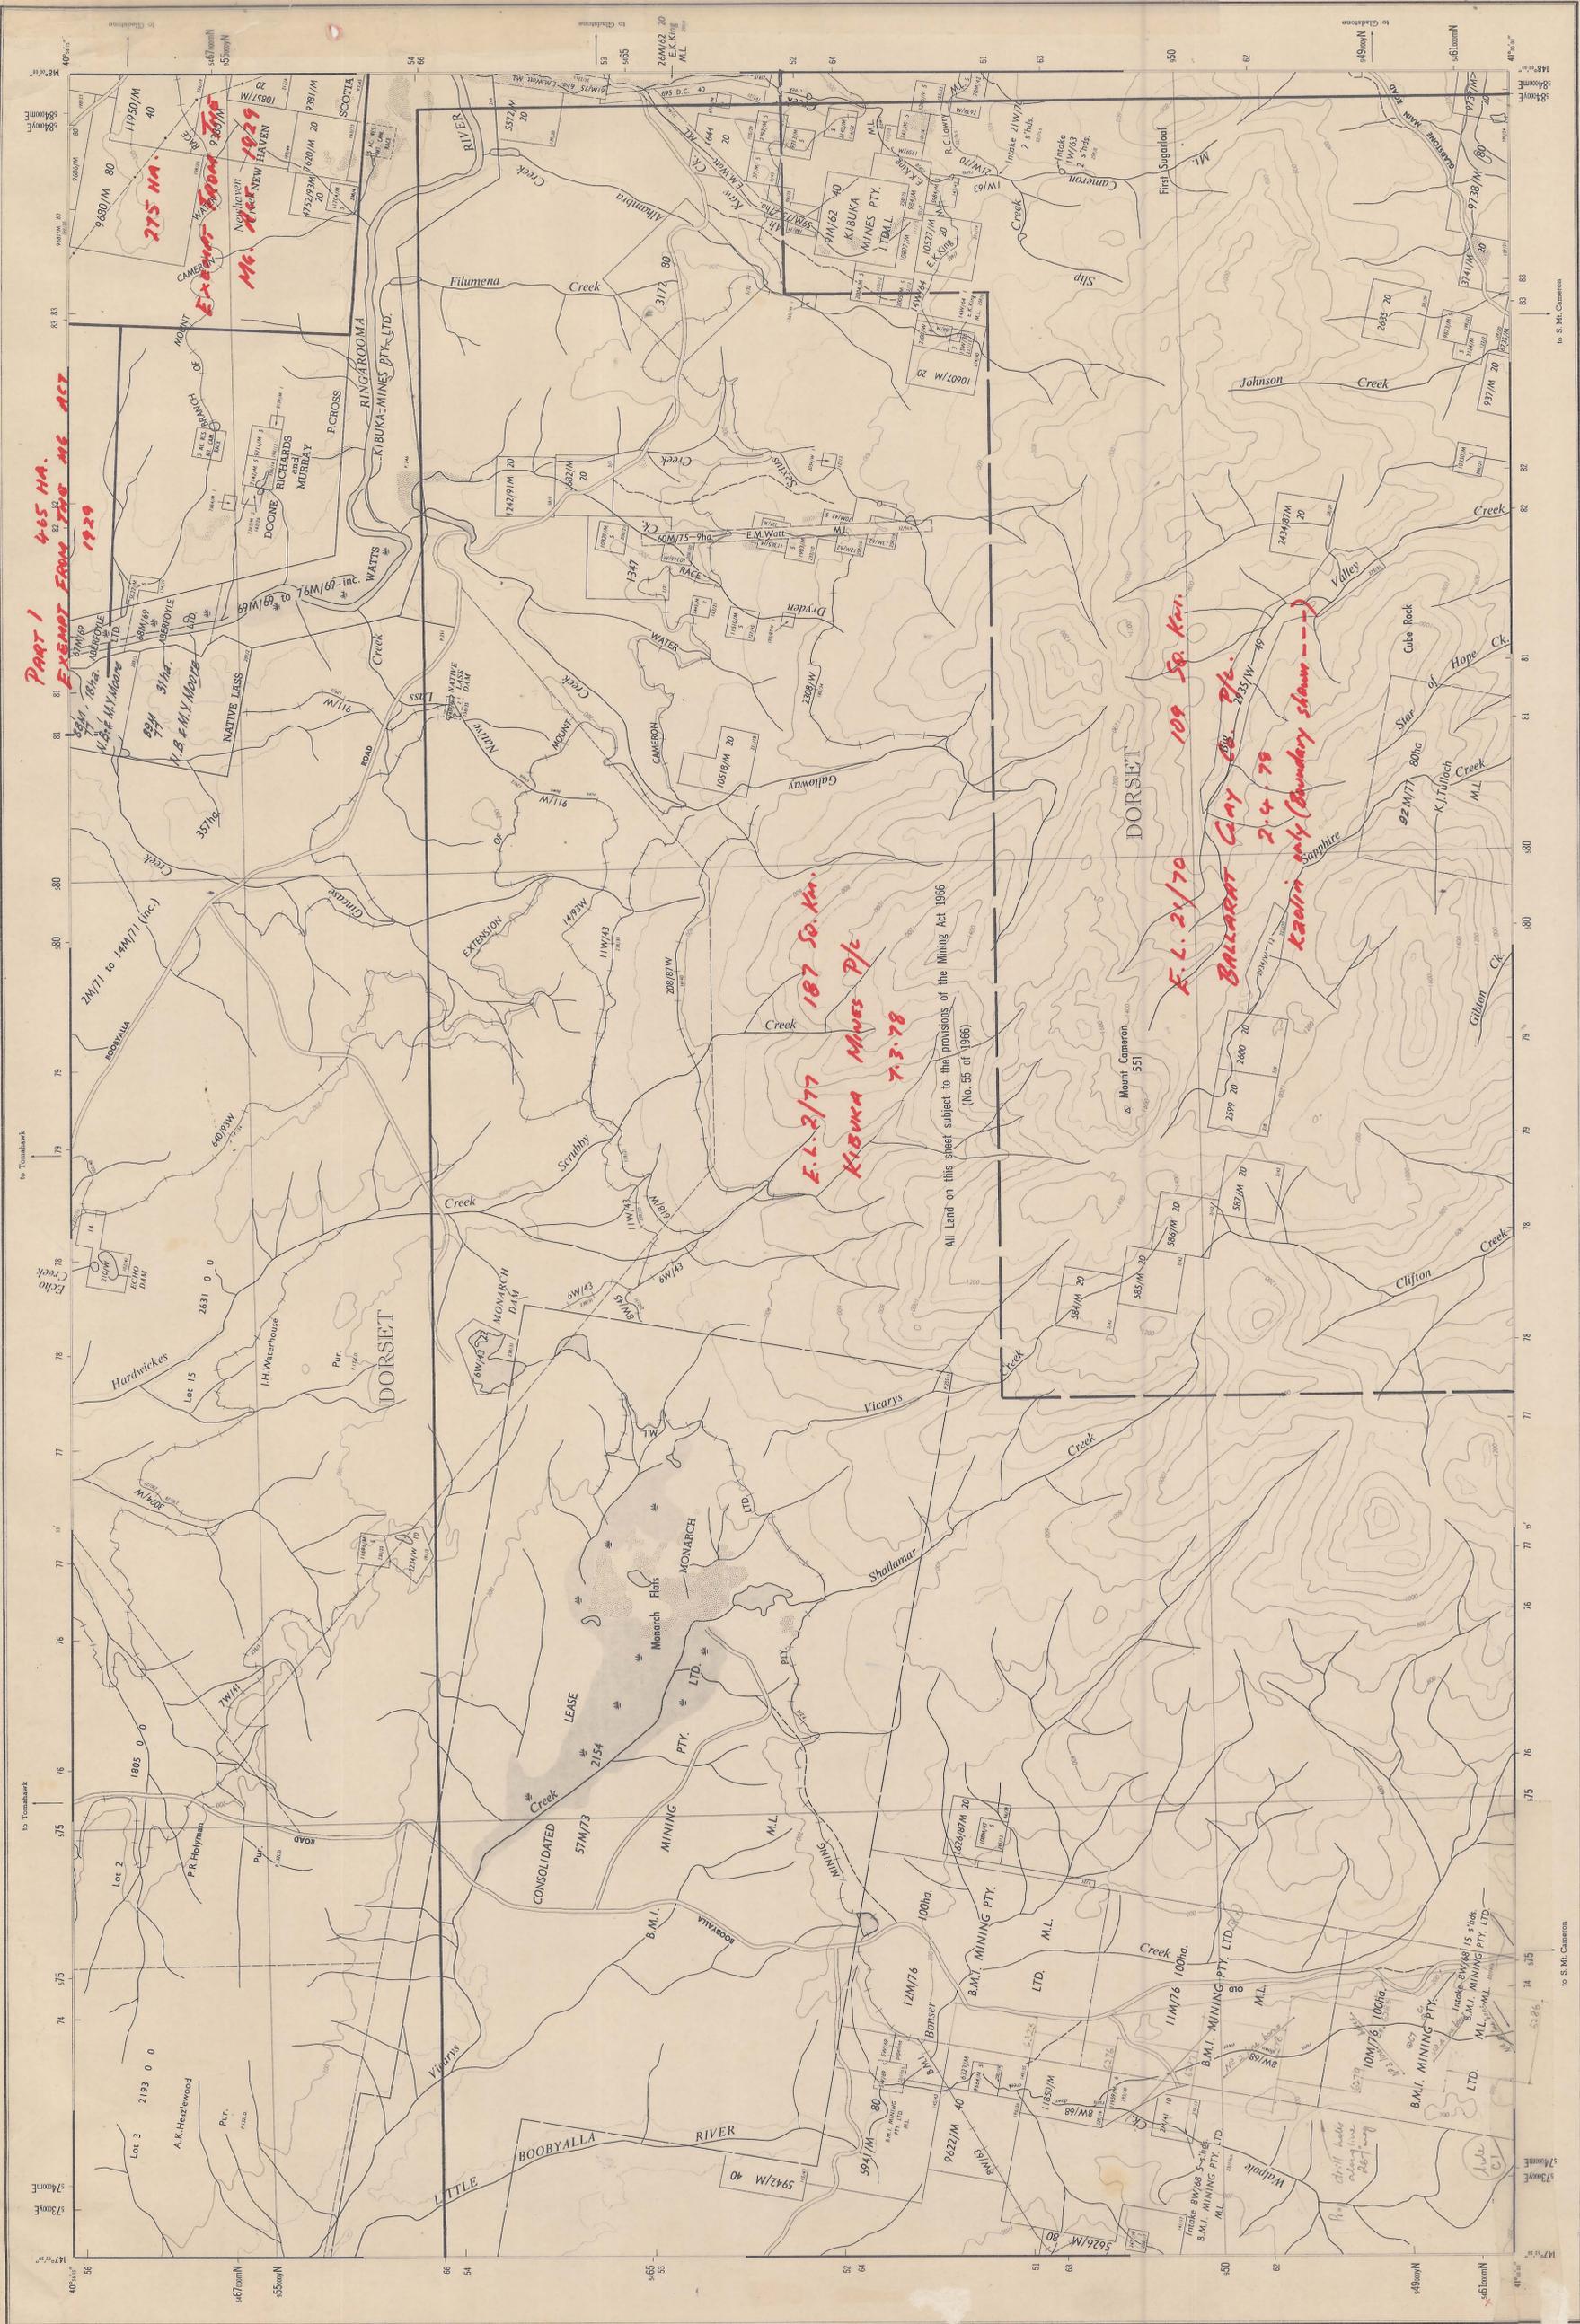

0451-002

5 cm

1:25,000

0 100 200 300 400 500 600 700 800 900 1000 1500 2000 2500 3000 METERS

0 100 200 300 400 500 600 700 800 900 1000 1500 2000 2500 3000 METERS

INDEX TO MINING SHEETS


SCALE: 20 CHAINS TO 1 INCH  
CONTOUR INTERVAL 100 FEET

EXTERNAL MARGIN DIMS ARE 1000 METRE INTERVALS OF THE AUSTRALIAN MAP GRID ZONE 55  


The representation of a boundary or other cadastral information on this map does not constitute evidence of its existence or location  
The representation of a road or track on this map is an evidence of the existence of a right of way

PRODUCTION: In accordance with National Mapping Standards by  
DETAILS: Aerial Photography 1954  
PROJECTION: Universal Transverse Mercator  

13 JUN 1978  
Crown Copyright Reserved