LEGEND

- Topsoil.
- Fine grained quartz sand and drift.
- Course grained quartz drift.
- Clayey sand.
- Clay.
- Siltstone.
- Carbonaceous siltstone.
- Wash.
- Granite.
- M — Mathinna group — shale, sandstone, very fine sandstone meta — sediments.

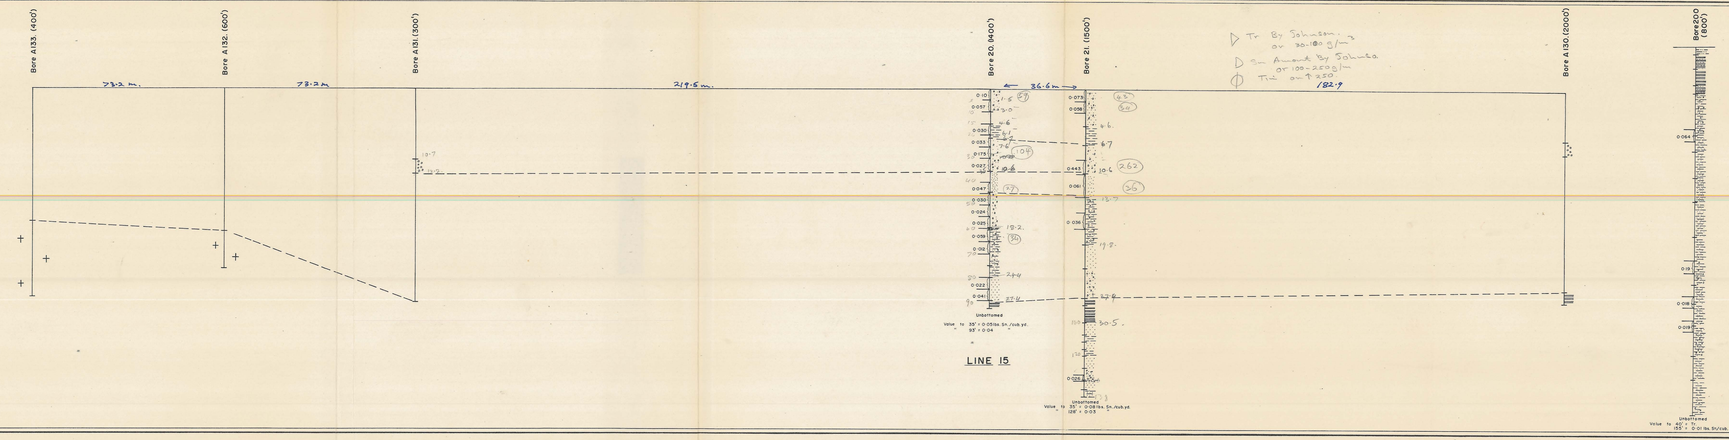

UTAH DEVELOPMENT COMPANY

LITHOLOGIC SECTIONS & Sn. VALUE OF BOREHOLES IN THE ARBA AREA

TEST AREA No. I

VALUES QUOTED AS LBS. Sn/CUB. YD.

PLATE 5

SCALE Horiz. 1 inch = 50 feet. 1:600
Vert. 1 inch = 20 feet. 1:240

Drawn by B Wilson

Dec. 1965
Report No. 135

0655 - 011