


- \_\_\_\_\_ 2 ADIT
- \_\_\_\_\_ 1 LEVEL
- \_\_\_\_\_ 1 A LEVEL
- \_\_\_\_\_ 2 LEVEL
- \_\_\_\_\_ 3 LEVEL
- \_\_\_\_\_ 4 LEVEL
- \_\_\_\_\_ 5 LEVEL
- \_\_\_\_\_ 6 LEVEL
- \_\_\_\_\_ 7 LEVEL
- \_\_\_\_\_ 8 LEVEL
- \_\_\_\_\_ 9 LEVEL
- \_\_\_\_\_ 11 LEVEL

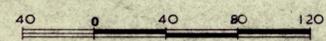

2400N

SURVEY - - //  
 GEOLOGY - - //  
 DRAWN - - //  
 TRACED - - //  
 DRAWING No. -