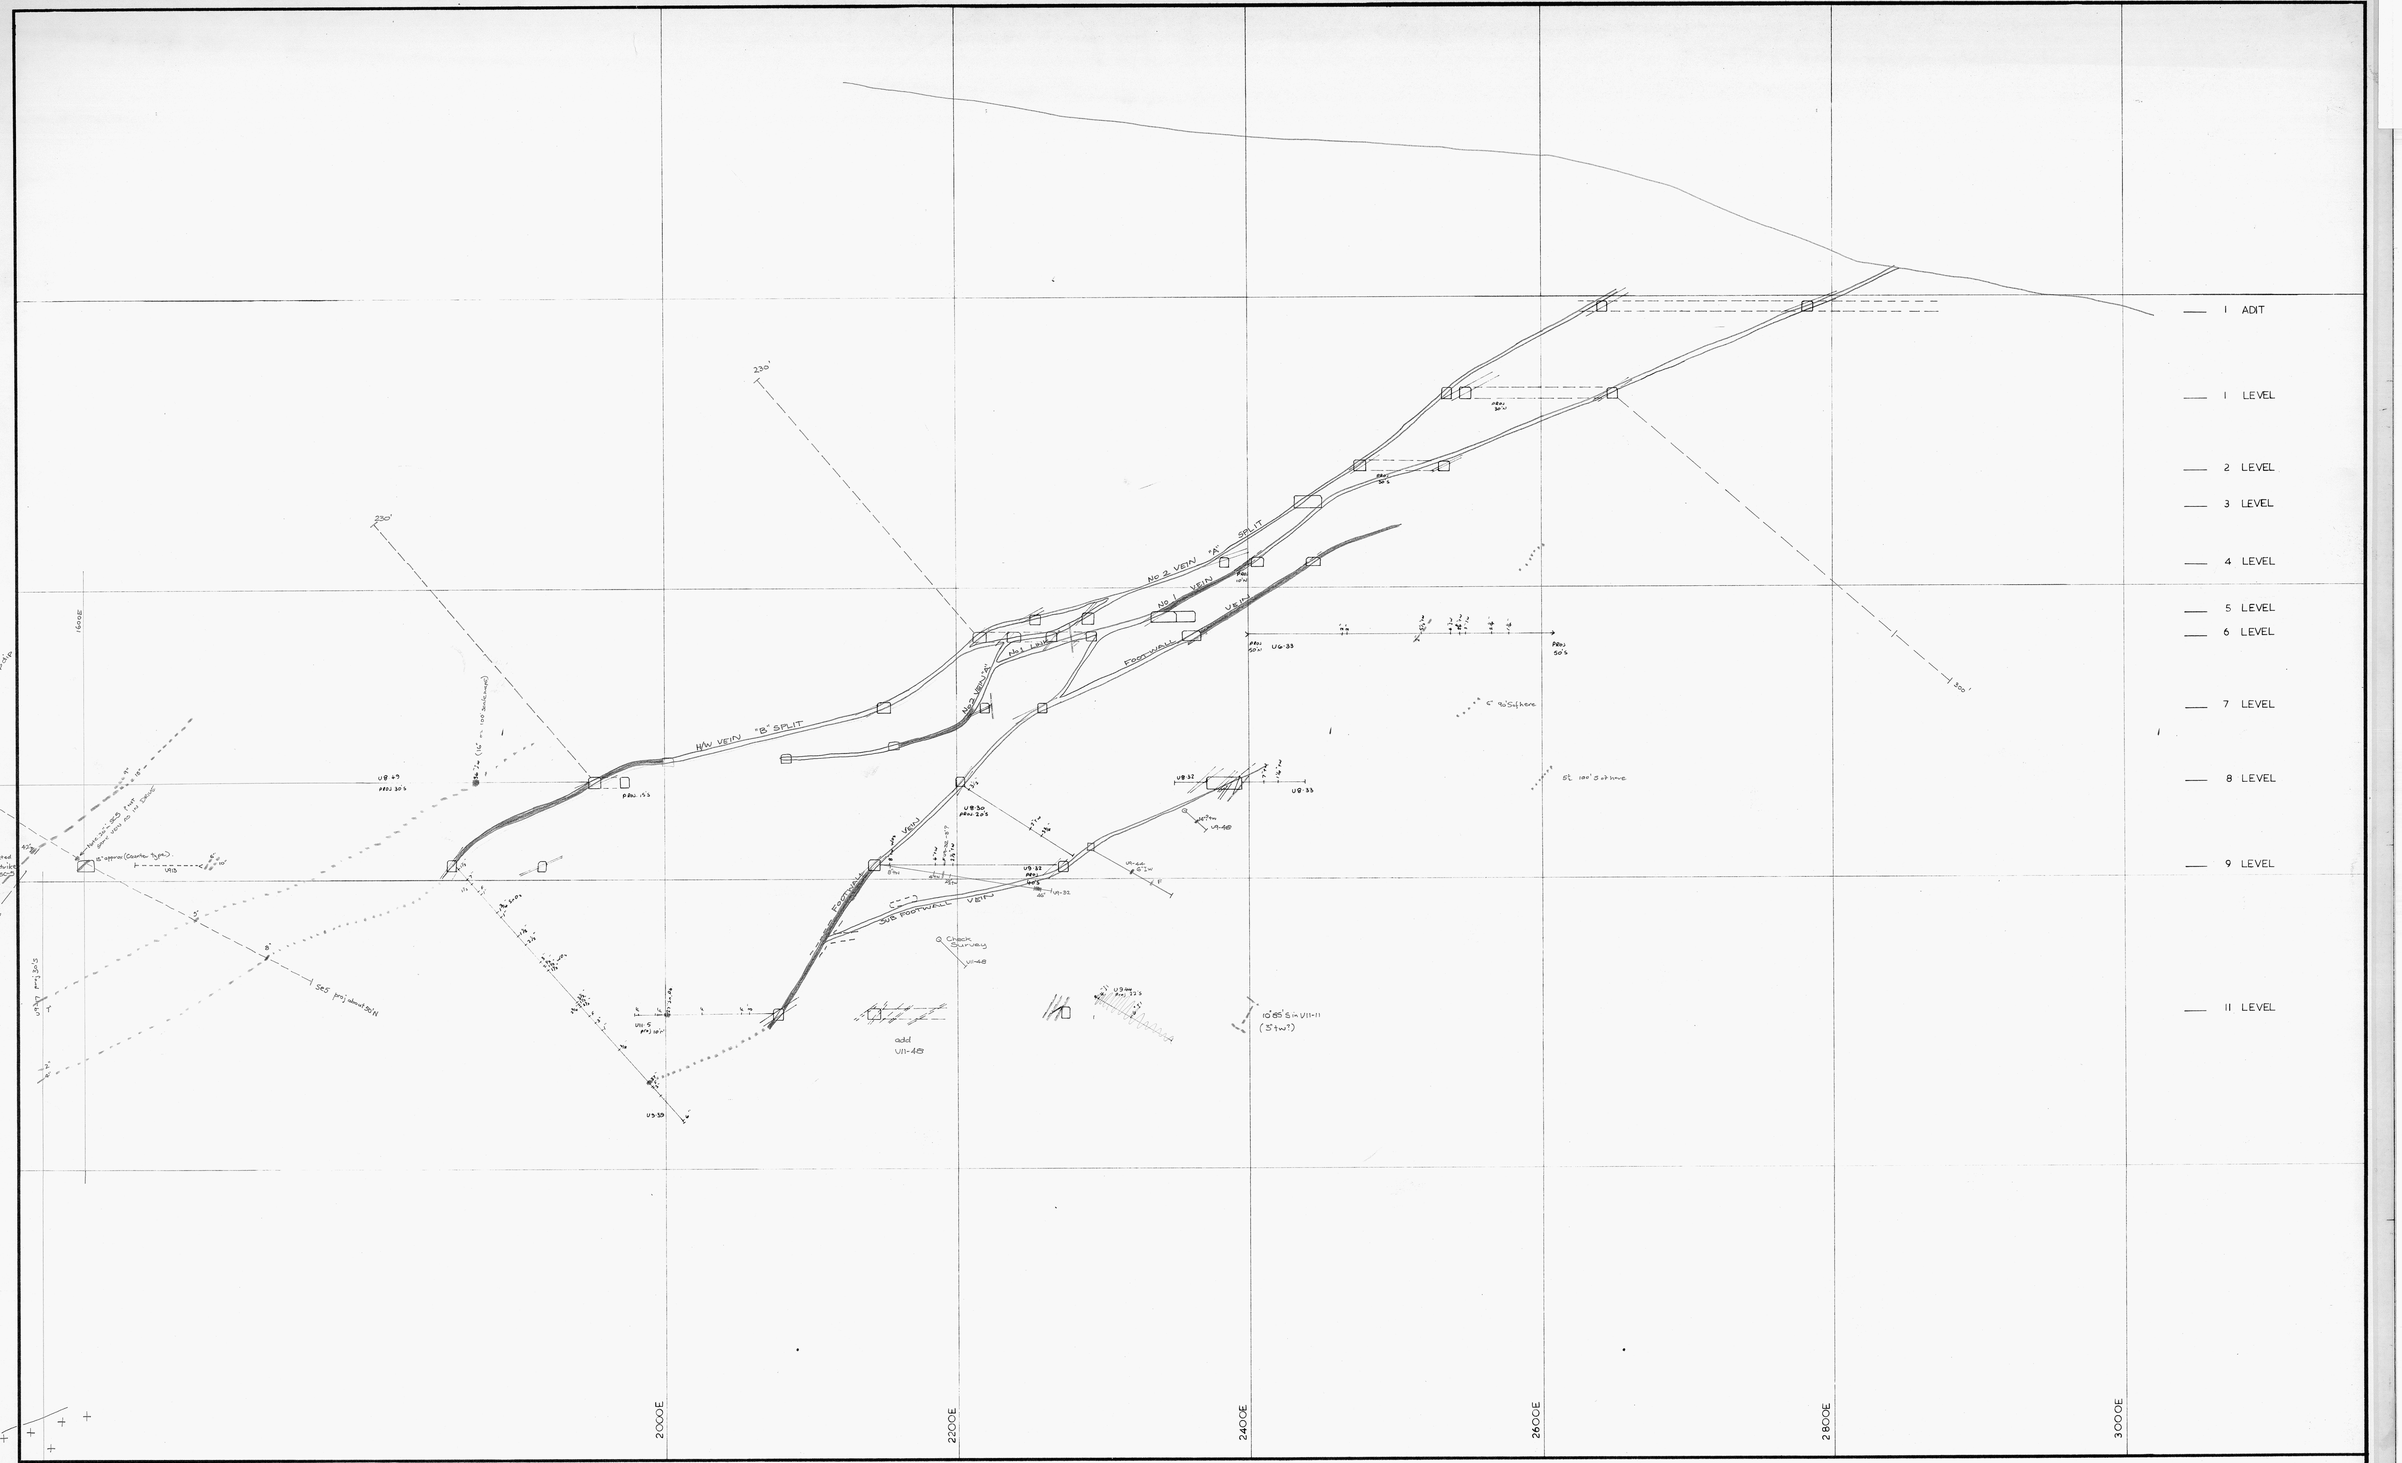

SURVEY –
GEOLOGY –
ENGINEERING –
DRAWN –
TRACED –
REFERENCE –
PRINT No. –

DRAWING No. –

DRAWER:

28